

600N

400N

200N


00

200S

400S

600S

314
-18

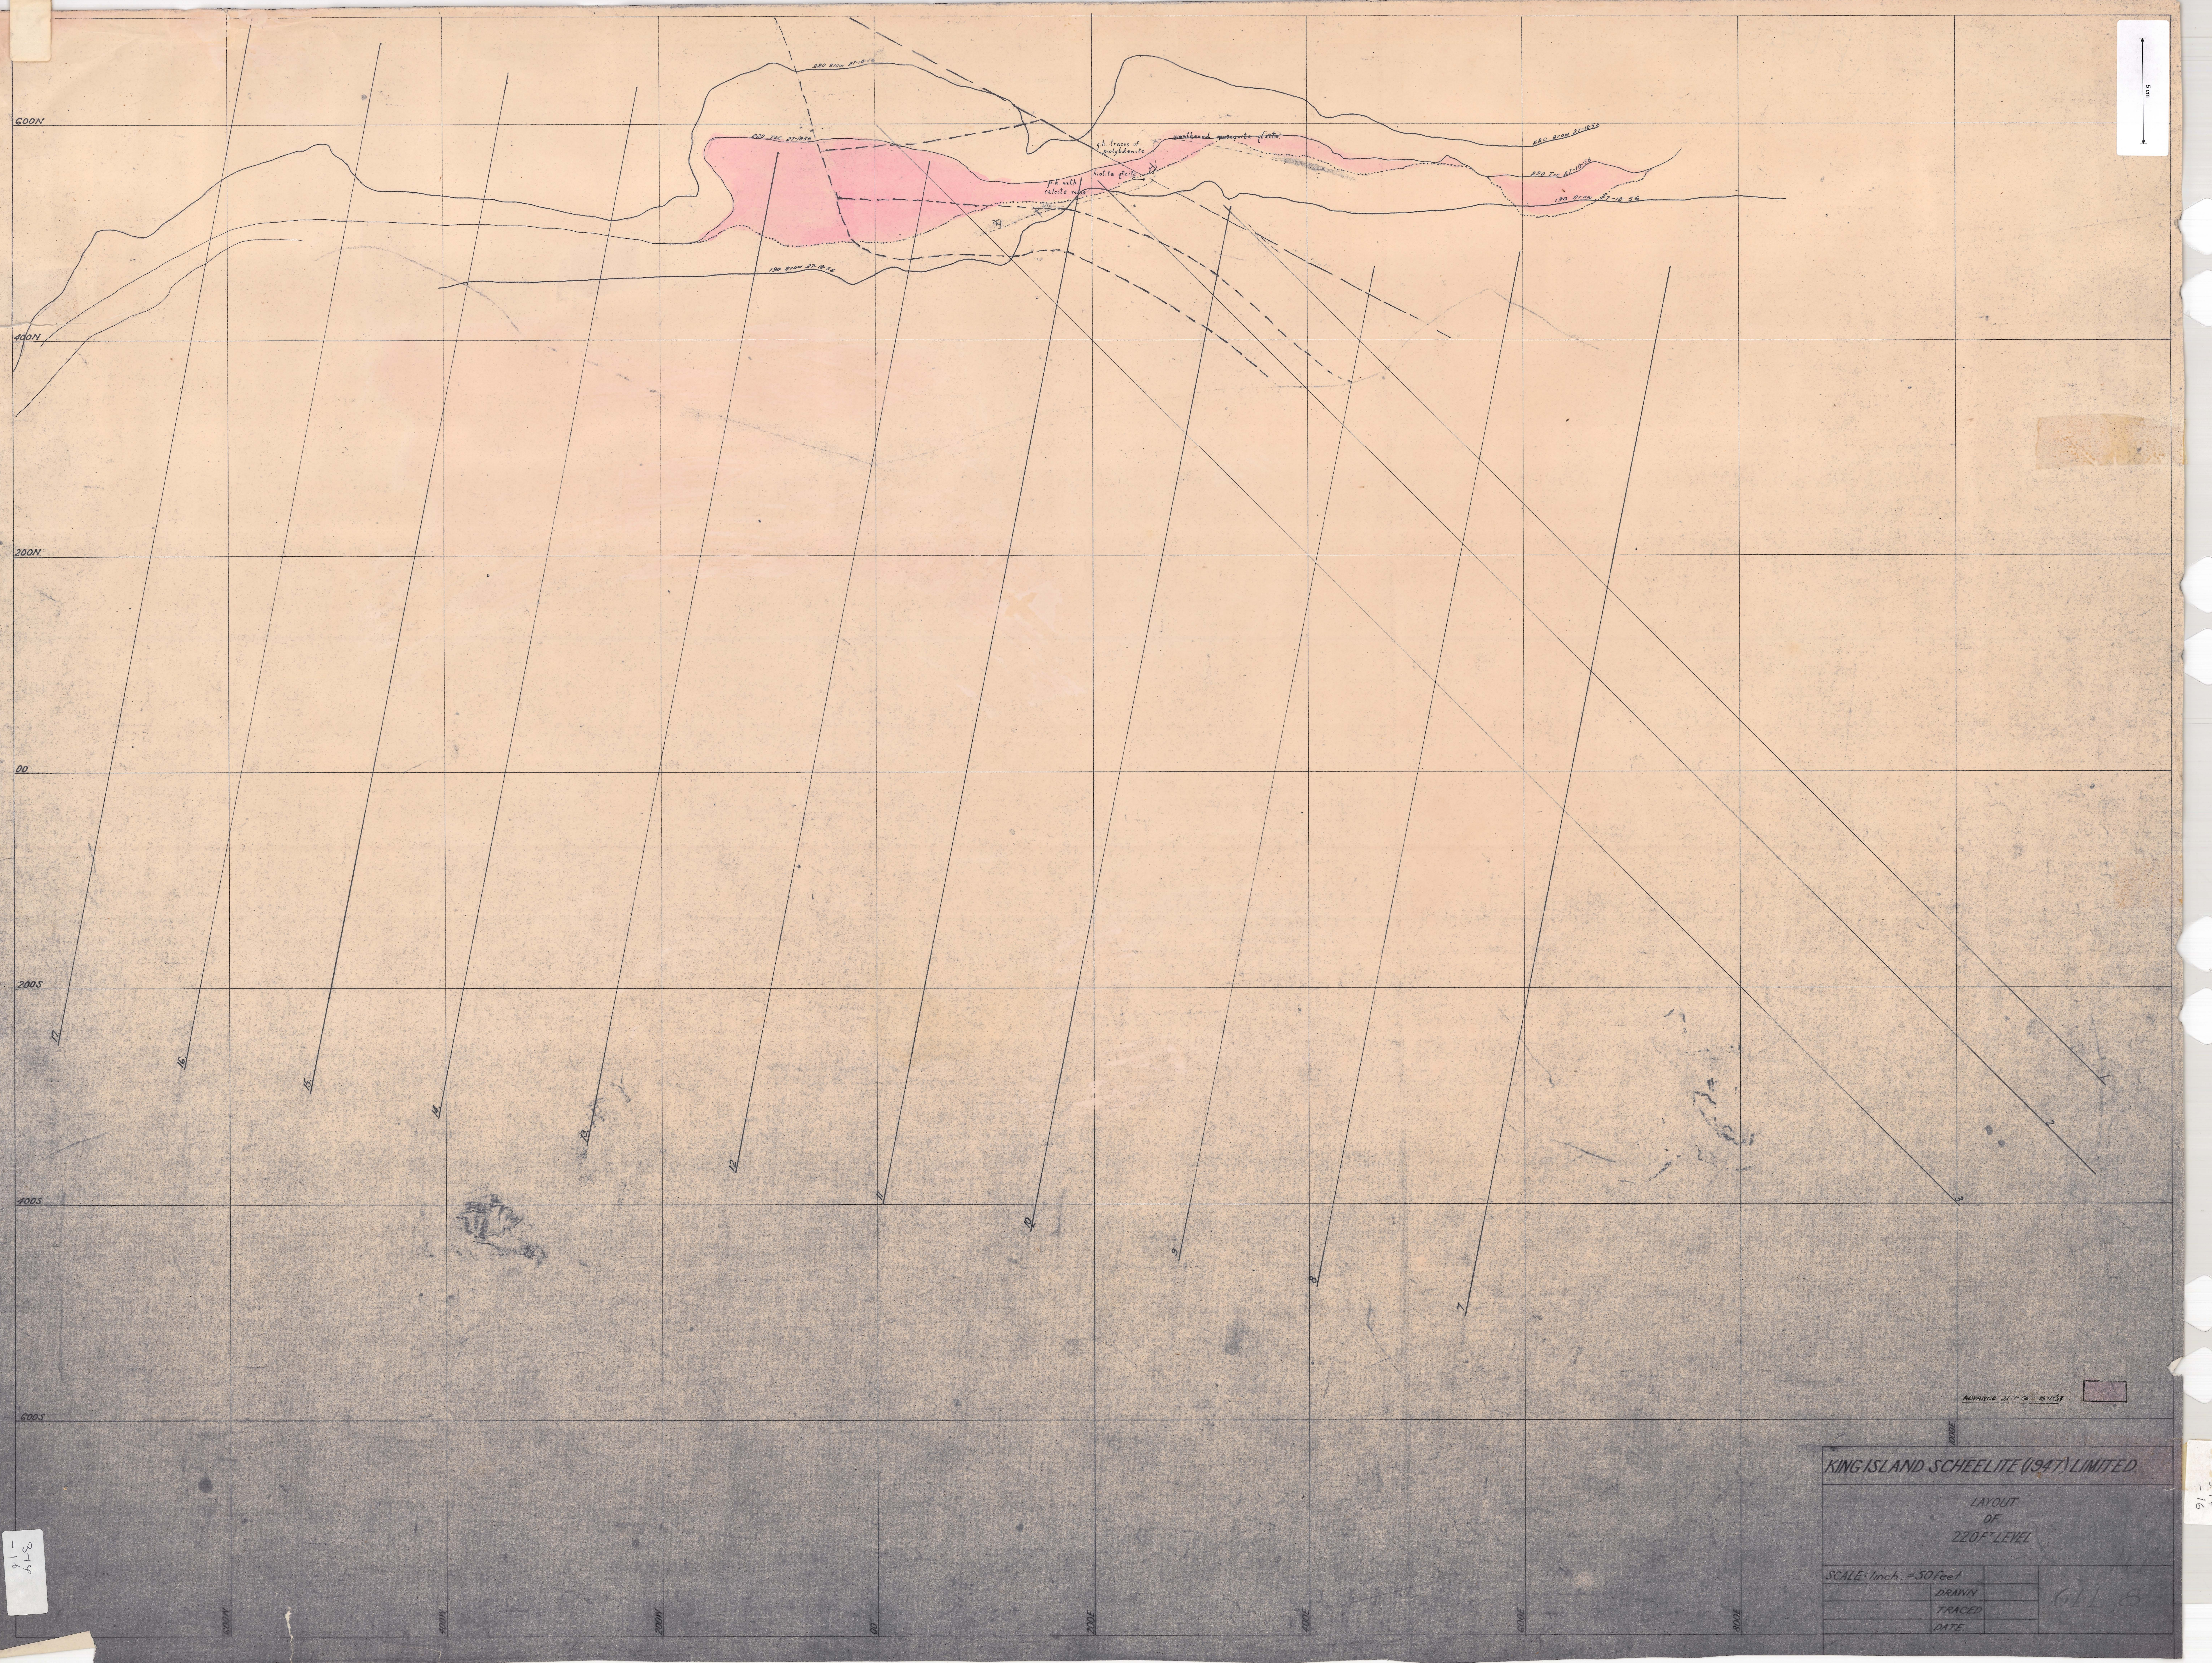

5 mi

KING ISLAND SCHEELITE (1947) LIMITED

LAYOUT
OF
220' LEVEL

SCALE: 1 inch = 50 feet	
DRAWN	
TRACED	
DATE	

6118

314
-16