


81
5 L2

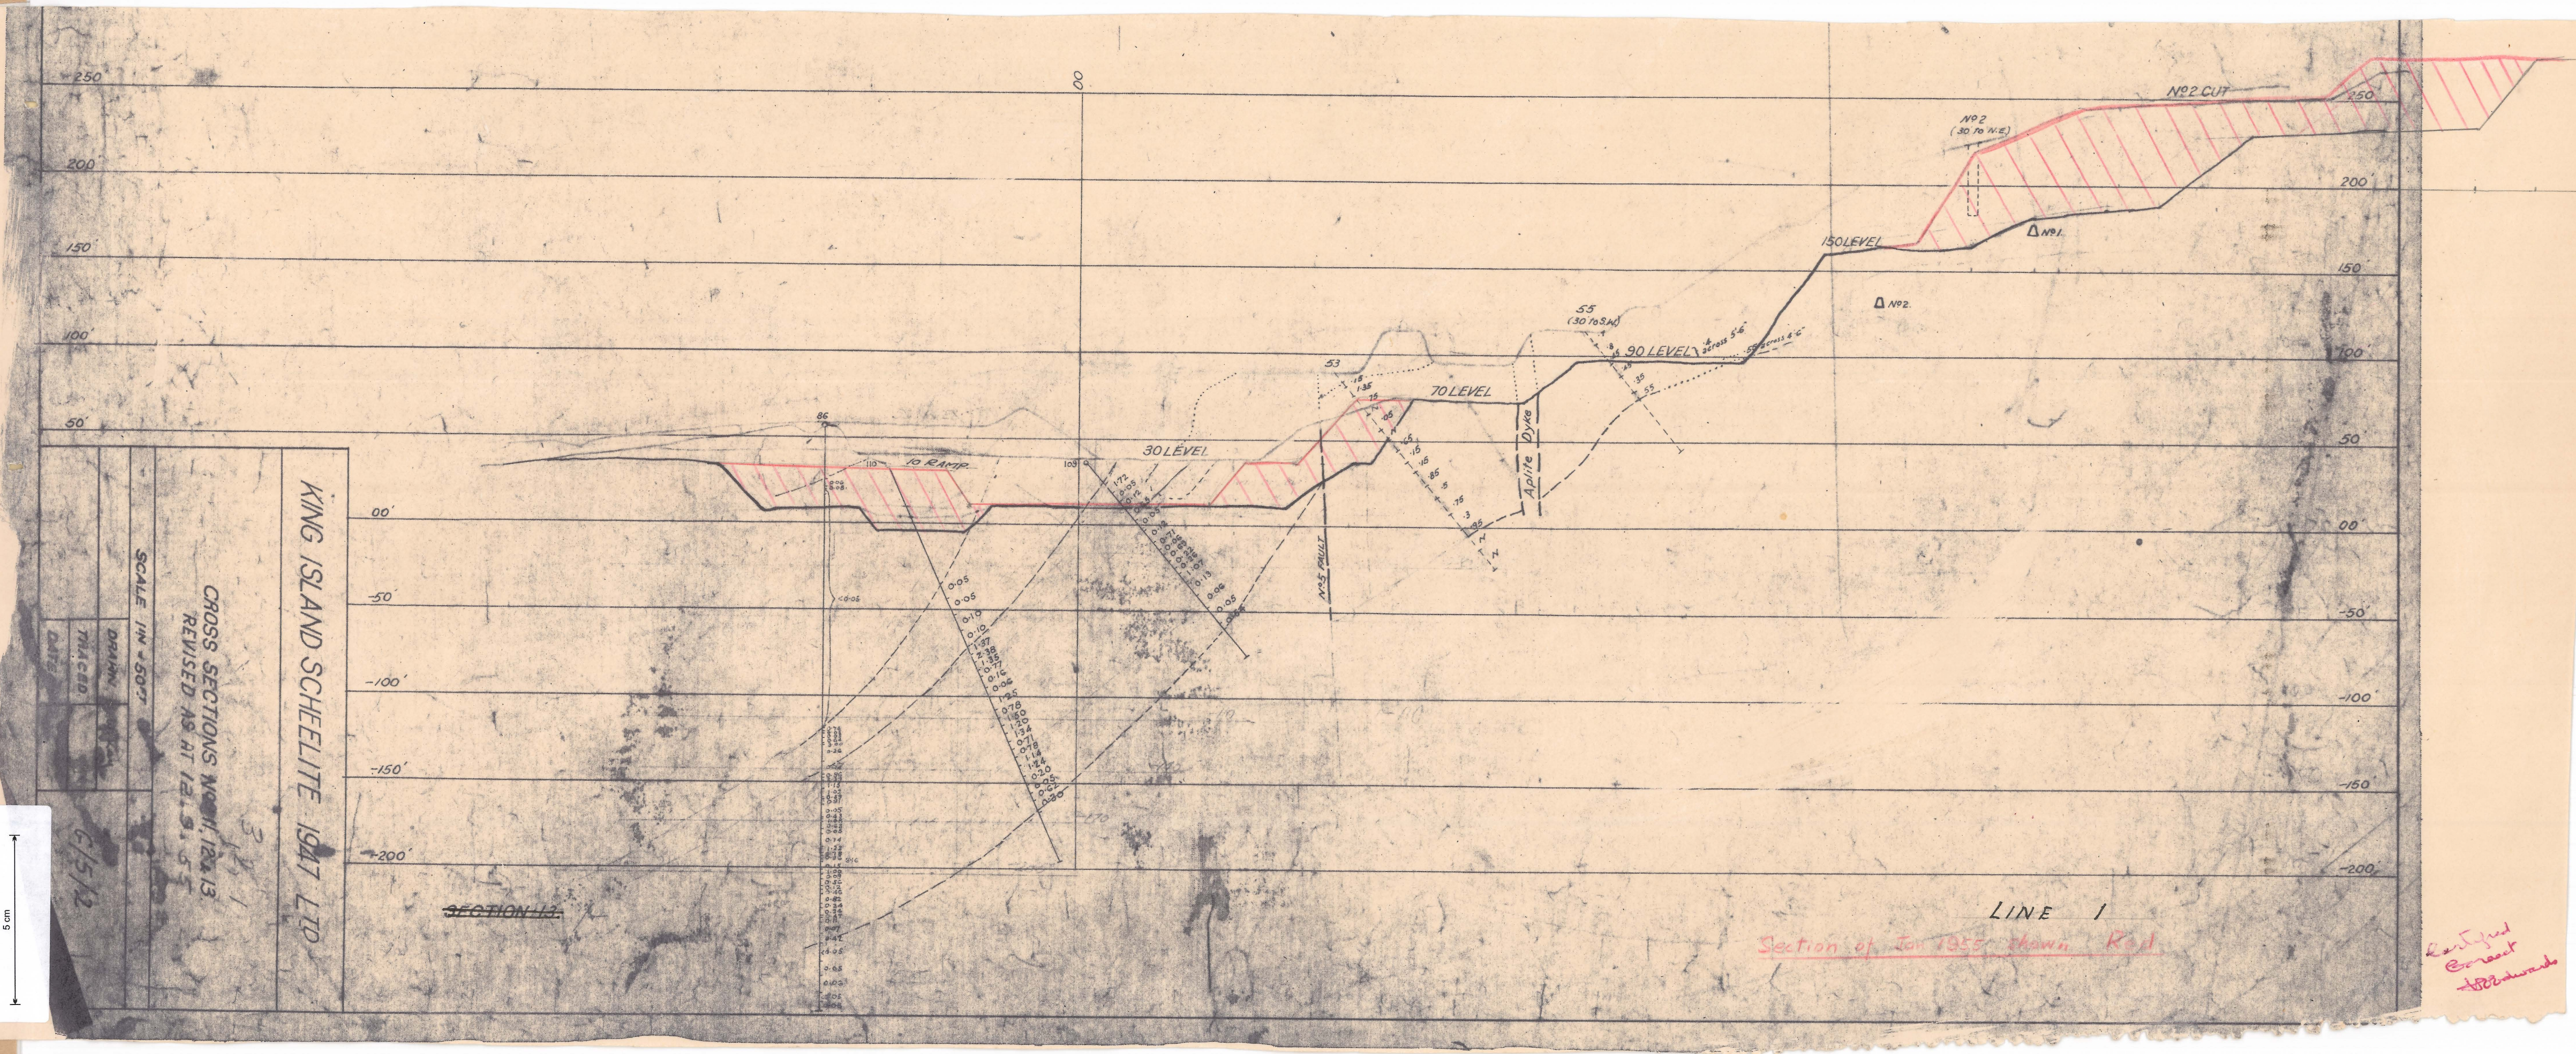

Revised
Corrections
12/12/55