


374-29

374-29

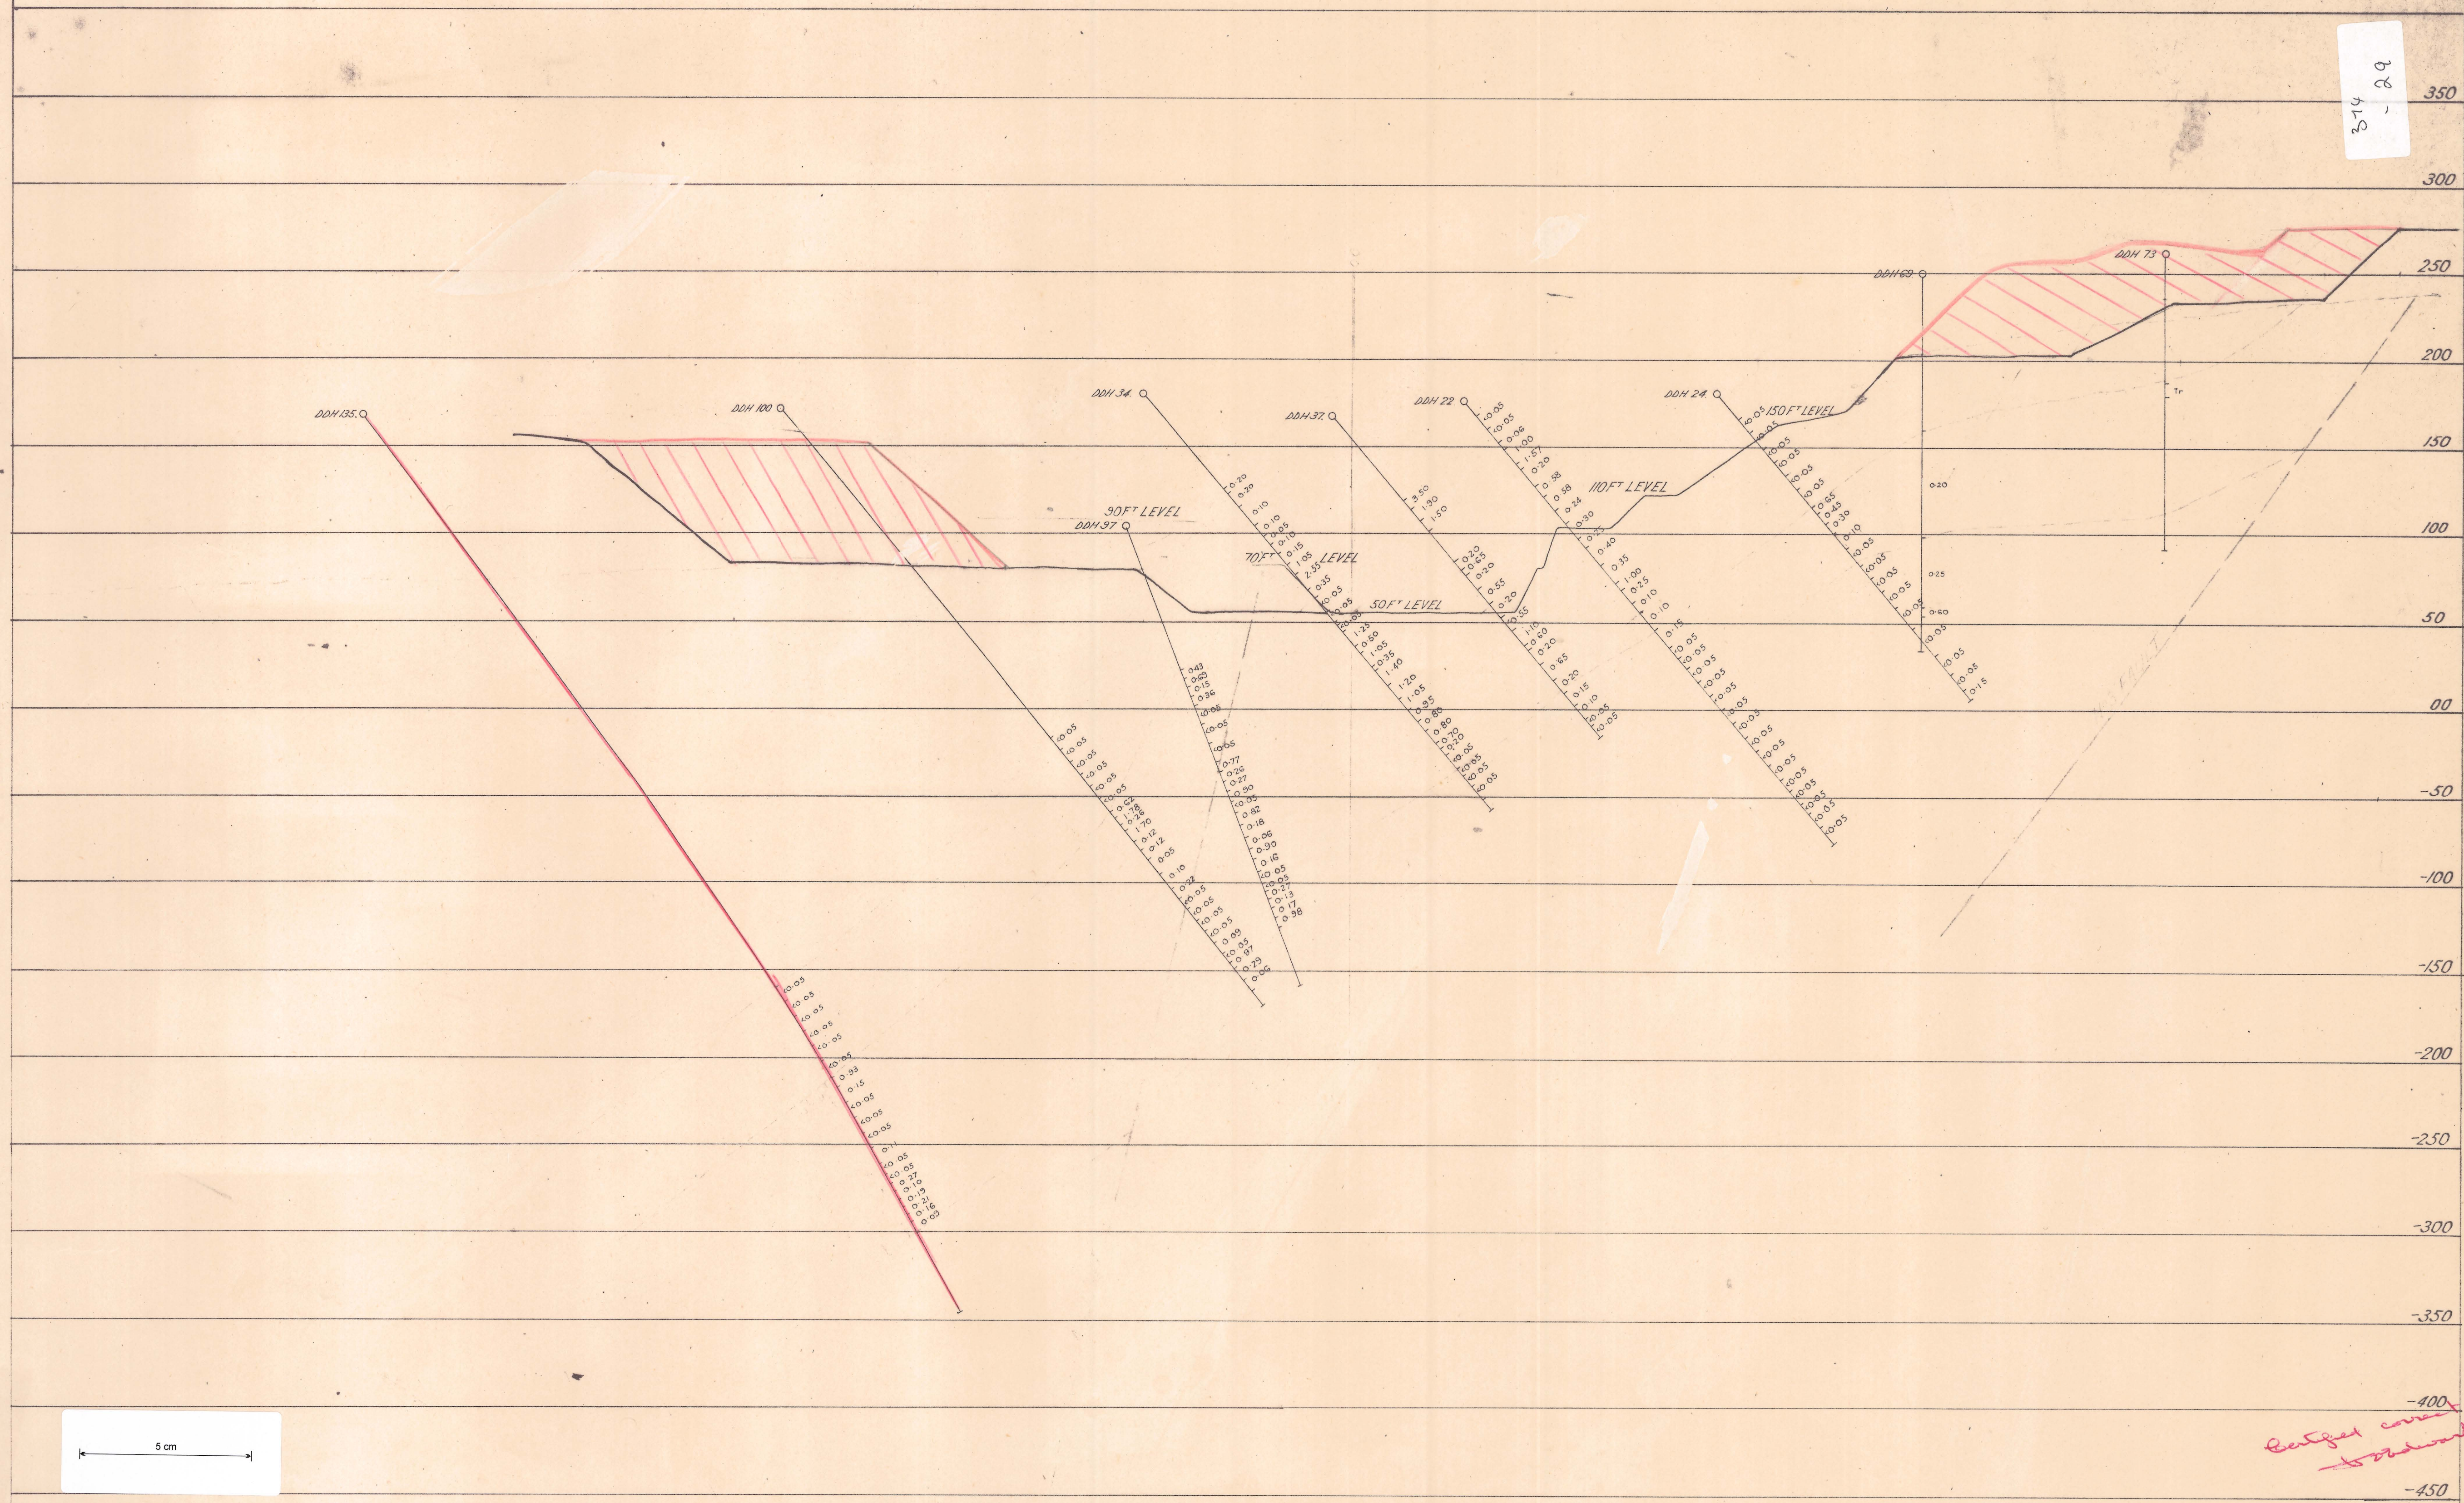

Get set corner
to road

LINE II.