


344  
-30

250'  
200'  
150'  
100'  
50'  
00'  
-50'  
-100'  
-150'  
-200'

LINE 15

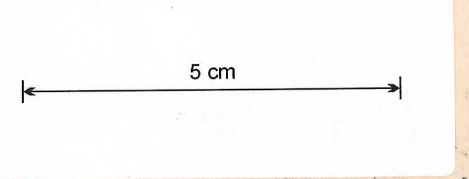

*Corrected work  
for errors*

SECTION. 15.

KING ISLAND SCHEELITE 1947 LTD

CROSS SECTIONS 5, 6 & 15.  
REVISED AT 12.9.55

SCALE 1" = 50 FT

|        |       |
|--------|-------|
| DRAWN  | W. B. |
| TRACED |       |
| DATE   |       |

344  
-30

