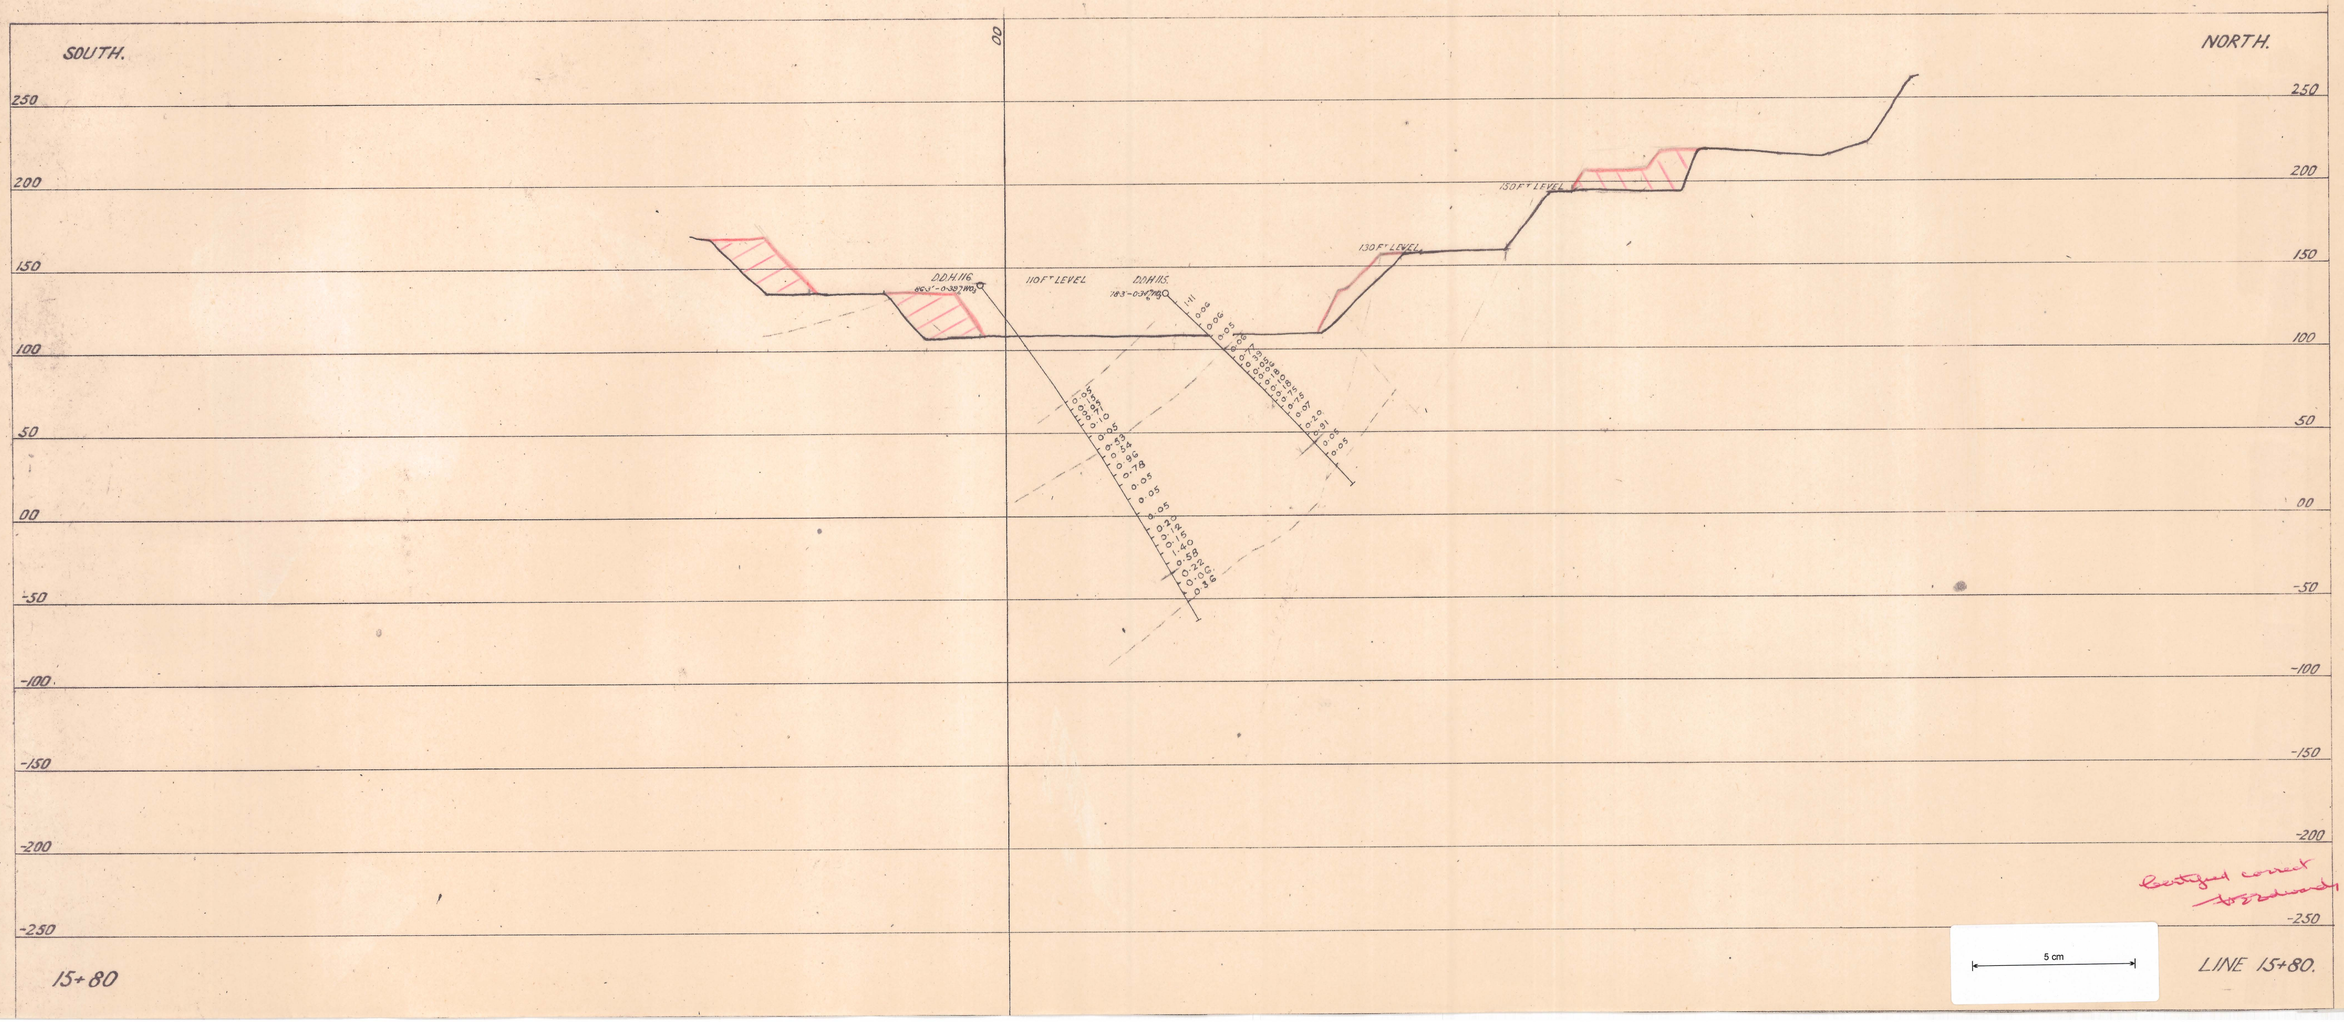

Corrected correct