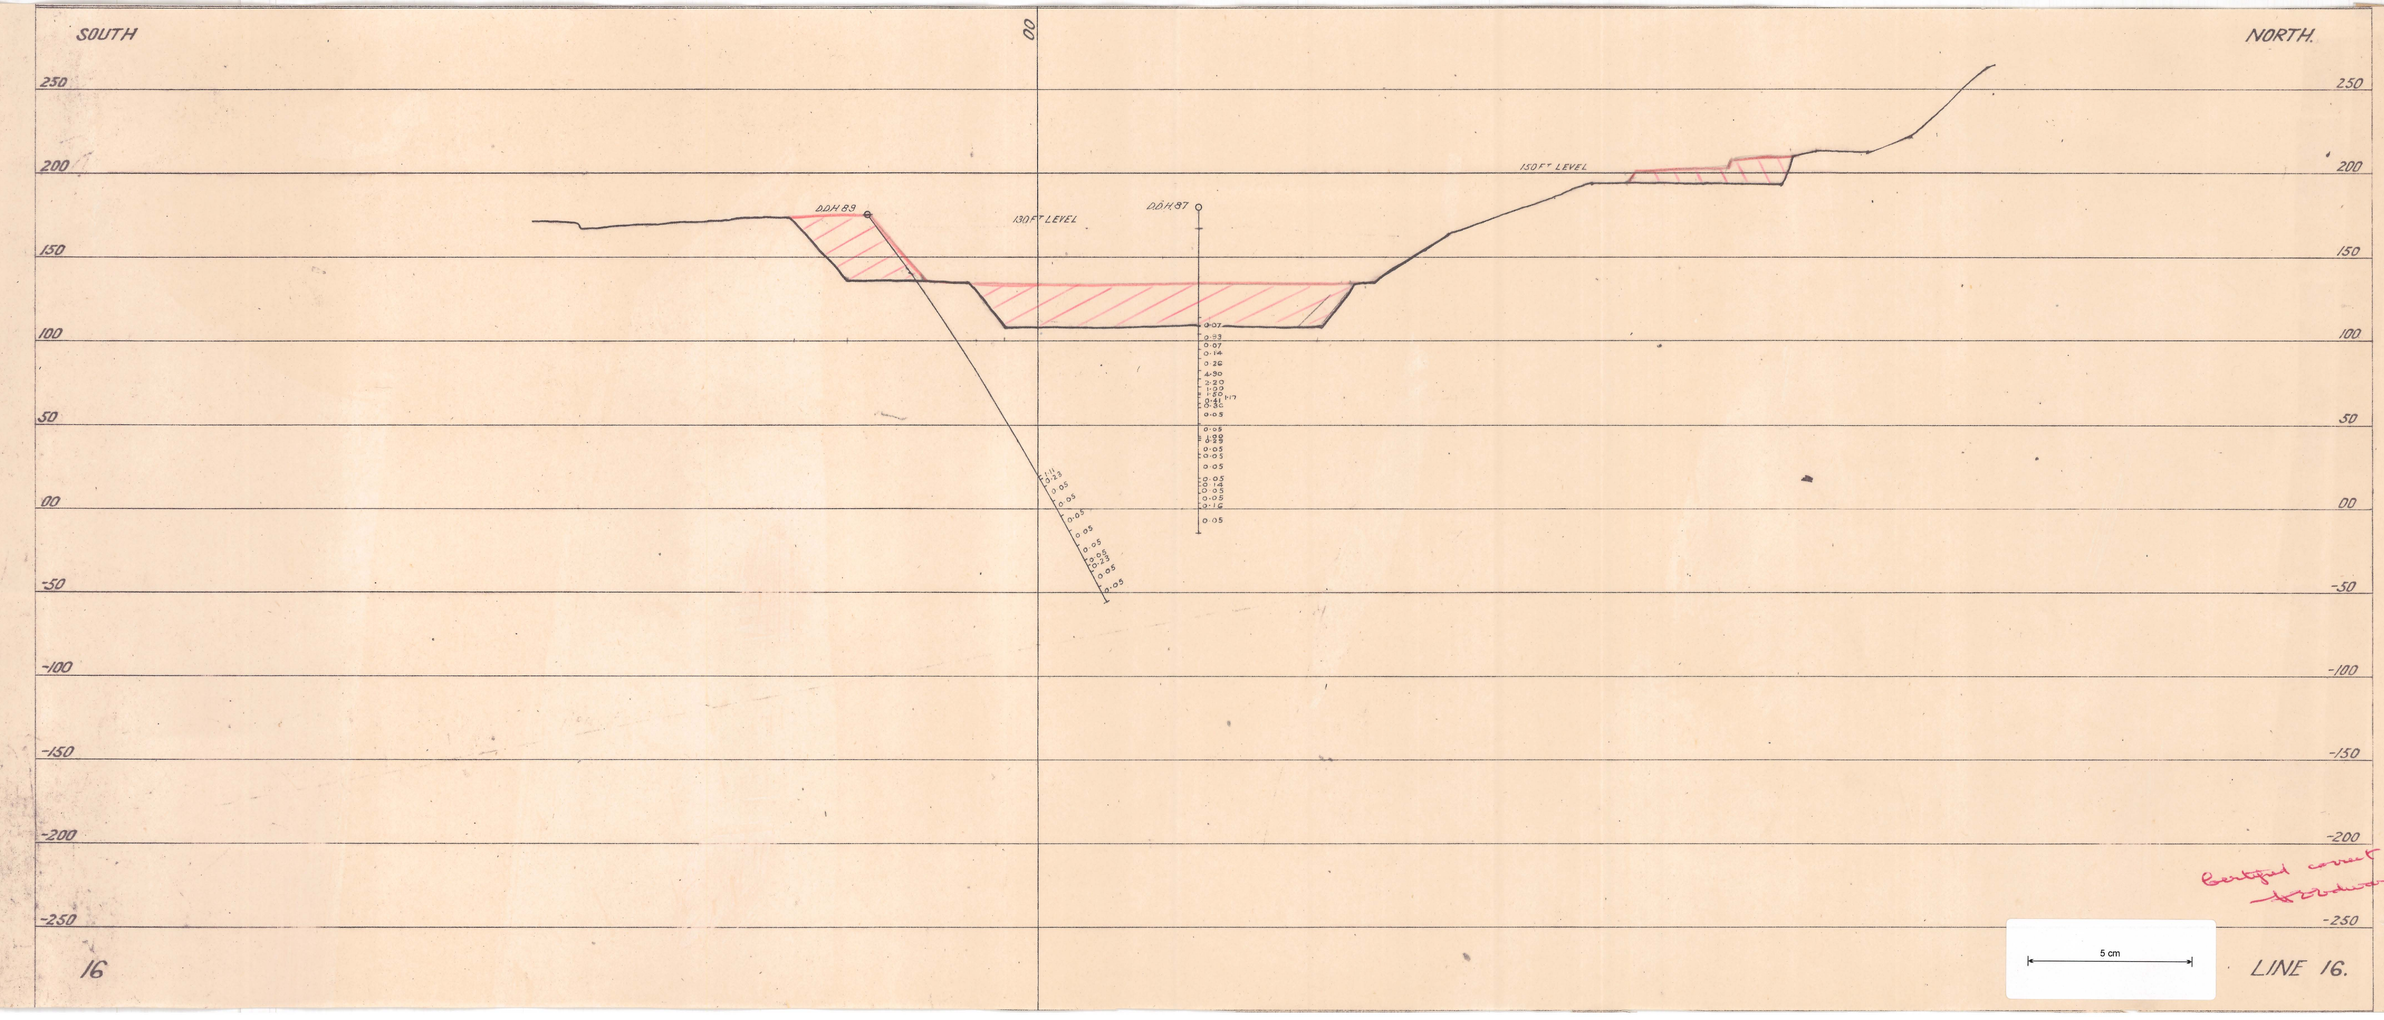

374-32

374-32

Contact count to Podwards