0374_088

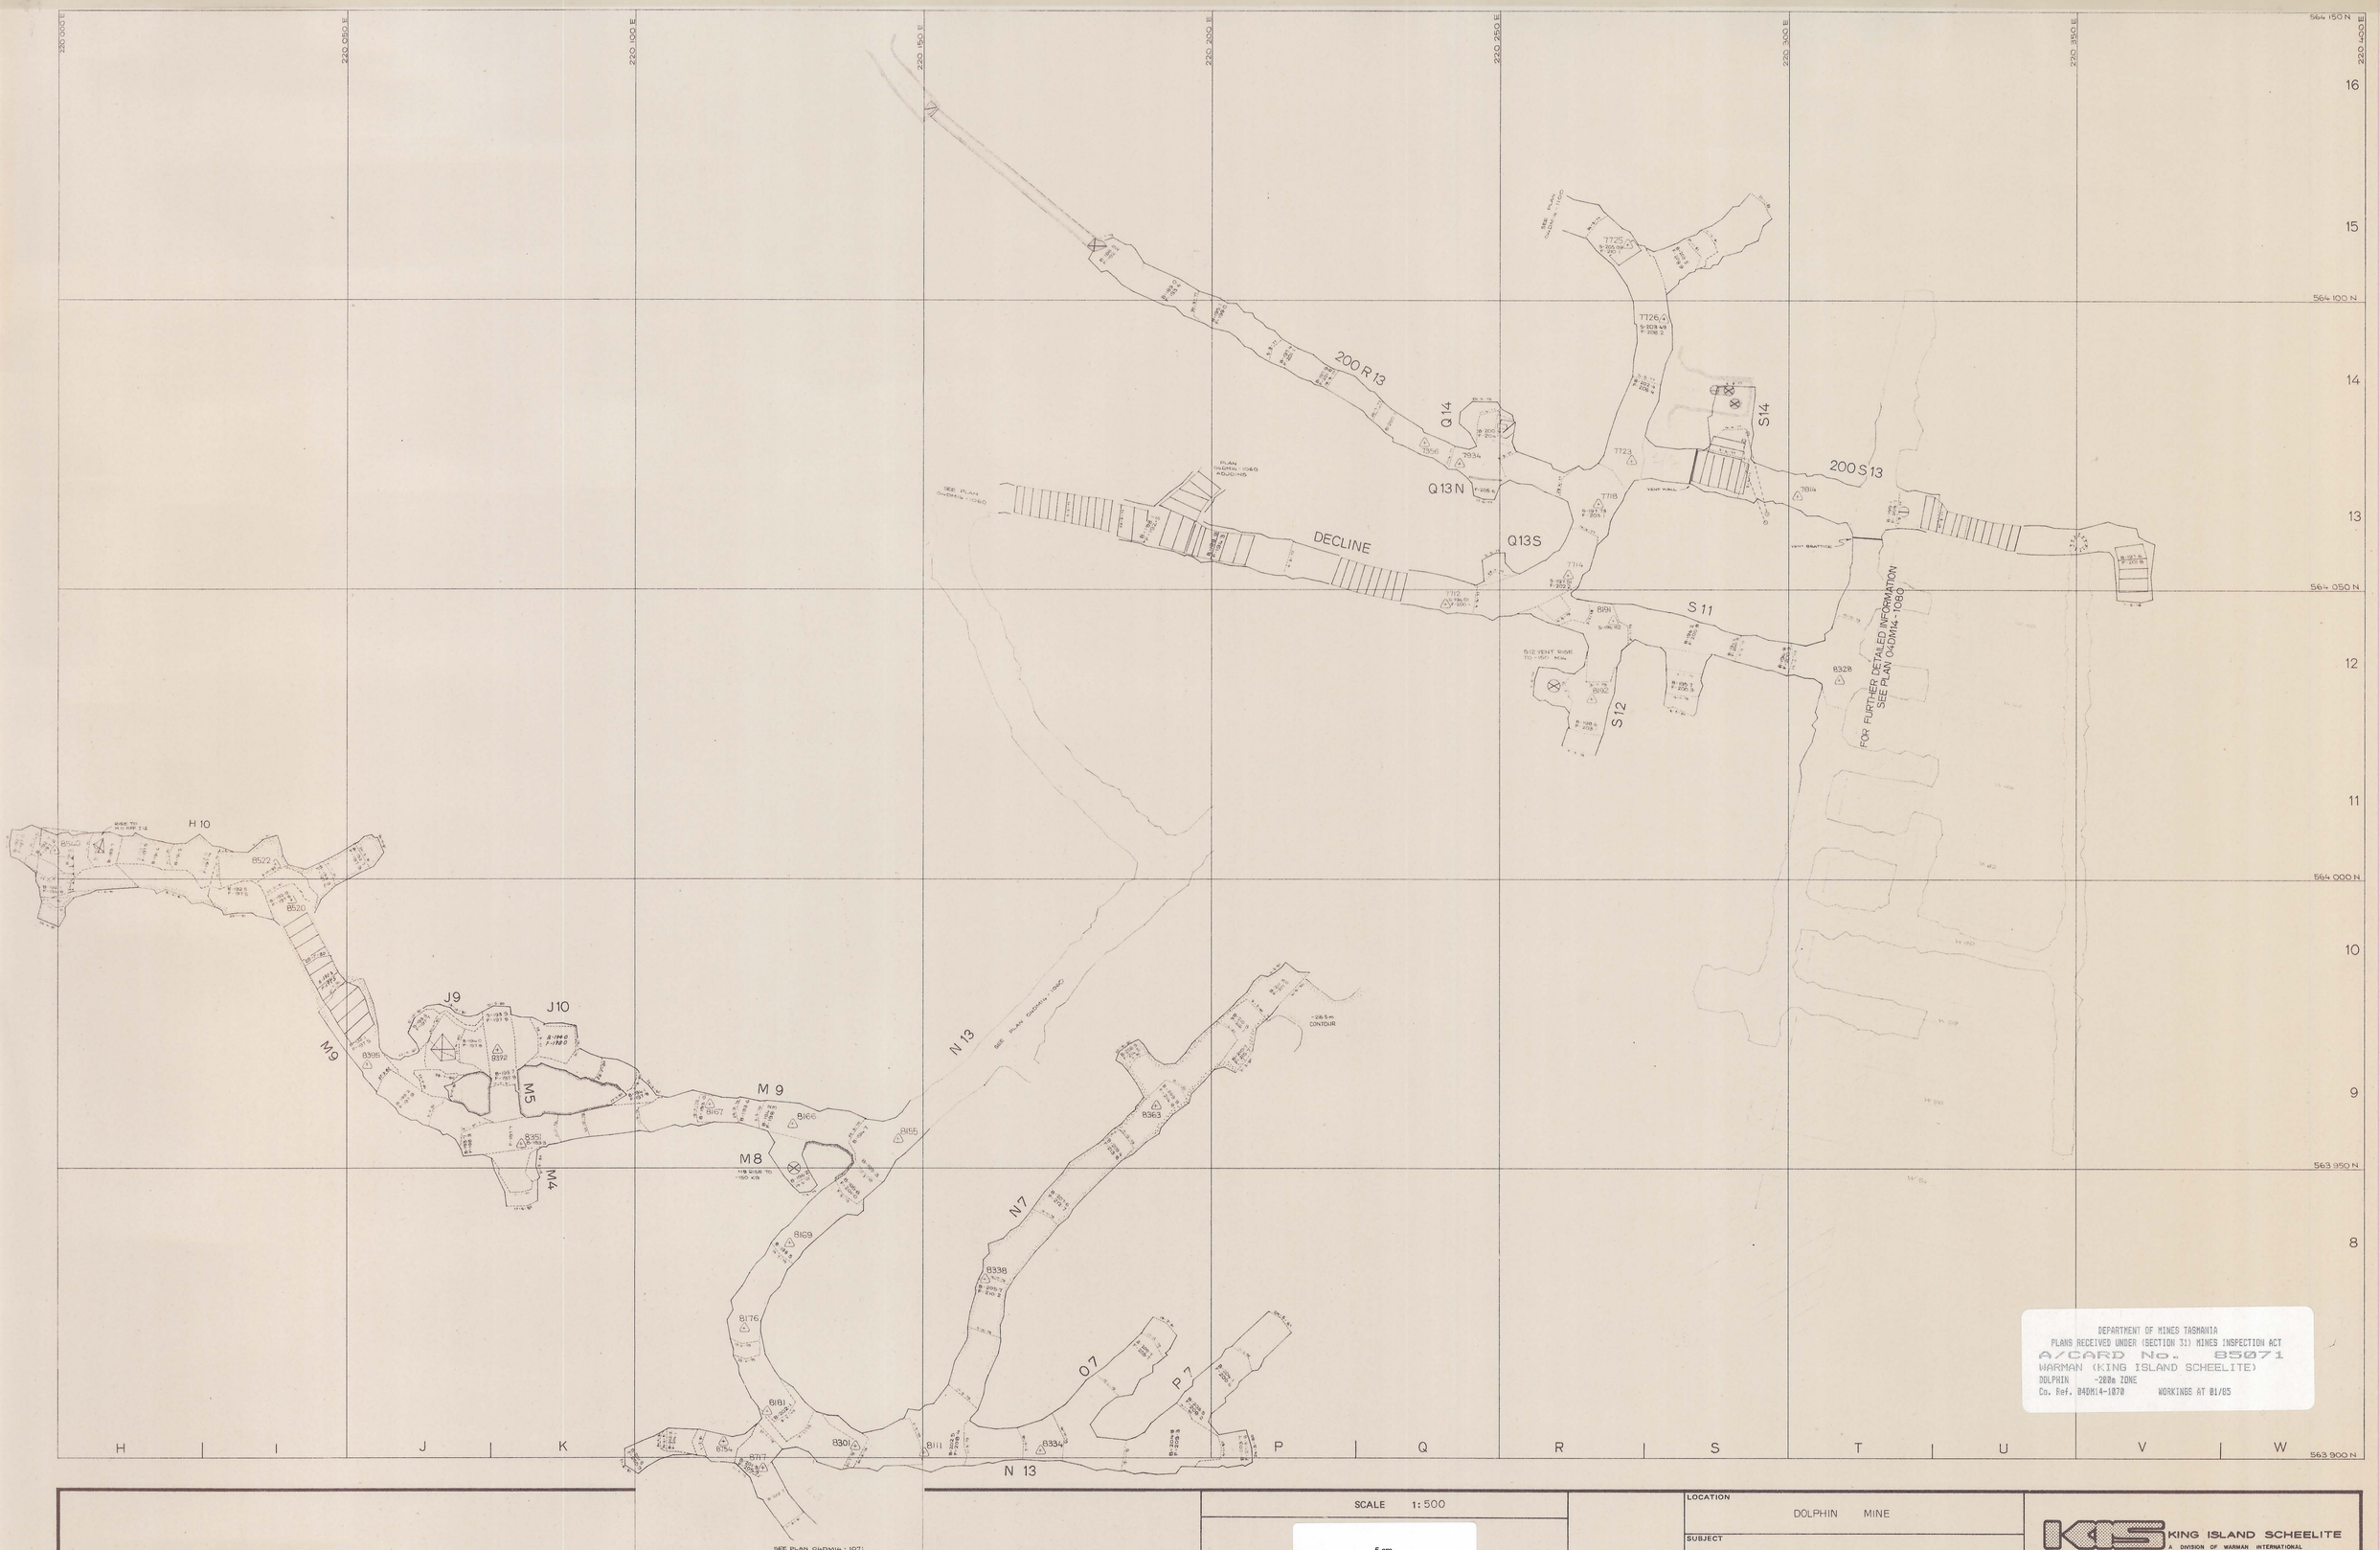

DEPARTMENT OF MINES TASMANIA
PLANS RECEIVED UNDER (SECTION 31) MINES INSPECTION ACT
A/CARD No. 85071
WARMAN (KING ISLAND SCHEELITE)
DOLPHIN -200m ZONE
Co. Ref. 04DM14-1070 WORKINGS AT 01/85

SCALE 1:500	north	LOCATION: DOLPHIN MINE	KIS KING ISLAND SCHEELITE — A DIVISION OF WARMAN INTERNATIONAL
5 cm		SUBJECT: -200m ZONE	GRASSY KING ISLAND
			PLAN NUMBER: 04DM14 - 1070