0374-100

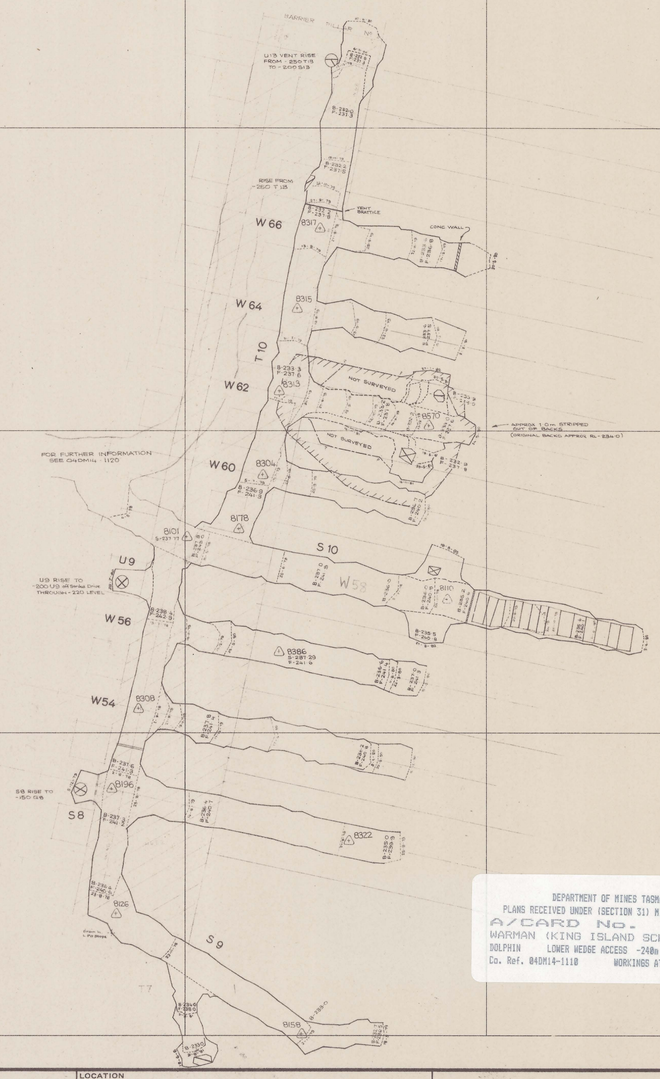


DEPARTMENT OF MINES TASMANIA
PLANS RECEIVED UNDER (SECTION 31) MINES INSPECTION ACT
A/CARD No. 85076
WARMAN (KING ISLAND SCHEELITE)
DOLPHIN LOWER WEDGE ACCESS -240m LEVEL
Co. Ref. 04DM14-1110 WORKINGS AT 01/85

| | | | |
|---|---|---|---|
| SCALE 1:500 | north | LOCATION: DOLPHIN MINE | KIS KING ISLAND SCHEELITE — A DIVISION OF WARMAN INTERNATIONAL |
| 5 cm | | SUBJECT: LOWER WEDGE ACCESS -240m LEVEL | GRASSY KING ISLAND |
| | | | PLAN NUMBER: 04DM14 - 1110 |