27 JUN 1981

0374_1024

KG04DM12-146142.

LOWER WEDGE STOPE ACCESS -220 ZONE

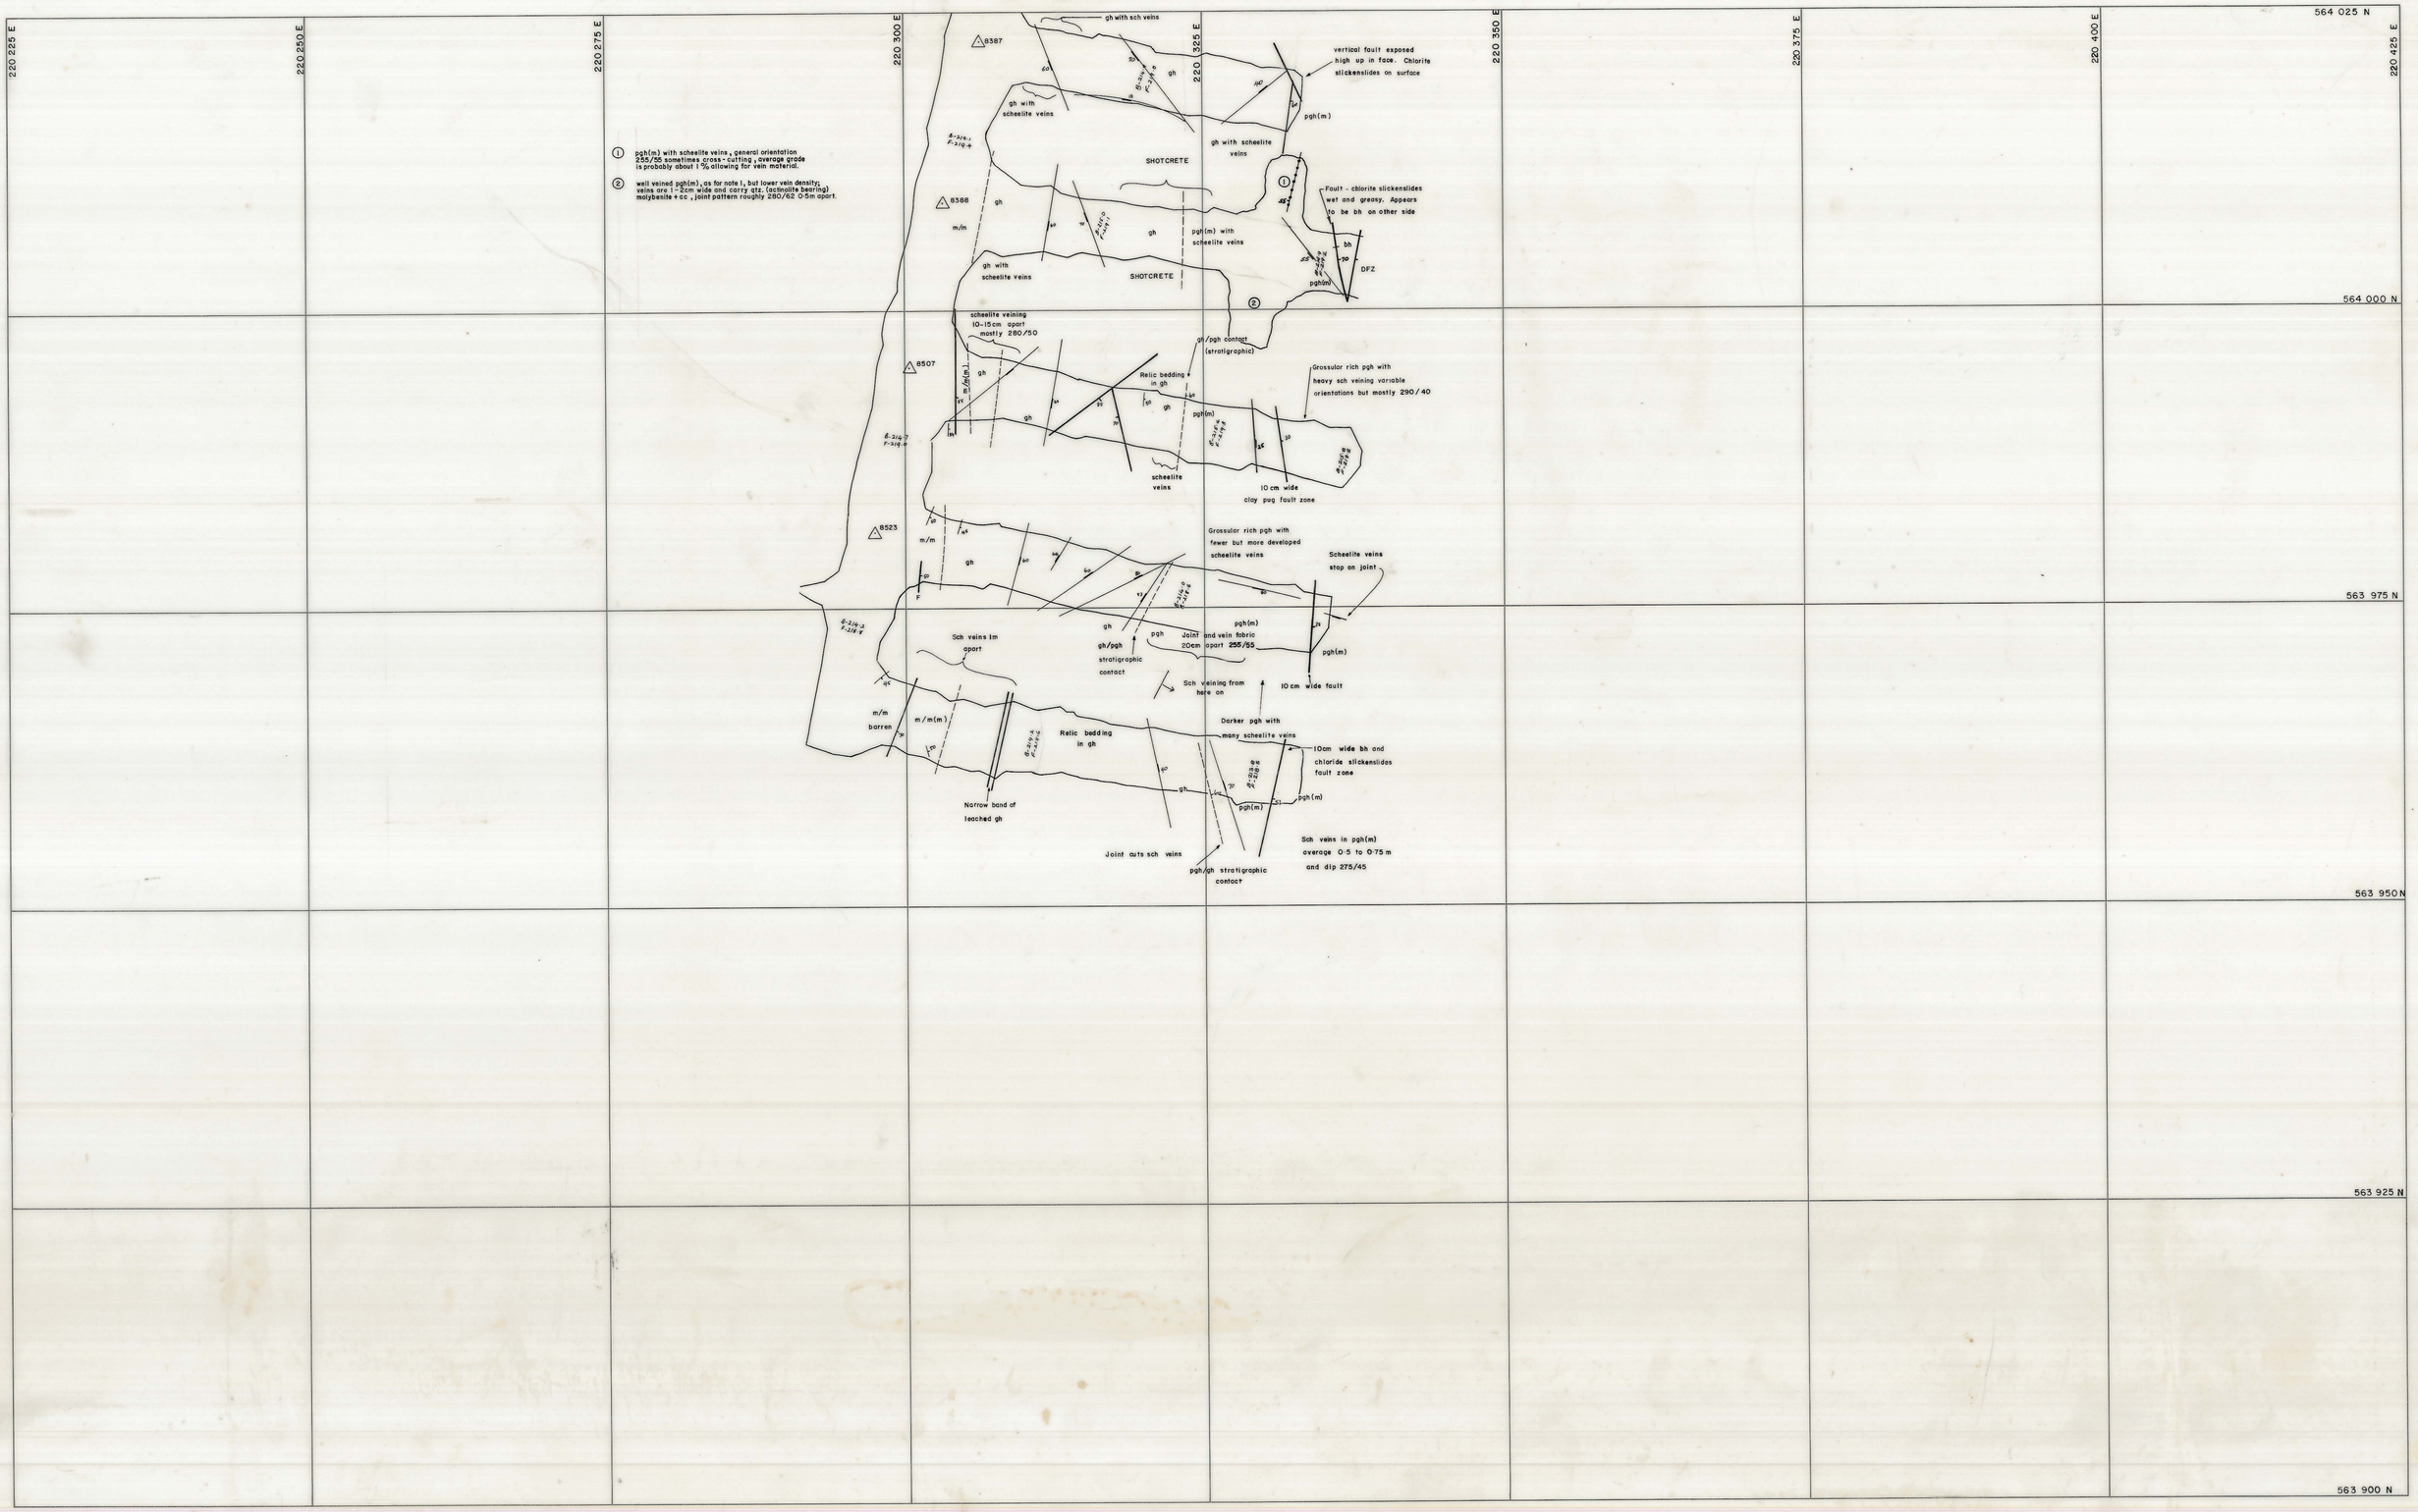


SCALE 1: 250

5 cm

north

LOCATION: DOLPHIN MINE

SUBJECT: LOWER WEDGE STOPE ACCESS -220 ZONE

KING ISLAND SCHEELITE
A DIVISION OF WARMAN INTERNATIONAL

GRASSY KING ISLAND

PLAN NUMBER 04DM12-146142

0374_1024