0374_1033

PIT AREA
9th Lift

Lift			
Back R.L.			
Brow R.L.			
PRODUCTION	Tonnes	Grade	MTU
SCHEDULED			
ACTUAL			

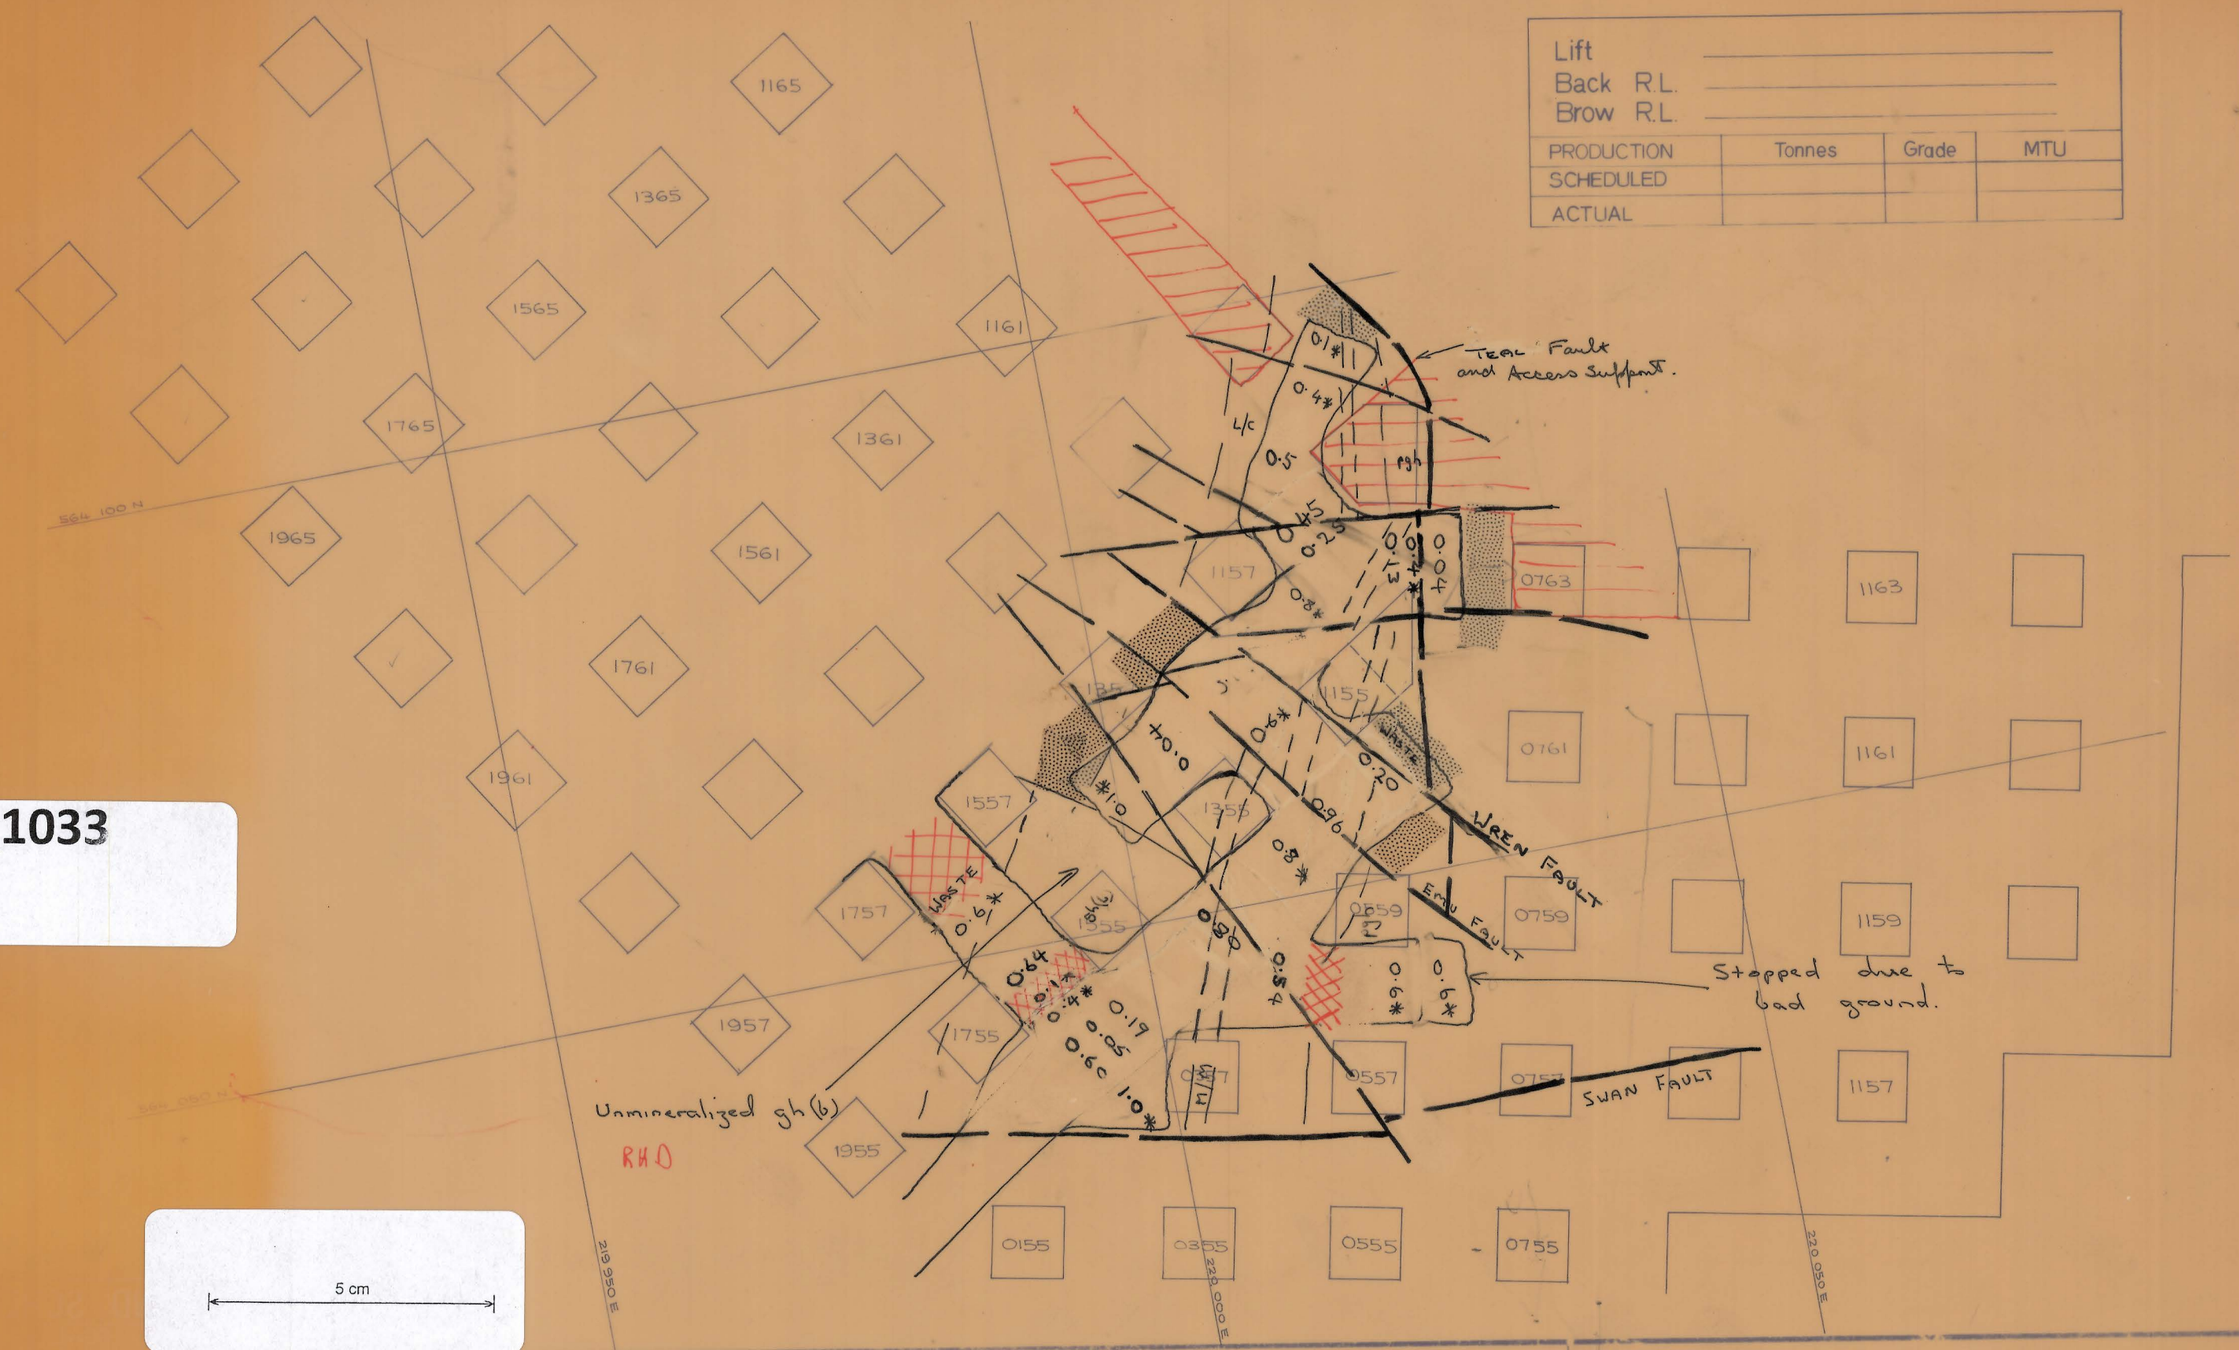

0374_1033

5 cm

SCALE 1 : 500

Mining Limit

Mucked As Waste

Waste

north

DOLPHIN MINE

PIT STOPE 9th Lift

PERIOD 2

1978/79

KING ISLAND SCHEELITE

GRASSY KING ISLAND

* LAMPED VALUE

PLAN NUMBER 06DM04-3001