LOWER PIT
LIFT 6
ASSAYS

0374_1046

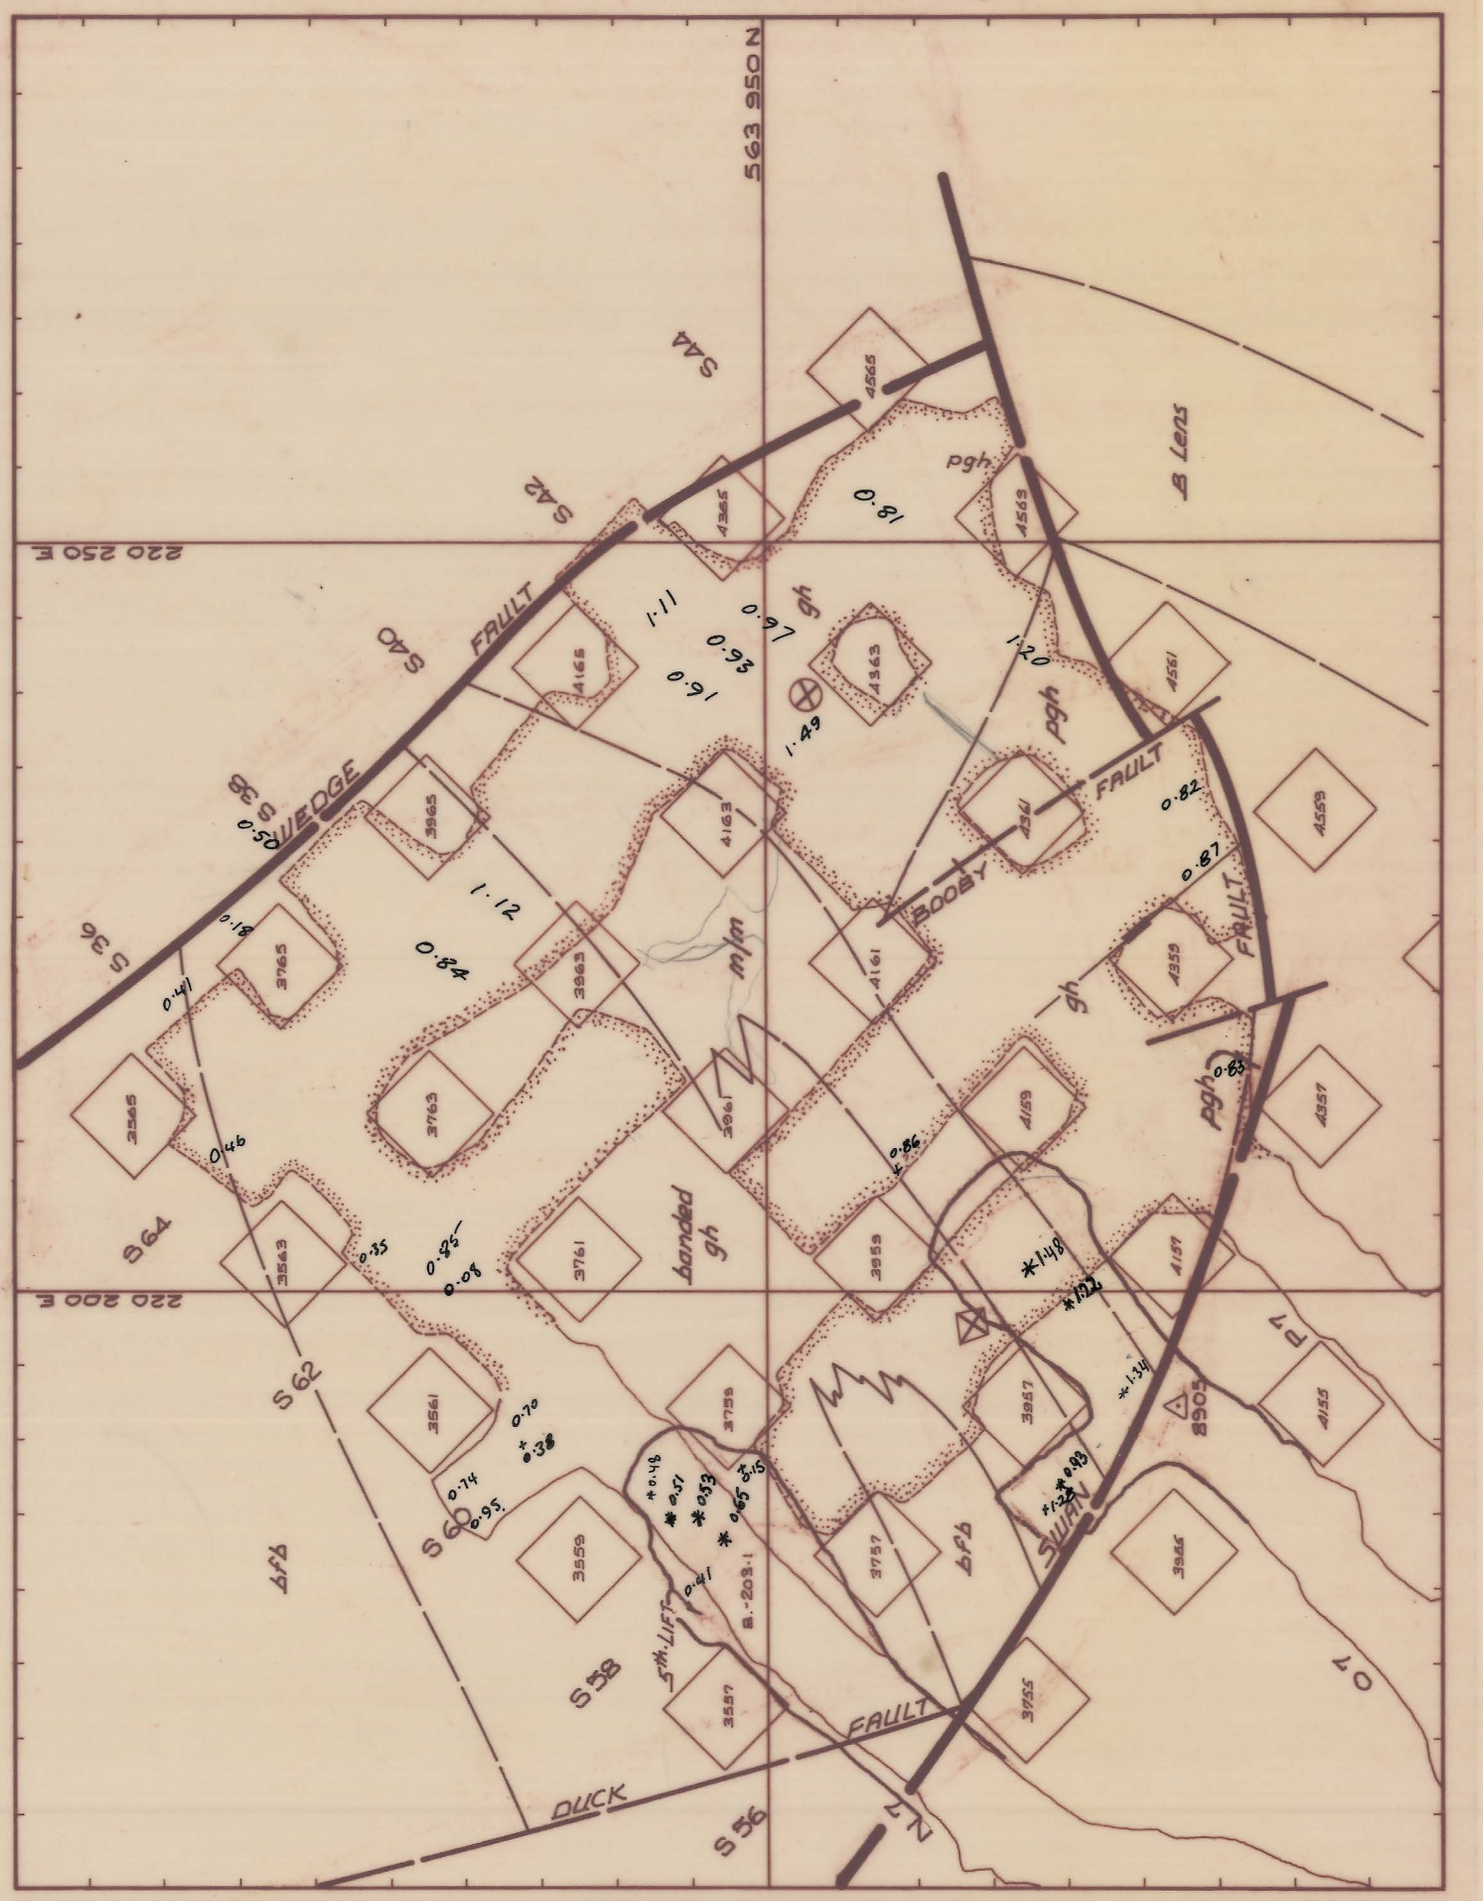

REF. PLAN				1 : 500 SCALE	KIS KING ISLAND SCHEELITE GRASSY KING ISLAND
------ 5th LIFT	GEOLOGY			DOLPHIN MINE 6th LIFT - LOWER PIT STOPE -205·5m to -202·0m R.L. GEOLOGY at -205·5m R.L.	
(PS) PILLAR REQUIRES STITCHING IMMEDIATELY EXPOSED.	SURVEY				
	PLANNING				
	ROCK. MEC.				
(X) WEAK ROCK IN BACK	GRADE CON.				
	DRAFTING			DRAWING NUMBER	
	T.S.S.				

5 cm

0374_1046