


0374_1062



UNDER CUT COMPLETED 28.6.79

DATE 28.6.79

0374_1062

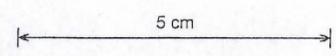

UNDER CUT * LAMP VALUE
 RL -230m to -226.5m