


0374_1064

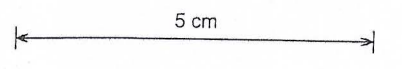



- Top Edge:** Labeled "40 425 E".
- Left Side:** "IMAGINARY BACK RL OF LIFT NO 8." with a dashed line.
- Central Area:**
 - Red hatched area: "LIFT 10 (BACK 1055 1055.5)".
 - Yellow hatched area: "3-10-51", "21-9-51", "30-10-51".
 - Blue hatched area: "1055.1", "1055.2", "1055.3", "1055.4".
 - Red arrow: "ACCESS TO LIFT 10".
 - Black line: "BACK RL 1051.5 APPROX. LIFT 9".
 - Blue line: "PST BACK RL APPROX. 1049.5 (WALL STRIP)".
- Right Side:** "40 400 E".


- Left Side:** "10 625 N", "10 600 N".
- Central Area:**
 - Hatched area: "HATCHED AREA SHOWS SURVEYORS P/U OF WALL STRIPPING WHICH CONSTITUTES LIFT 8 OF P 57 STOPE." with an arrow pointing to the area.
 - Labels: "5226", "5194A", "5193A", "5182", "5181", "517B".
 - Labels: "BIOG 3 FLOW 2", "BIOG 1 FLOW 0", "BIOG 0 FLOW 0", "BIOG 1 FLOW 1", "BIOG 2 FLOW 1", "BIOG 3 FLOW 2".
 - Label: "0.60 RISE GONE ON EX THRU P 57 STOPE".
 - Label: "P 57".
- Right Side:** "40 375 E", "10 550 N".