0374_1075

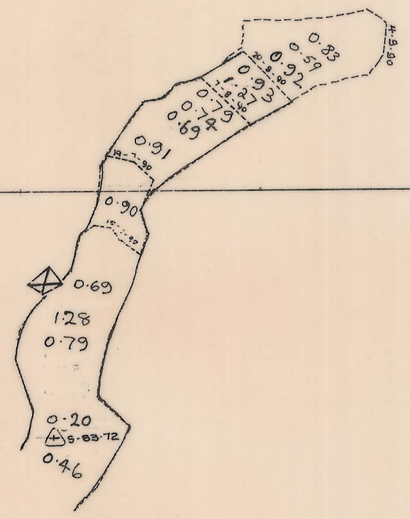

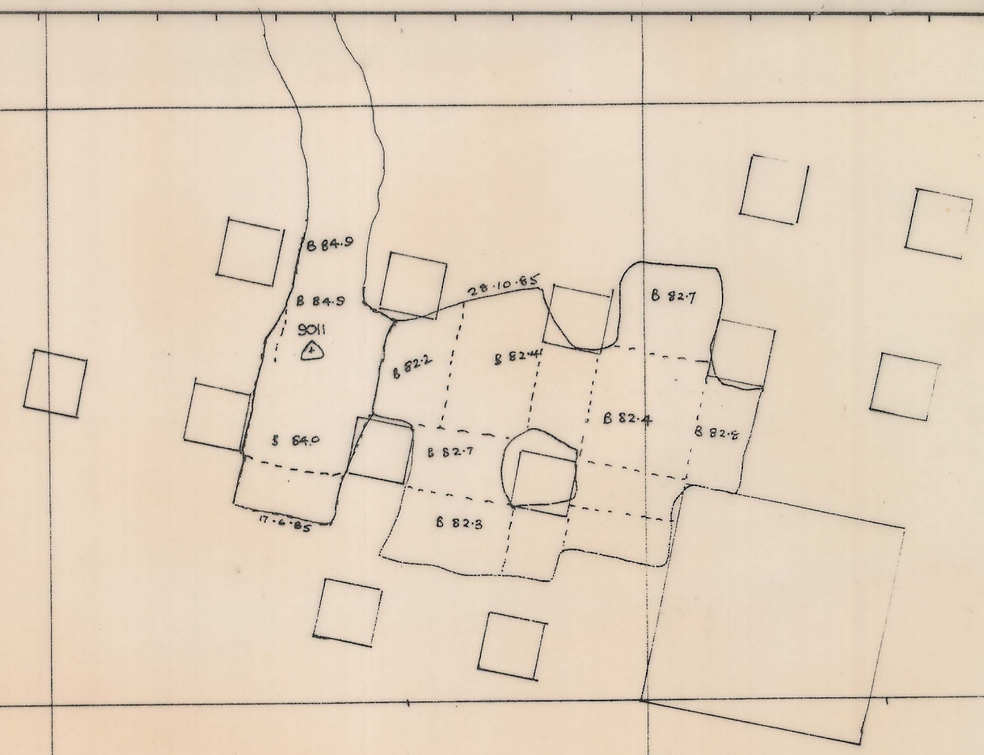

0374_1075

5 cm

REF. PLAN	GEOLOGY			SCALE 1: 500	KIS KING ISLAND SCHEELITE GRASSY KING ISLAND
	SURVEY			UPPER PIT LIFT 19	
	PLANNING			ASSAY PLAN	
	ROCK MEC.				
	GRADE CON.				
	DRAFTING			DRAWING NUMBER	
	T.S.S.				