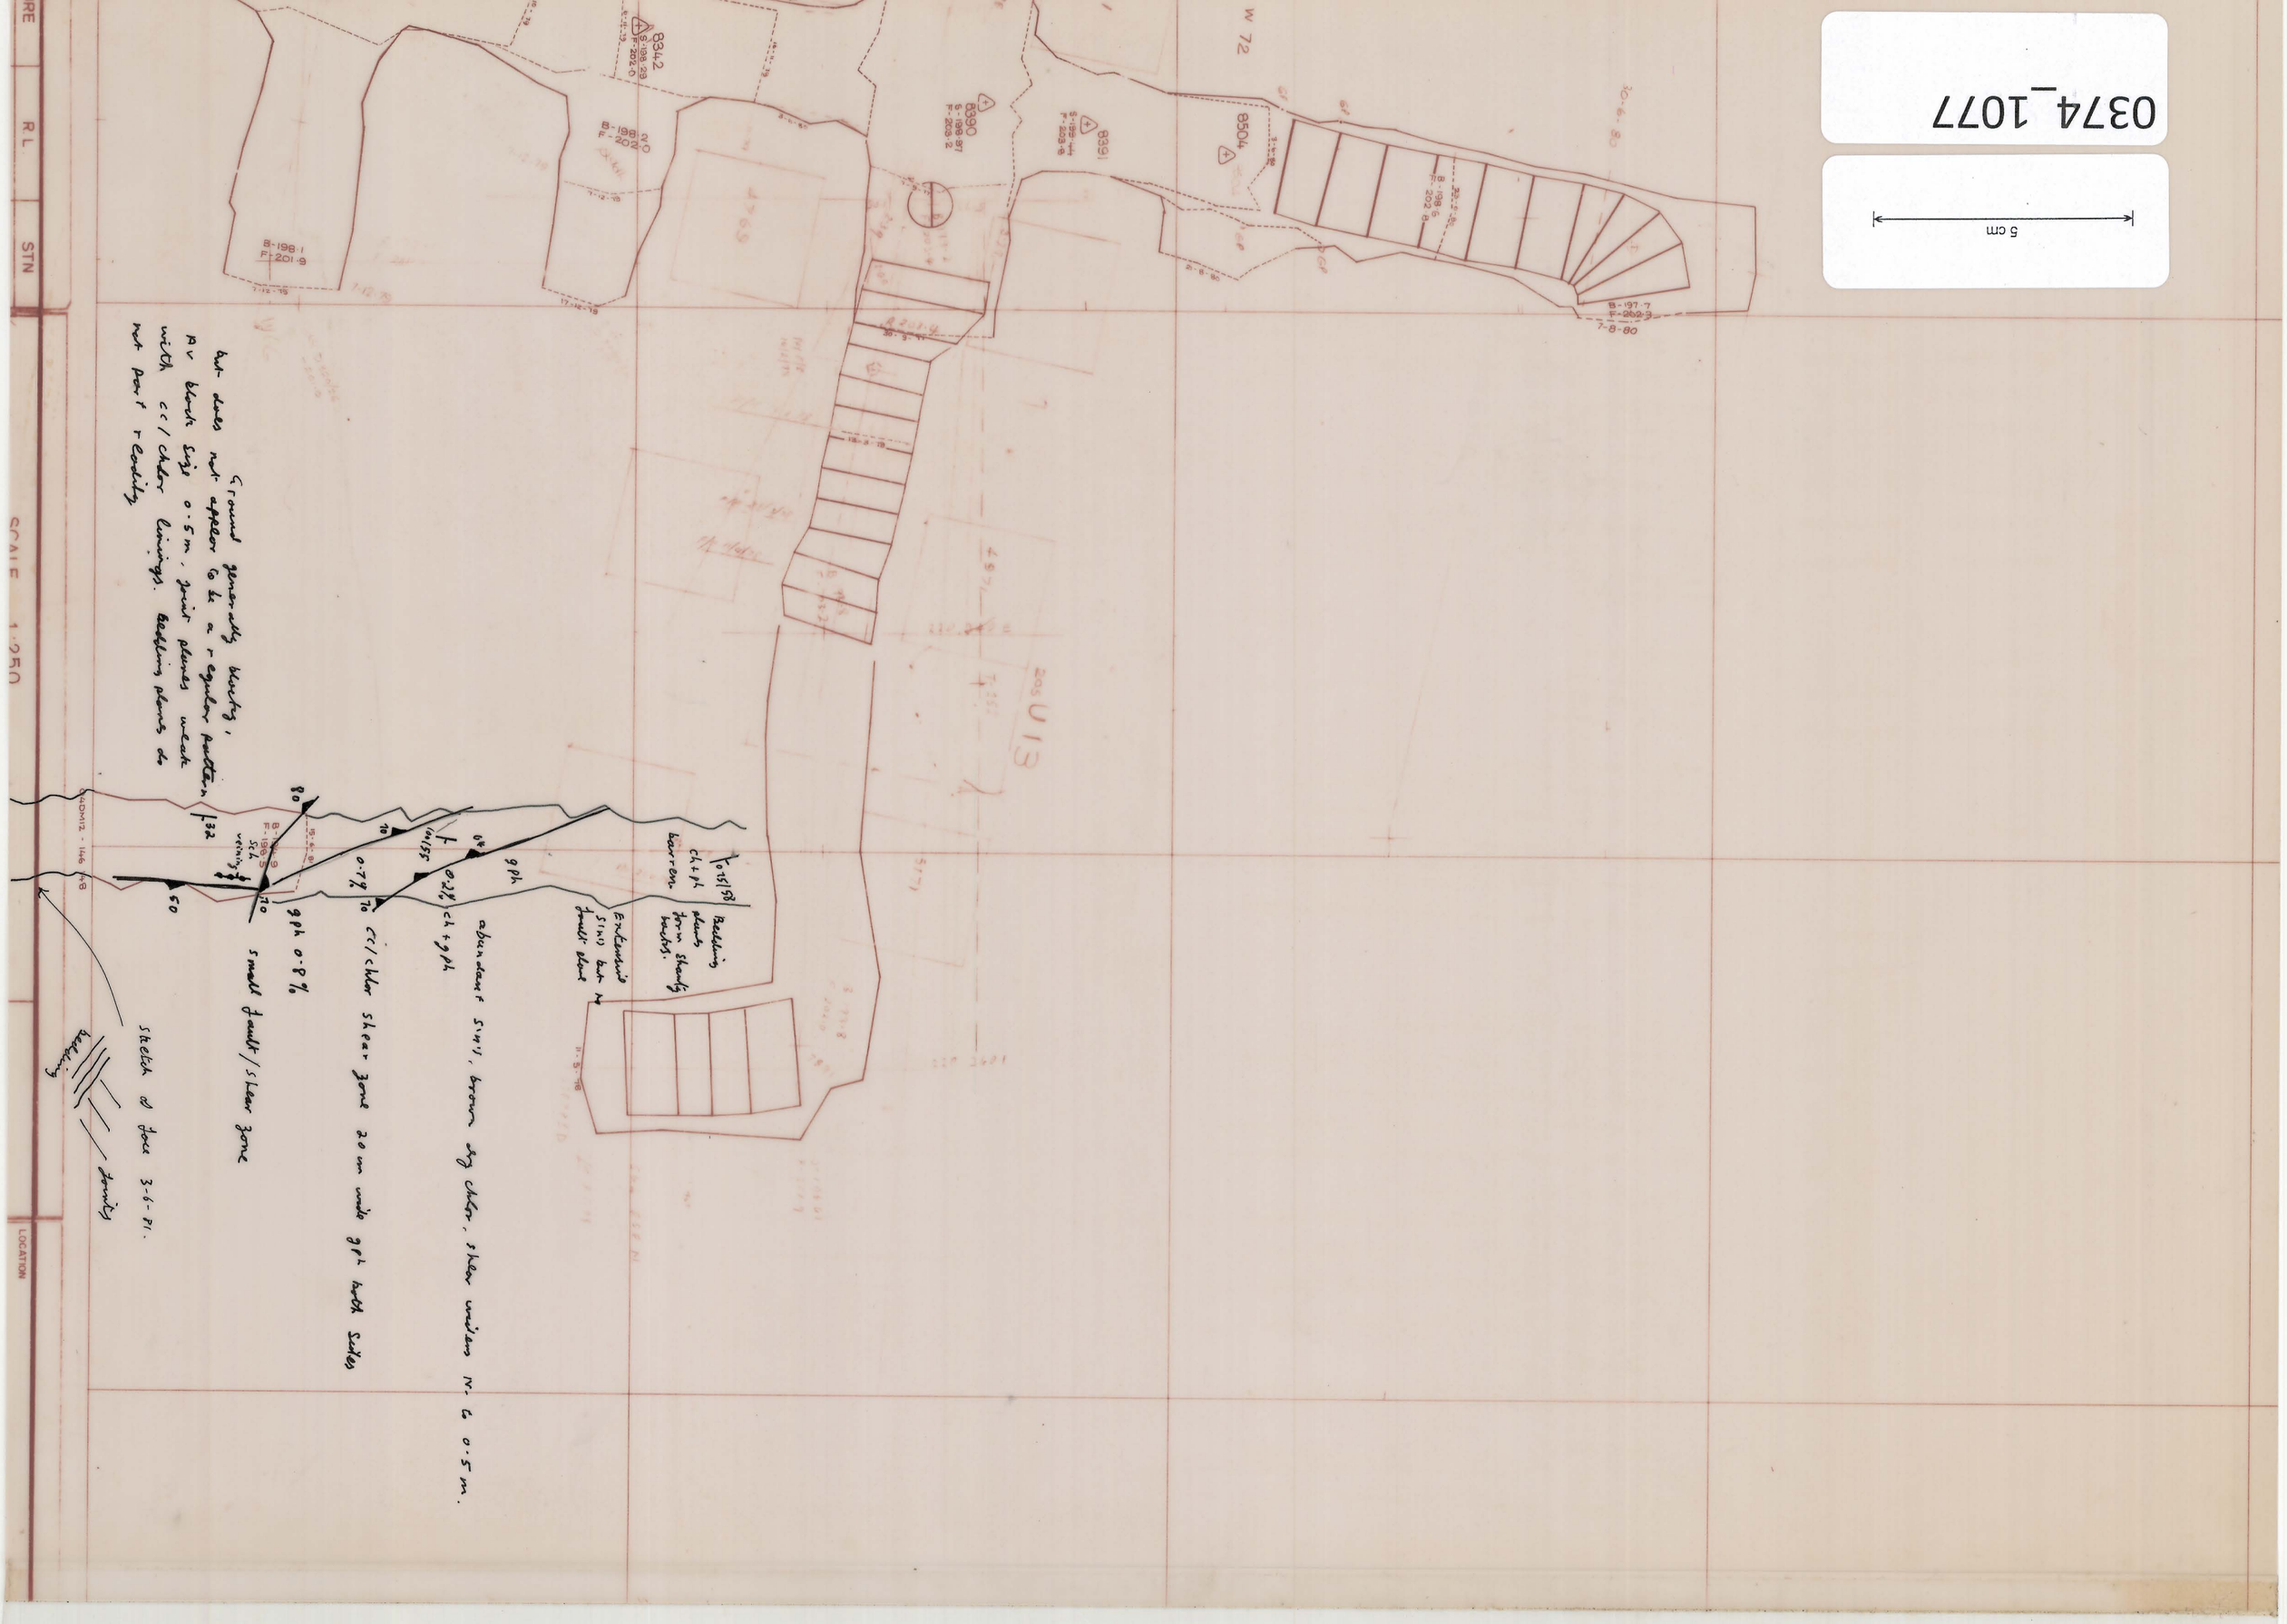

5 cm

0374_1077

L. WEDGE
-200m level
HANGINGWALL
SUPPORT
DRIVE

JUN 1981

0374_1077