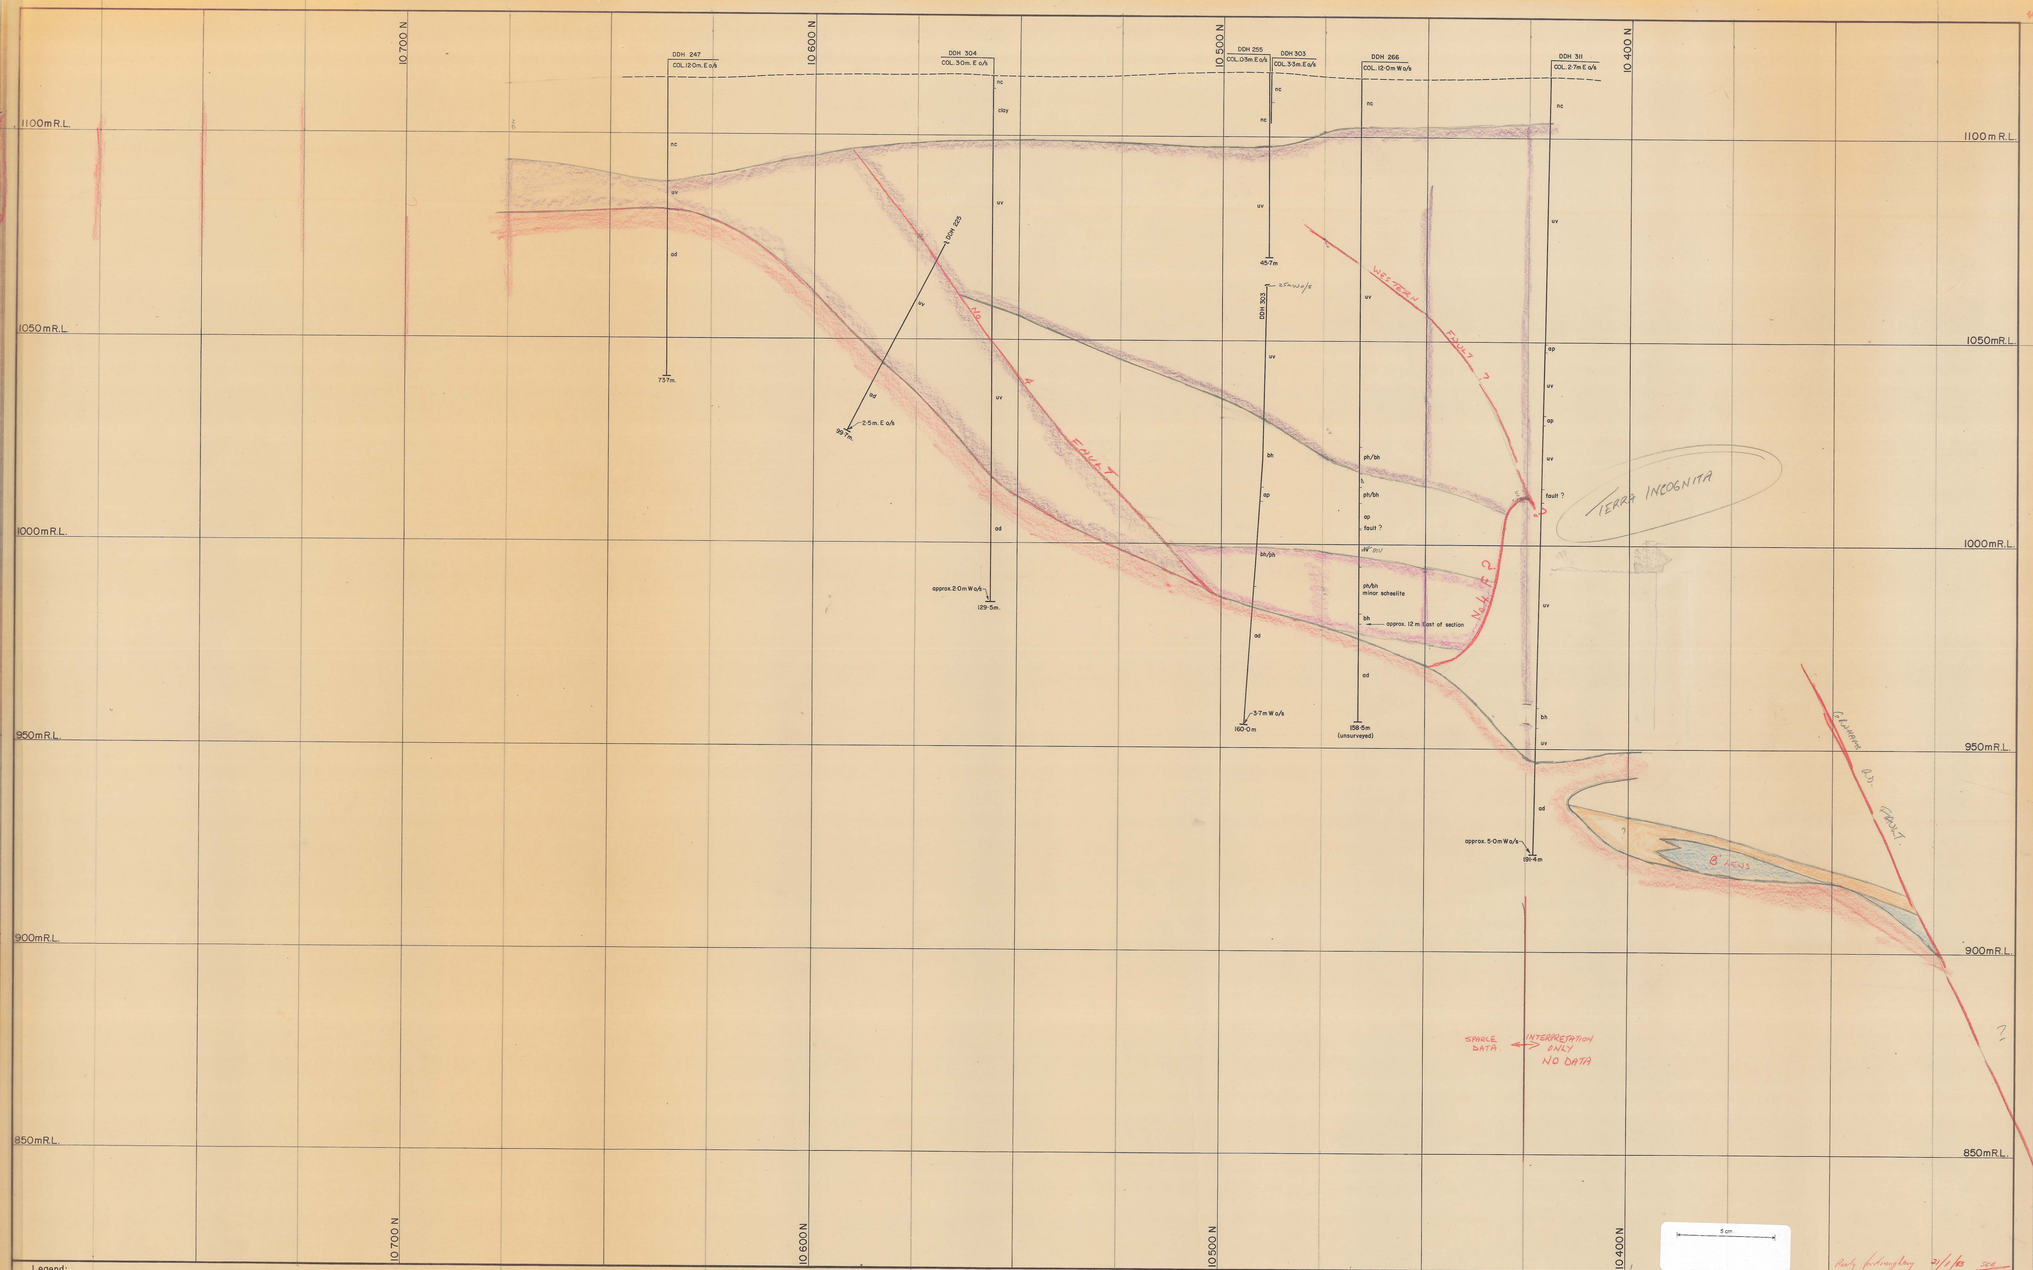

Legend:

uv	Upper metavolcanics	pgh	Pyroxene garnet hornfels	od	Adamellite		Breccia
bh	Biotite hornfels	gh	Mineralized skarn (> 0·25% WO_3)	op	Aplite		Fault showing relative movement
ph	Pyroxene hornfels	gh	Unmineralized skarn (< 0·25% WO_3)	G_1	Ore lens designator		Degree of uncertainty in fault position
ch	Marble	bh/ph ch/gh	Banded footwall beds			#.##	Figures refer to assay results in % WO_3
lv	Lower metavolcanics	q	Quartzite				Angle of bedding to long axis of core
						nc	No core recovered

DDH 479
COL. 5·5m E o/s
Indicates collar location as being 5·5 metres East of section

7·1m E o/s
173·7m
Indicated point is 7·1 metres East of section

Notes 1) Indications exist that the granite/skarn contact is in some areas poorly controlled (see 1973)
2) Openings updated to 14/4/83

Comments - 74 1133 74-77E8 77-79 80 79-81

Ready for drafting 21/6/83 JCC

0374_1112

DATE: AUG, 1975	GEOPEKO LIMITED KING ISLAND GROUP
GEOLOGIST: S.G.B.	SCALE: 1:500 — No. KG3-24-001
DRAWN: O.S.	BOLD HEAD OREBODY GEOLOGICAL LONG SECTION
CHECKED: M.C.R.	40 250 E

0374_1112