Bold Head Mine

0374 - 1115

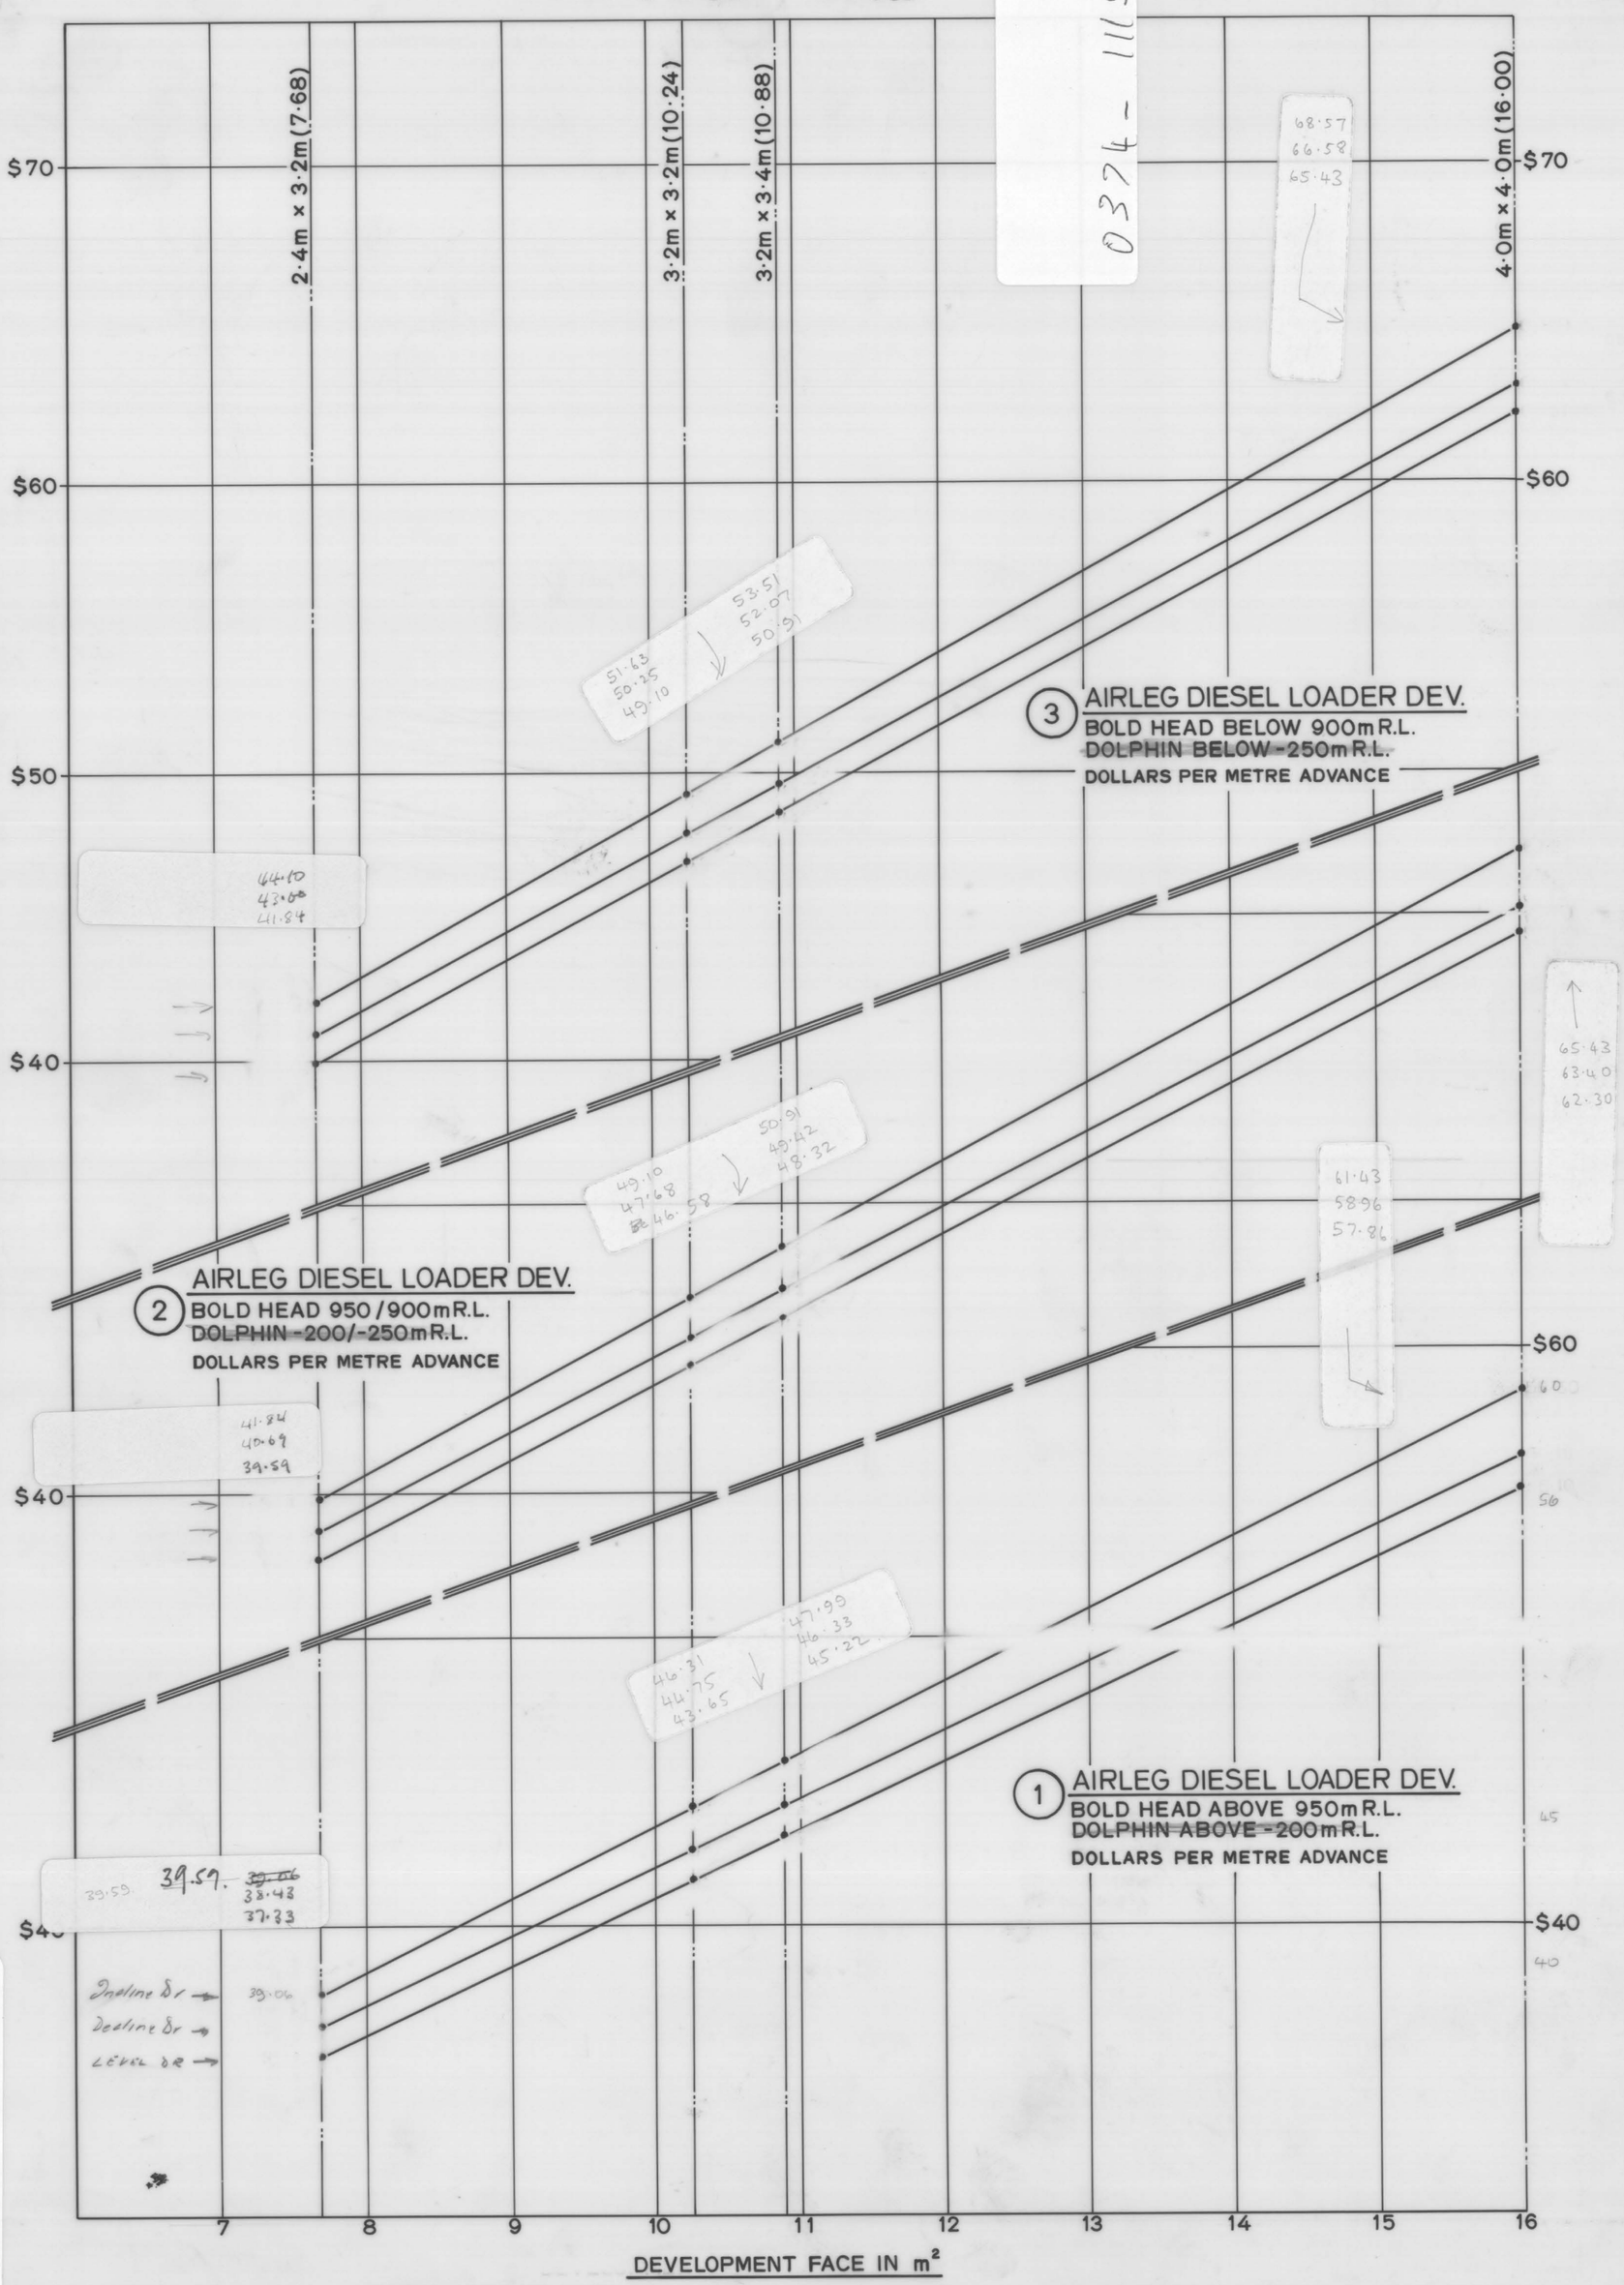

0374 - 1115

5 cm