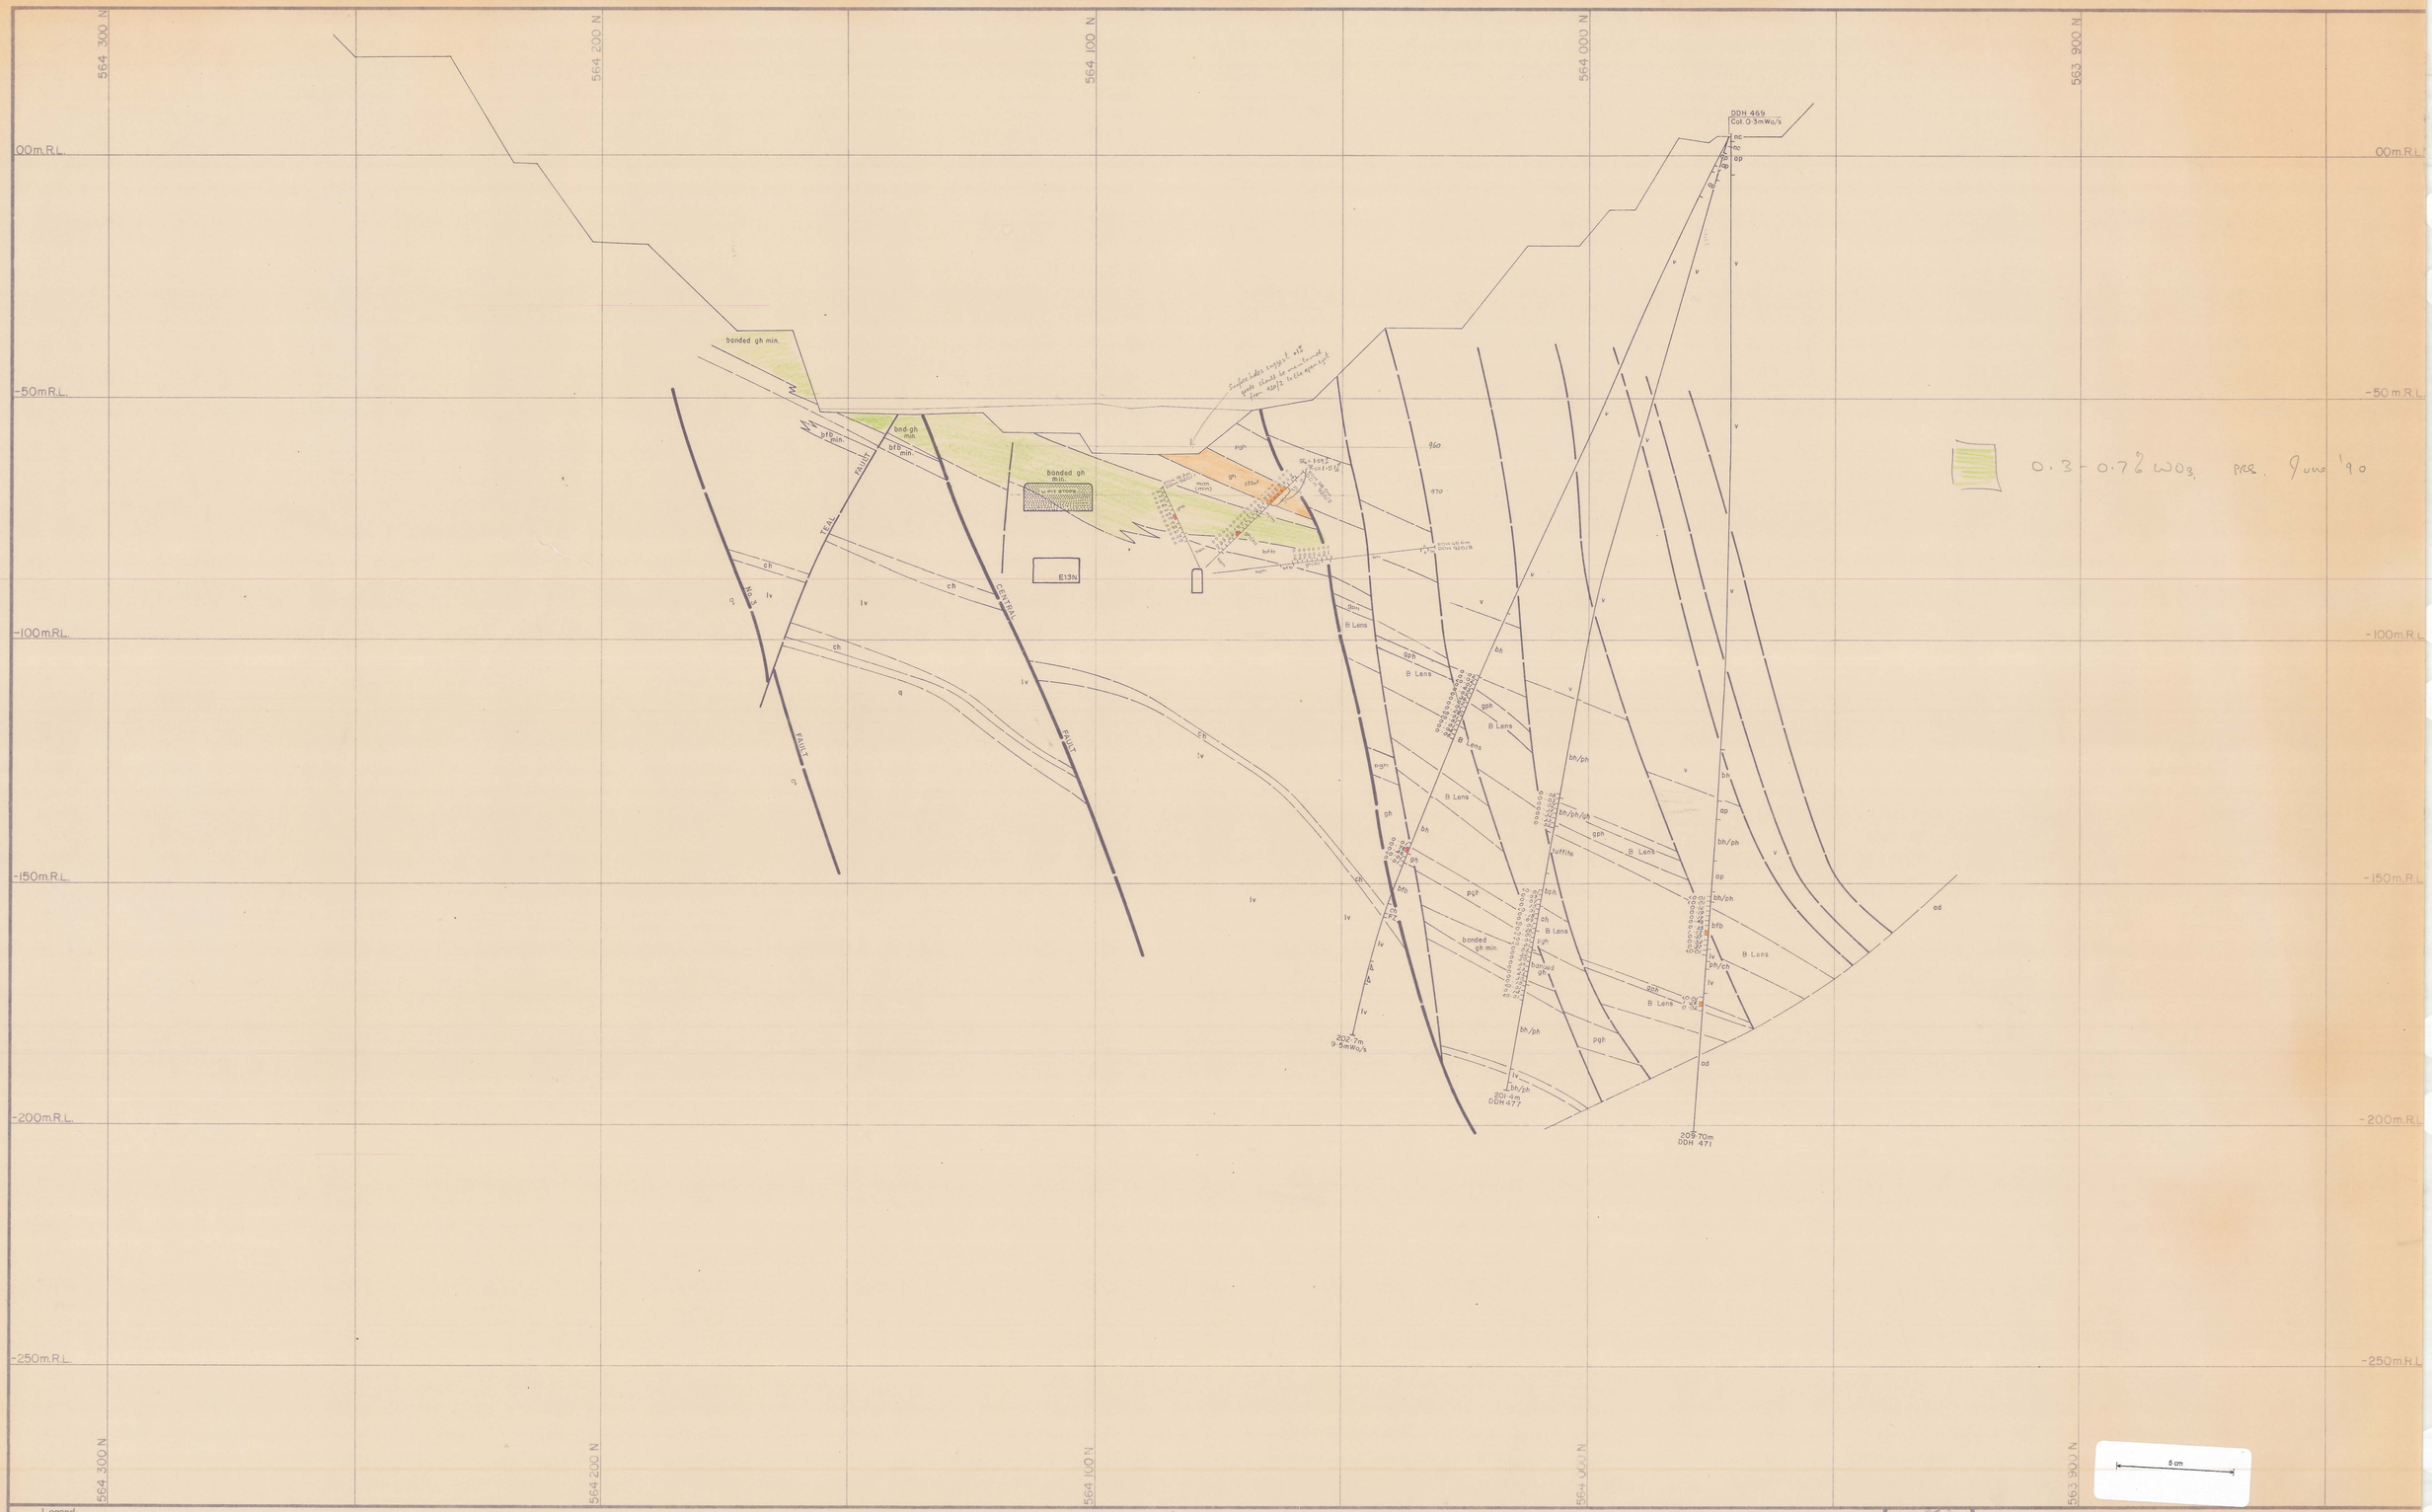

Legend:

- v — Upper metavolcanics
- bh/ph — Banded hornfels
- ch — Marble
- bh — Biotite hornfels
- pgh — Pyroxene garnet hornfels
- gh — Garnet hornfels
- bfb/ph — Banded footwall beds
- bph — Biotite pyroxene hornfels
- lv — Lower metavolcanics
- q — Quartzite
- ap — Aplite
- 60 — Strike and dip
- Joint, inclined
- Joint, vertical
- Fault
- Degree of uncertainty in Fault position
- Direction of bedding with respect to core axis

RQD Rock Quality Designator

J/M Joints per Metre of recovered core

RQD %:
>90 Minimum or no support
70-90 Intermediate support, rockbolts and one shotcrete application
<50 Maximum support
(after E. Miller; March, 1972)

0374_1134

DATE AUGUST 1987 BJC
SCALE 1:500 5 cm
DRAWN
CHECK

KING ISLAND SCHEELITE

SCALE 1:500 No. KG2-

JUN 1989

DOLPHIN MINE
GEOLOGICAL CROSS-SECTION
219 920 E

0374_1134