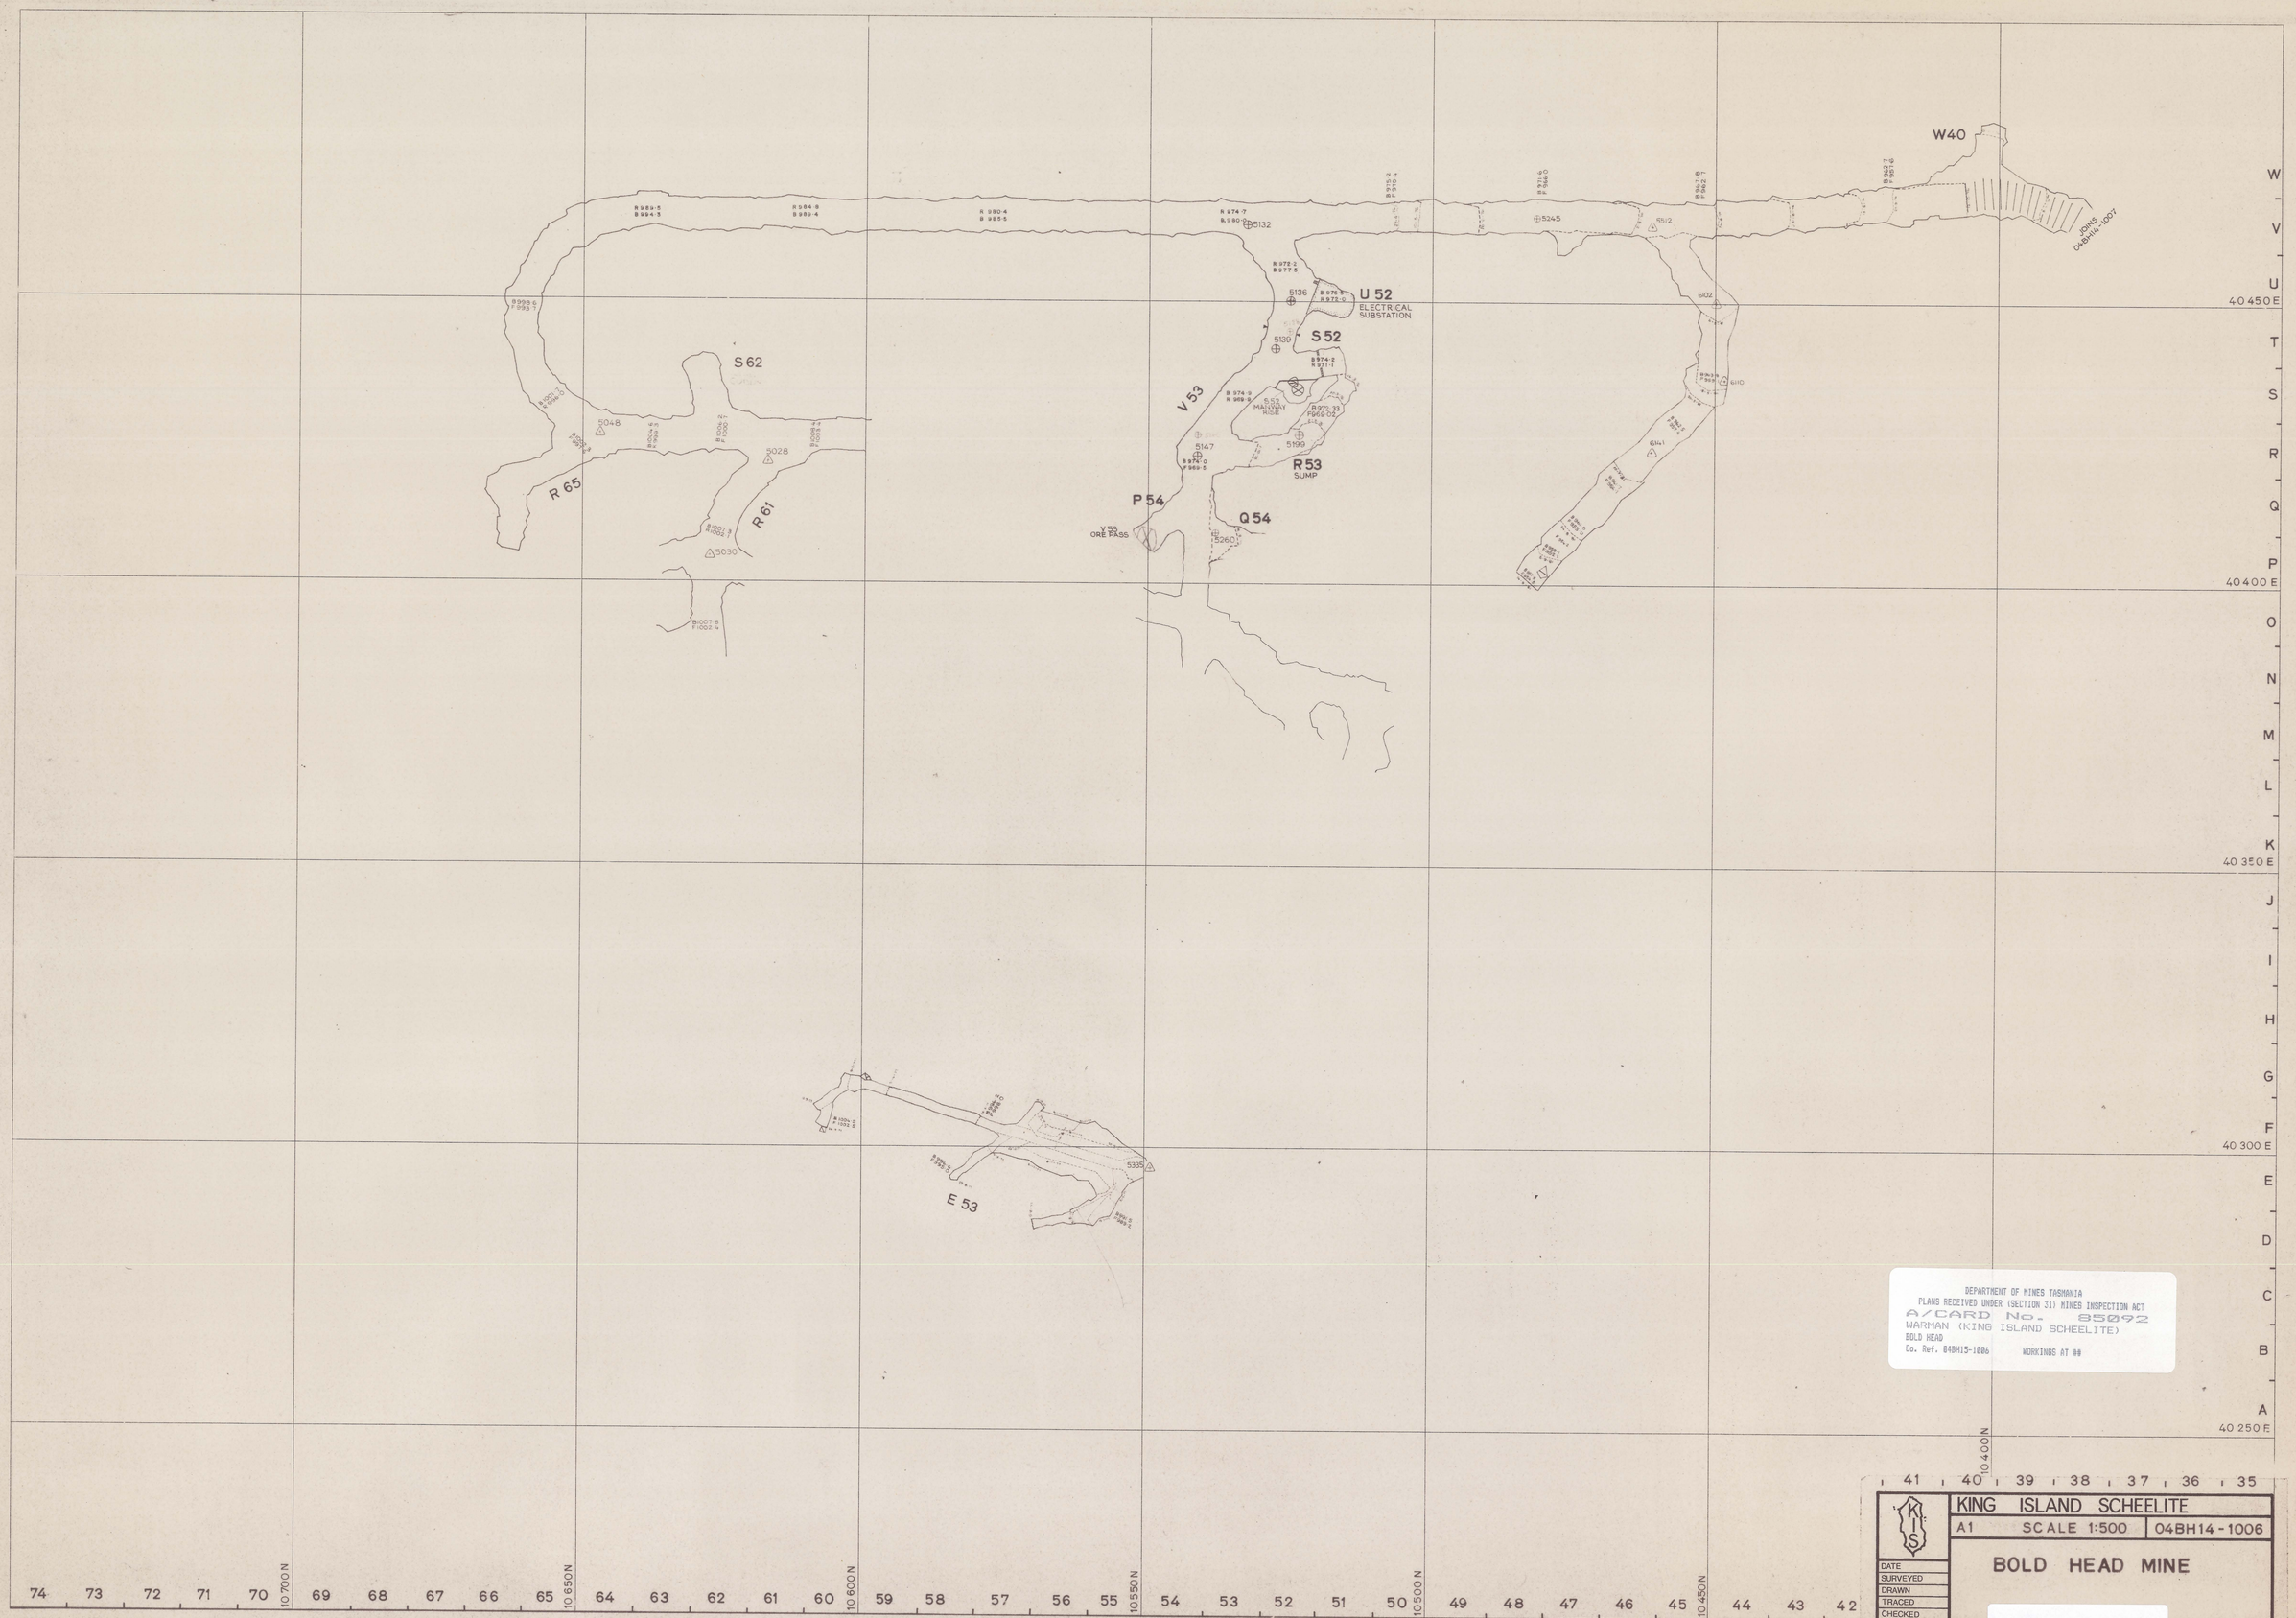
W40
JONS OHBHIL-1007
U 52
ELECTRICAL SUBSTATION
S 52
V 53
S 62
R 65
R 61
P 54
V 53 ORE PASS
Q 54
R 53
SUMP
E 53
W
V
U
T
S
R
Q
P
O
N
M
L
K
J
I
H
G
F
E
D
C
B
A
40 450 E
40 400 E
40 350 E
40 300 E
40 250 E
10 700 N
10 650 N
10 600 N
10 550 N
10 500 N
10 450 N
10 400 N
DEPARTMENT OF MINES TASMANIA
PLANS RECEIVED UNDER (SECTION 31) MINES INSPECTION ACT
A/CARD No. 85092
WARMAN (KING ISLAND SCHEELITE)
BOLD HEAD
Co. Ref. 04BH15-1006
WORKINGS AT ##
KING ISLAND SCHEELITE
A1
SCALE 1:500
04BH14-1006
BOLD HEAD MINE
DATE
SURVEYED
DRAWN
TRACED
CHECKED
5 cm

0374 - 116