0374_1266

CENTRAL
5TH LIFT
-132 to -128.5
GRAB SAMPLES

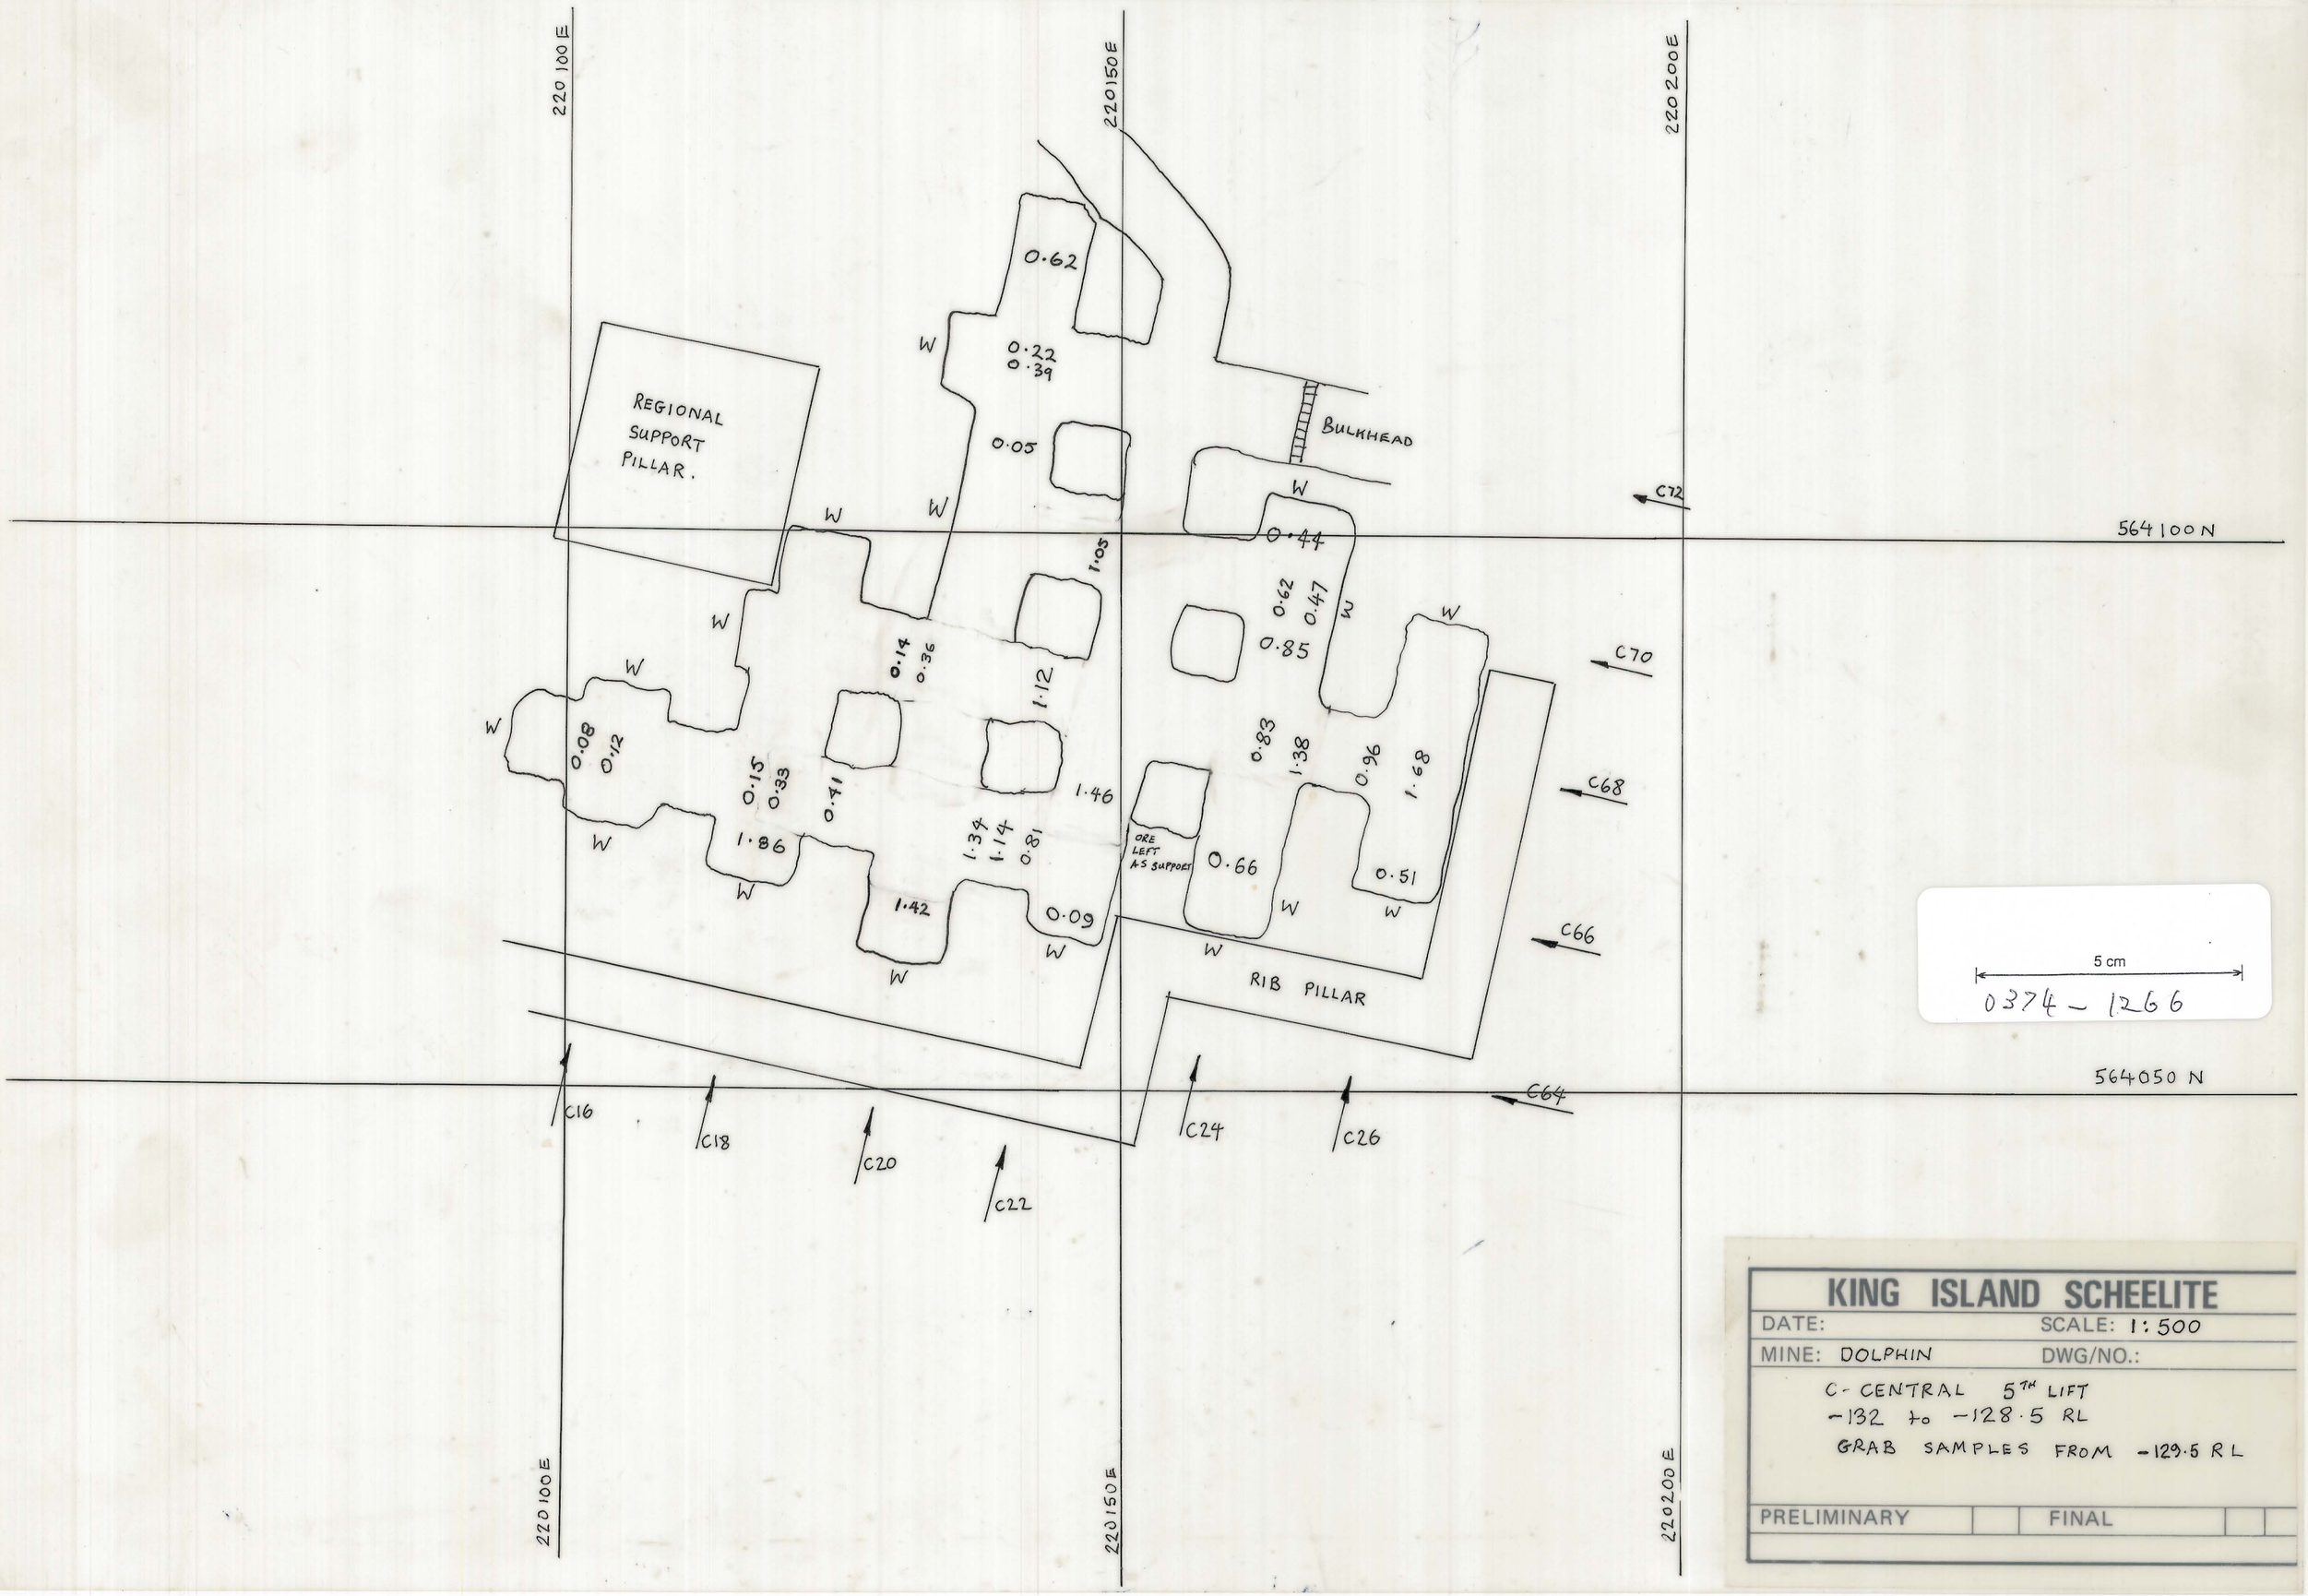

KING ISLAND SCHEELITE	
DATE:	SCALE: 1:500
MINE: DOLPHIN	DWG/NO.:
C- CENTRAL 5TH LIFT -132 to -128.5 RL GRAB SAMPLES FROM -129.5 RL	
PRELIMINARY	FINAL