


50m.

04 DM14-1001

0374_1294

27 JUN 1981

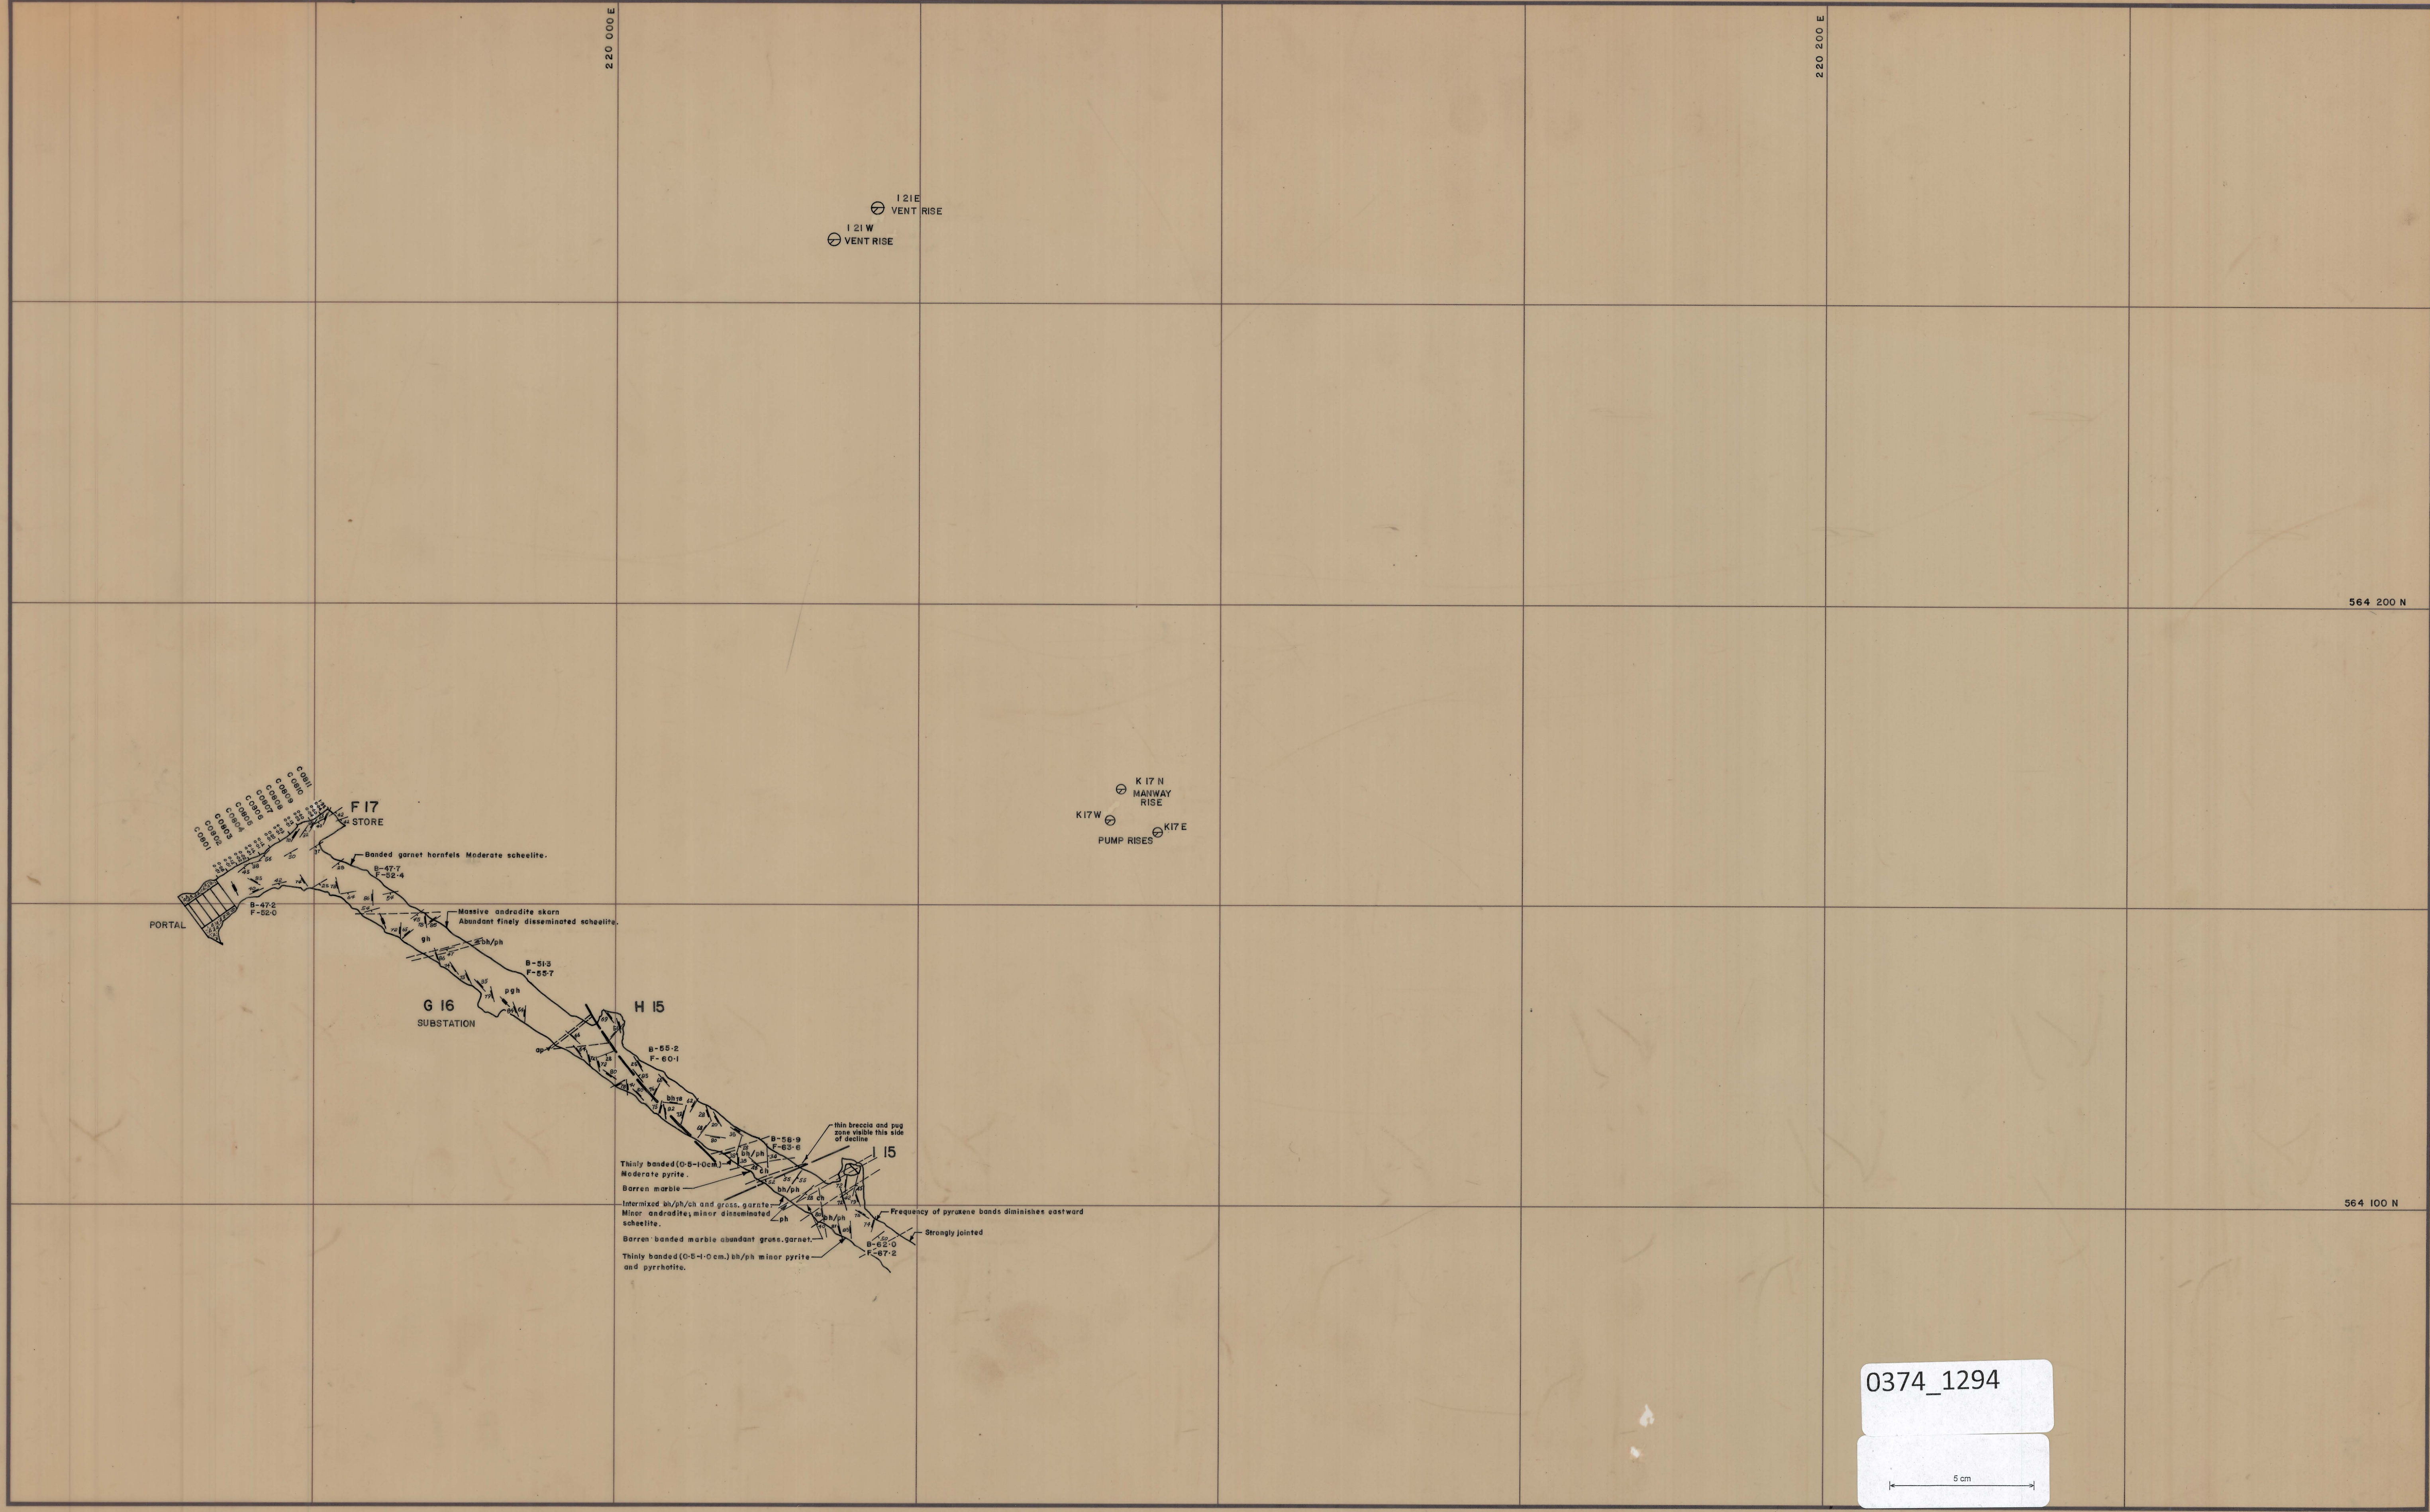

LEGEND:

v Upper metavolcanics	bh/ph Banded footwall beds	strike and dip	geological boundary
bh/ph Banded hornfels	bph Biotite pyroxene hornfels	strike and dip vertical	minor fault
ch Marble	lv Lower metavolcanics	joint	major fault
bh Biotite hornfels	q Quartzite	joint vertical	
pgh Pyroxene garnet hornfels	ap Aplite	unconformity	b back
gh Garnet hornfels	gr Granite	relative movement	f floor
		rise extending through level	r road
		head of rise	s spad
		foot of rise	
		survey station	

GEOPEKO KING ISLAND BASE
A DIVISION OF PEKO-WALLSEND OPERATIONS LTD.

DATE: JAN 79
DRAWN: M.x.d.S.
GEOLOGY:
CHECKED:

DOLPHIN MINE
-50m R.L. ZONE
F.-37m to B.-62m

DWG. No. KG04 DM14-1001