


0374_1296

27 JUN 1981

100m

DM 14-1003

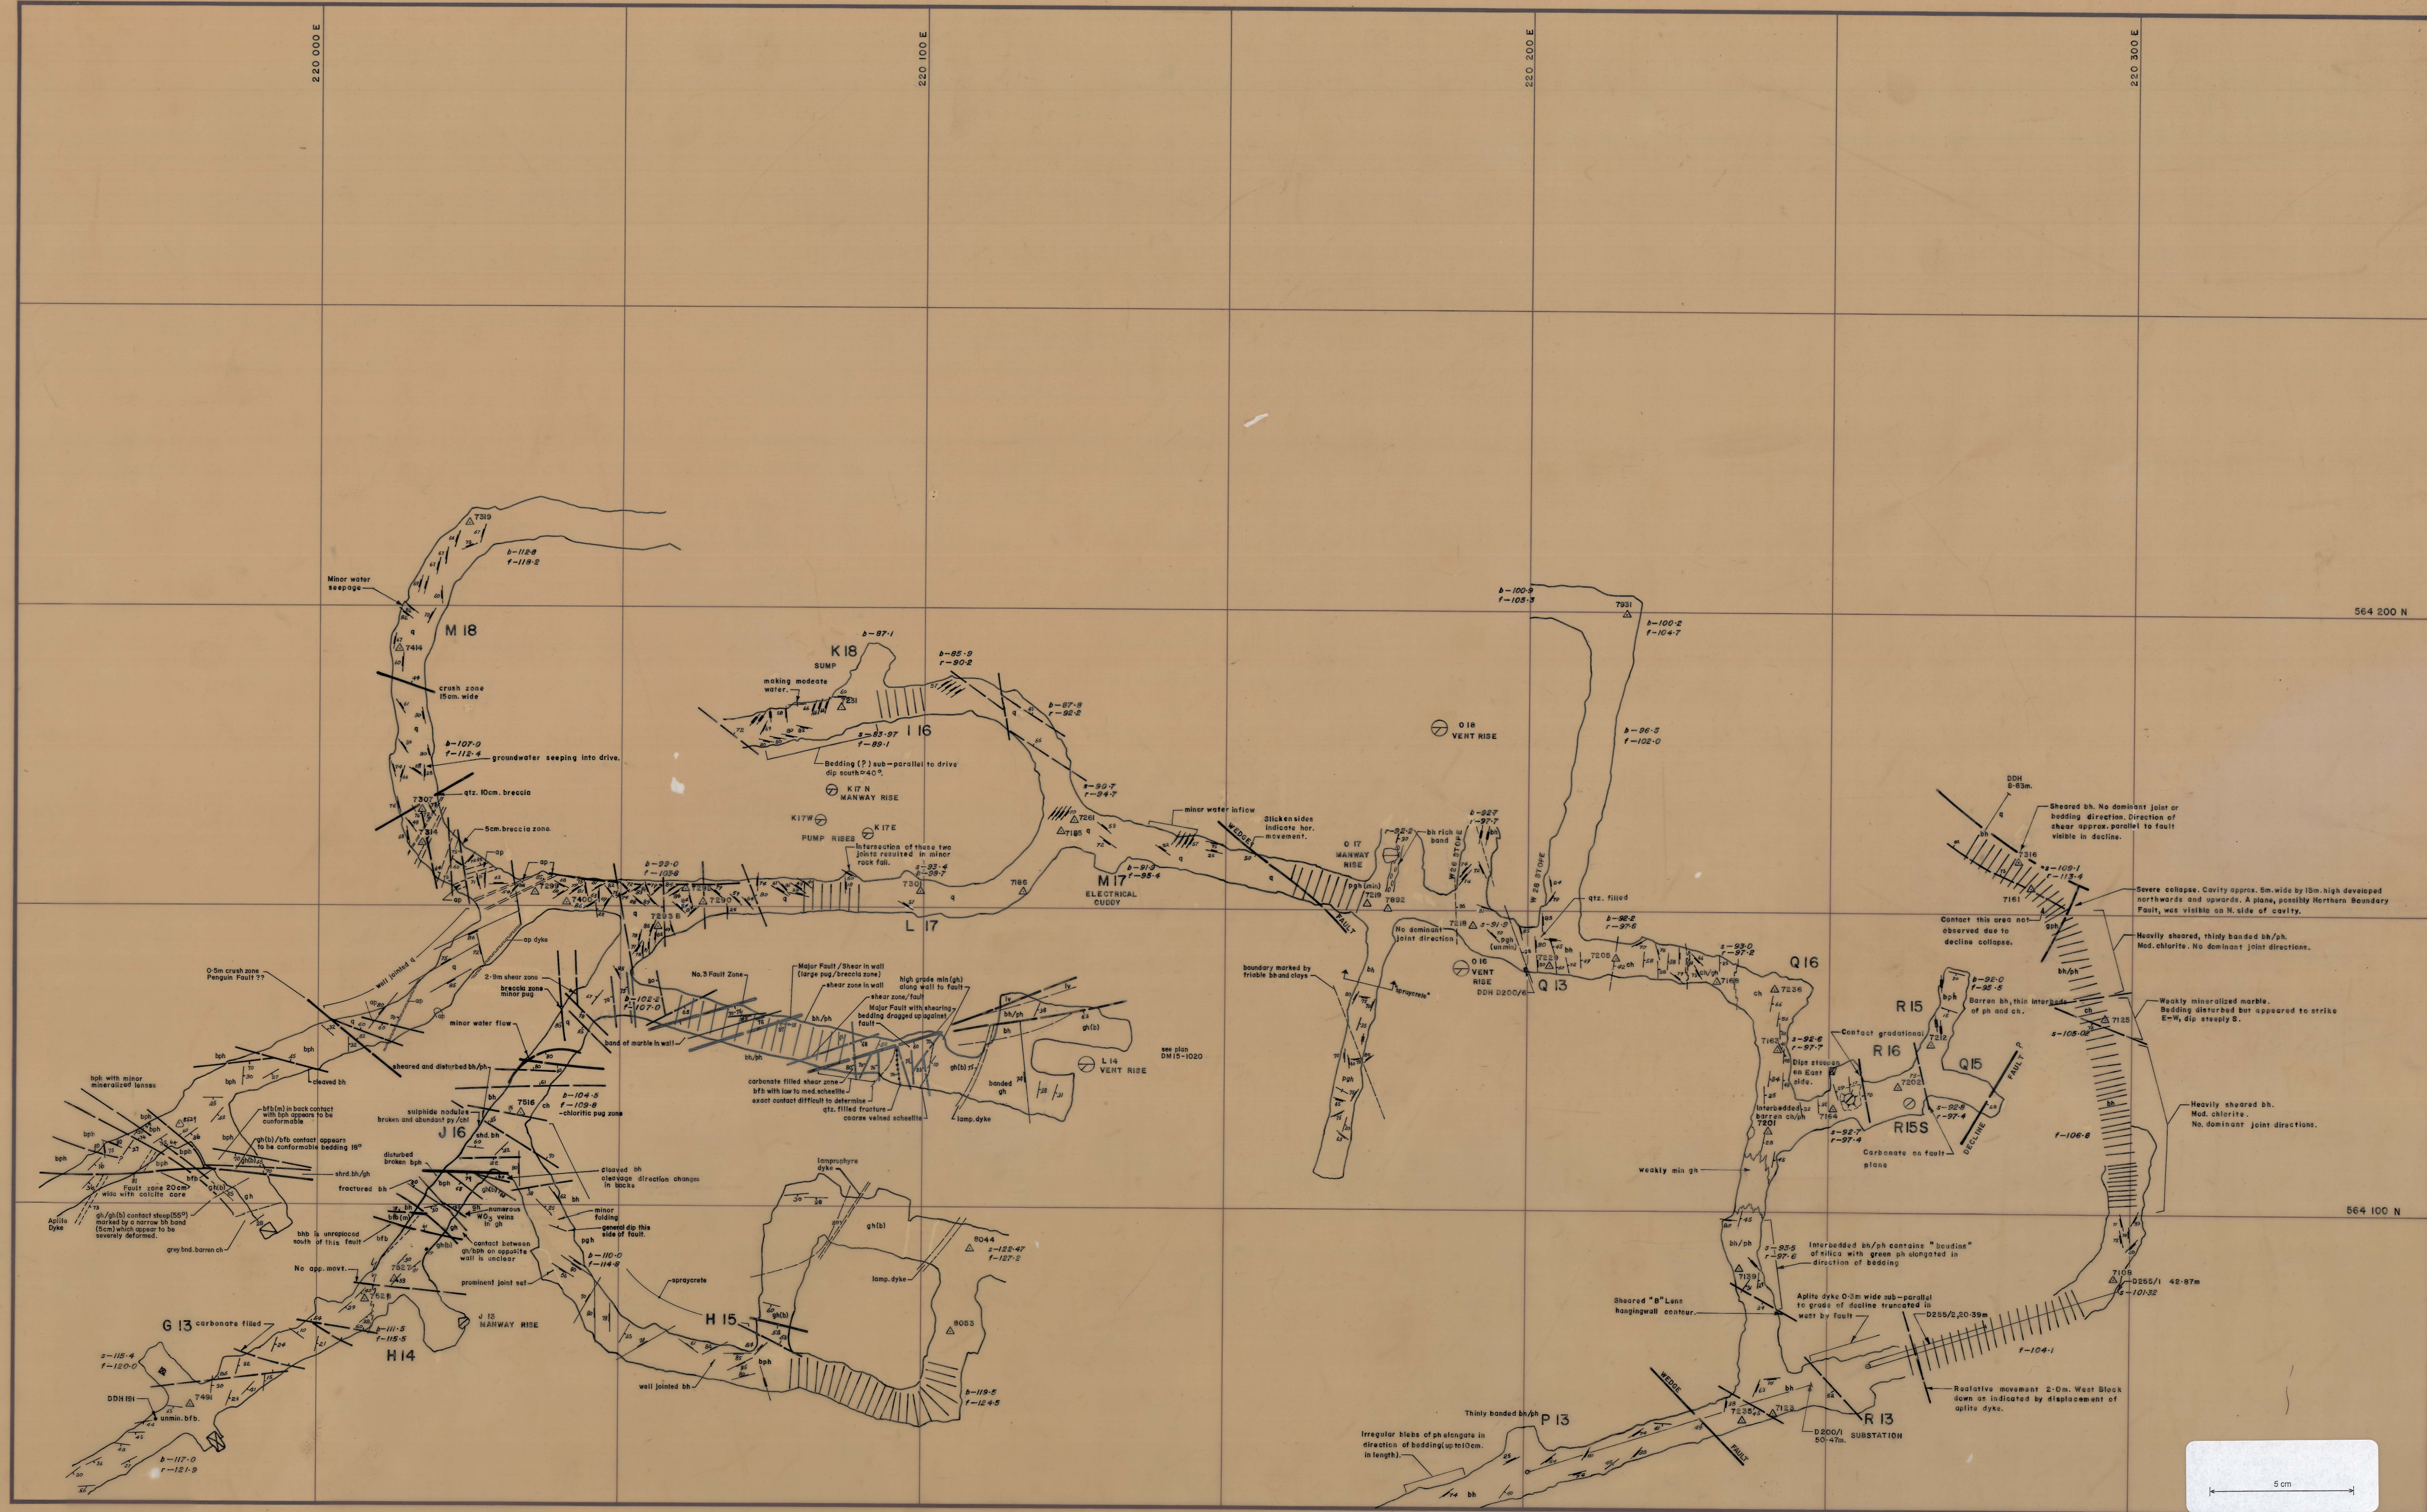

LEGEND:

v	Upper metavalcanics	bh/ph	Banded footwall beds	—	strike and dip	—	geological boundary
bh/ph	Banded hornfels	bph	Biotite pyroxene hornfels	—	strike and dip vertical	—	minor fault
ch	Marble	lv	Lower metavalcanics	—	joint	—	major fault
bh	Biotite hornfels	q	Quartzite	—	joint vertical	b	back
pgh	Pyroxene garnet hornfels	ap	Aplite	—	unconformity	f	floor
gh	Garnet hornfels	gr	Granite	—	relative movement	r	road
				—	rise extending through level	s	spad
				—	head of rise		
				—	foot of rise		
				—	survey station		

GEOPEKO KING ISLAND BASE
A DIVISION OF PEKO-WALLSEND OPERATIONS LTD.

DATE: JAN 79
DRAWN: MvdS.
GEOLOGY:
CHECKED:

DWG. No. KG04DM14-1003

DOLPHIN MINE
-100m R.L. ZONE
F=87m to B=112m

0374_1296