


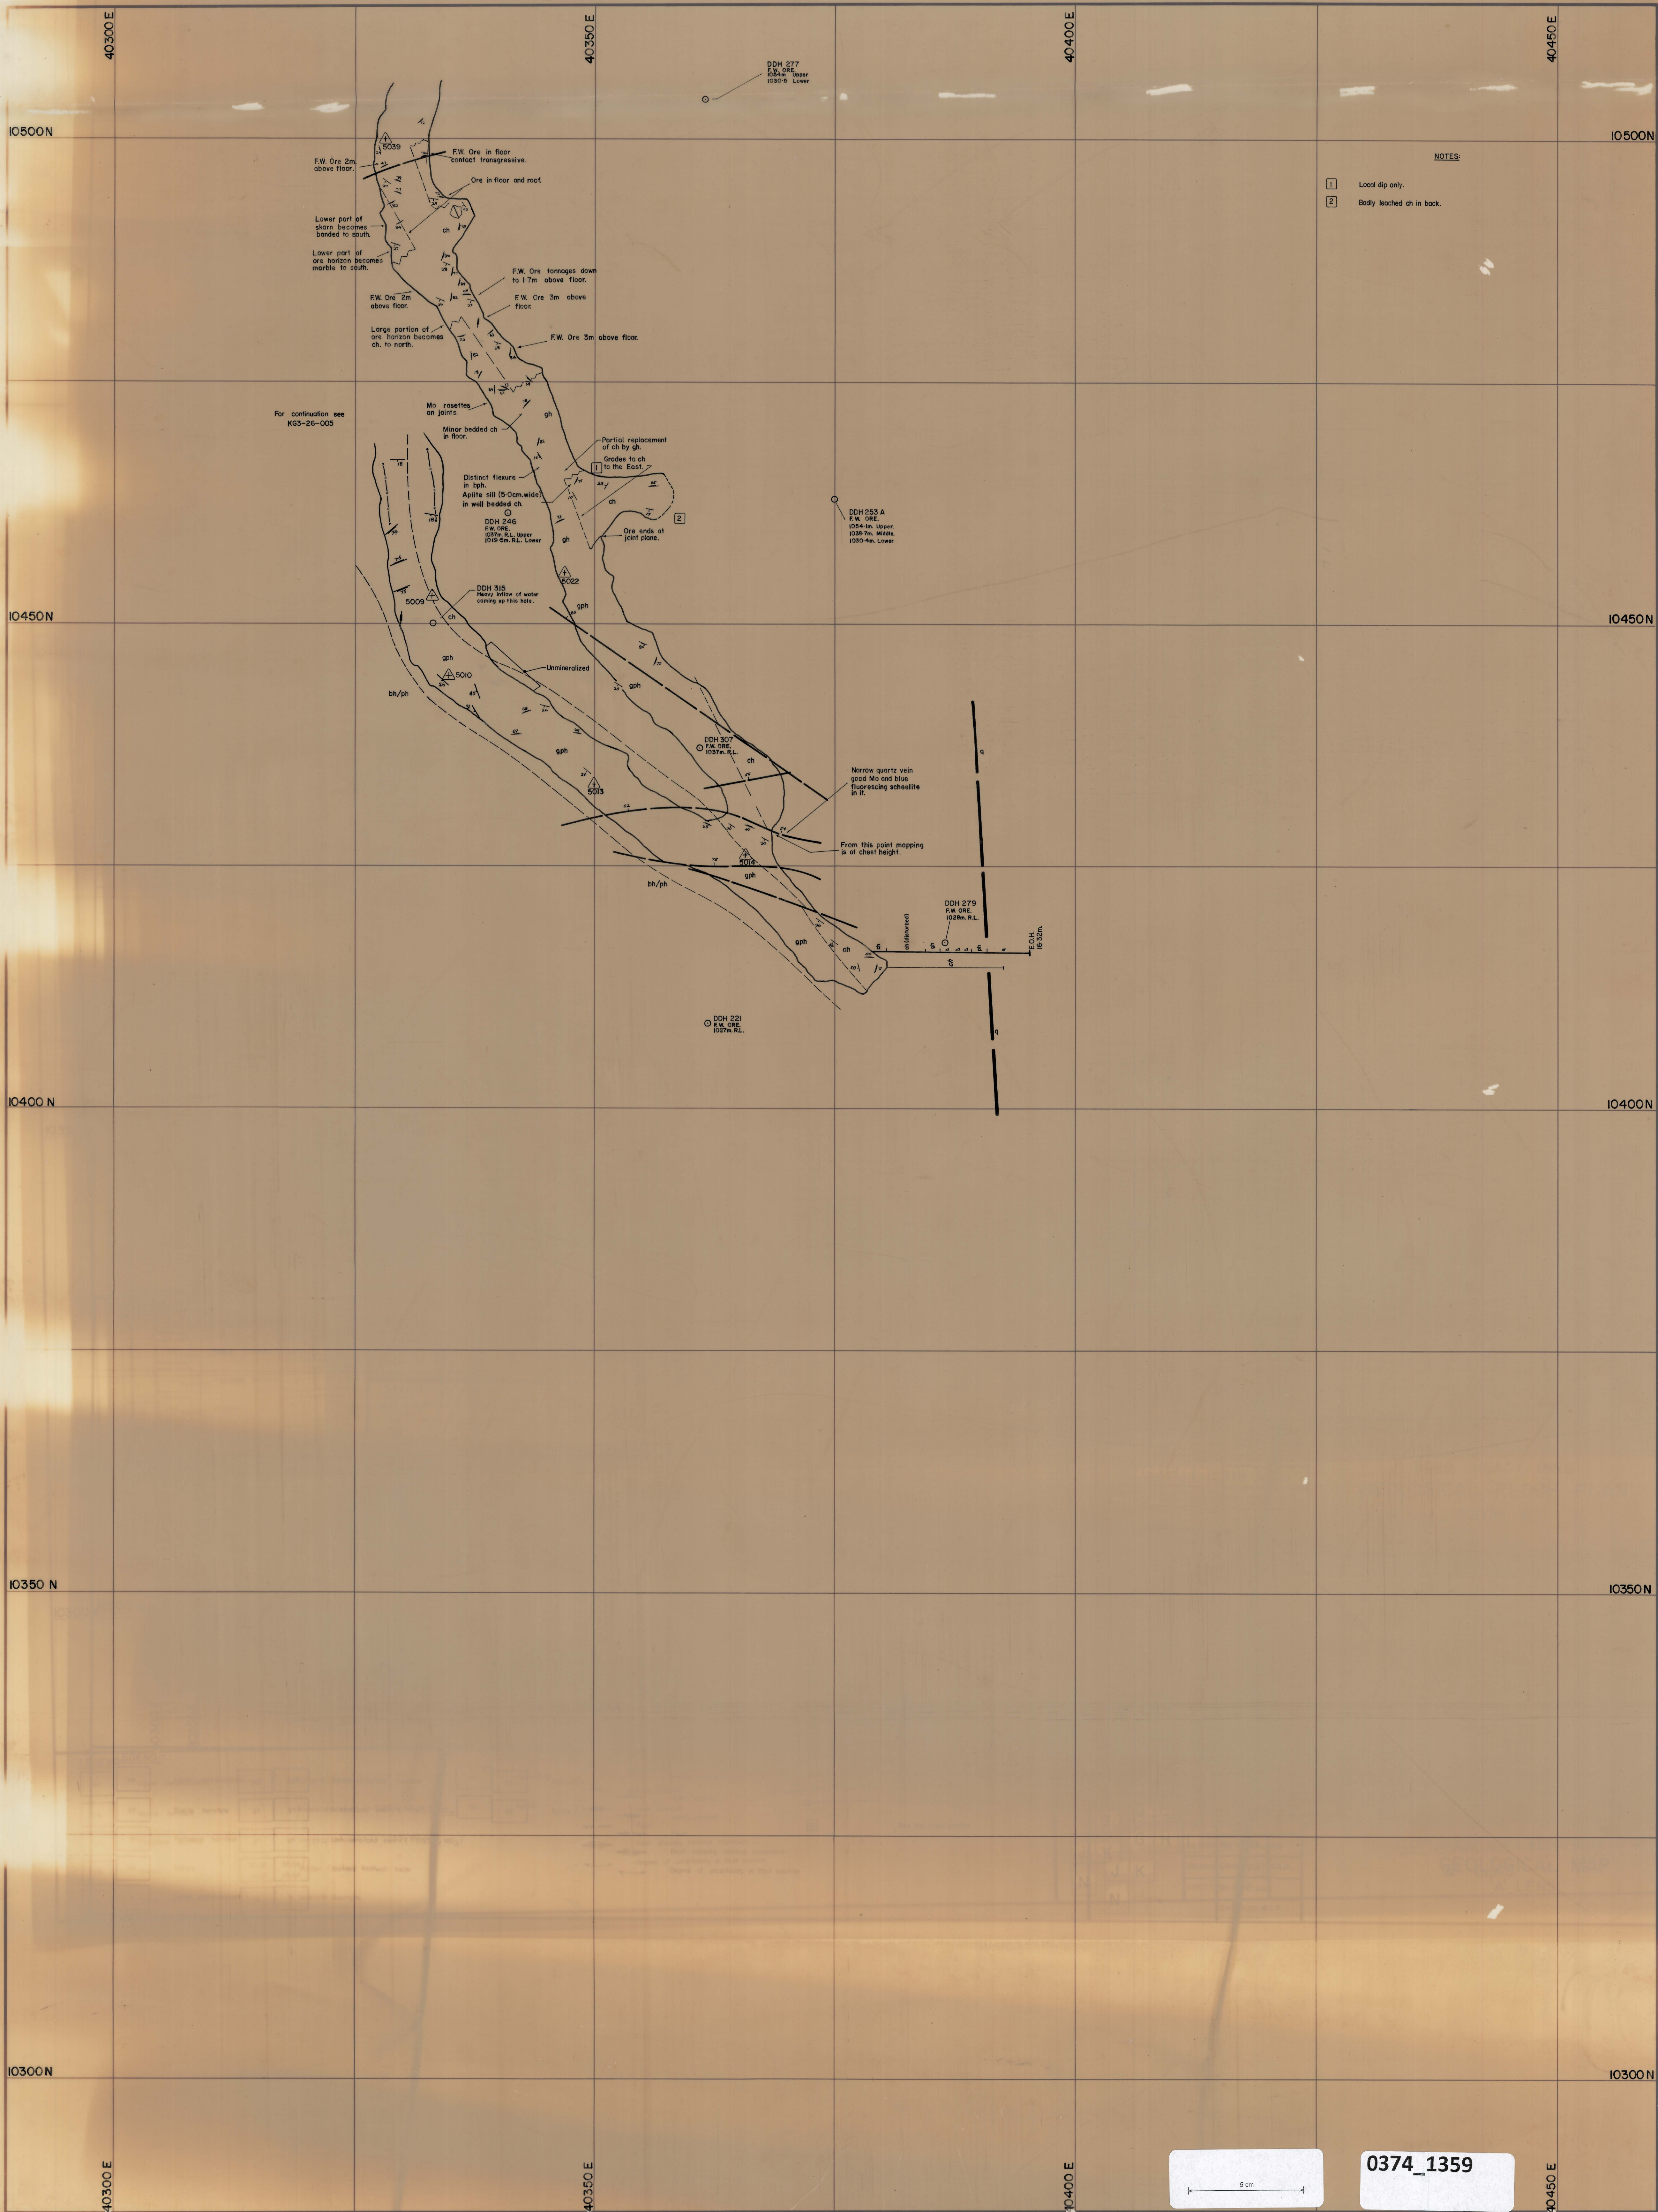

NOTES:
1 Lost dip only.
2 Badly leached ch in back.

LEGEND:

uv

Upper metatolitics

pg

Pyroxene garnet hornfels

ad

Adamellite

ap

Aplitic

60

Strike and dip

55

Joint, inclined

50

Joint, vertical

45

Fault

40

Fault showing relative movement

35

Degree of uncertainty in fault position

30

25

20

15

10

5

ph, gh

PDH (Percussion Drill Hole) with inferred geology.

DDH (Diamond Drill Hole)

A B C

D E F

G H I

J K

N

DATE: NOV, 1975

GEOLOGIST: S.G.B.

DRAWN: A.H.

CHECKED: M.C.R.

5 cm

GEOPEKO LIMITED
KING ISLAND GROUP

SCALE: 1" = 250m

No. K93-261-001

BOLD HEAD MINE
GEOLOGICAL MAP
"A" LENS