


493-251-015
251
1038-1041m R.L.


0374_1390

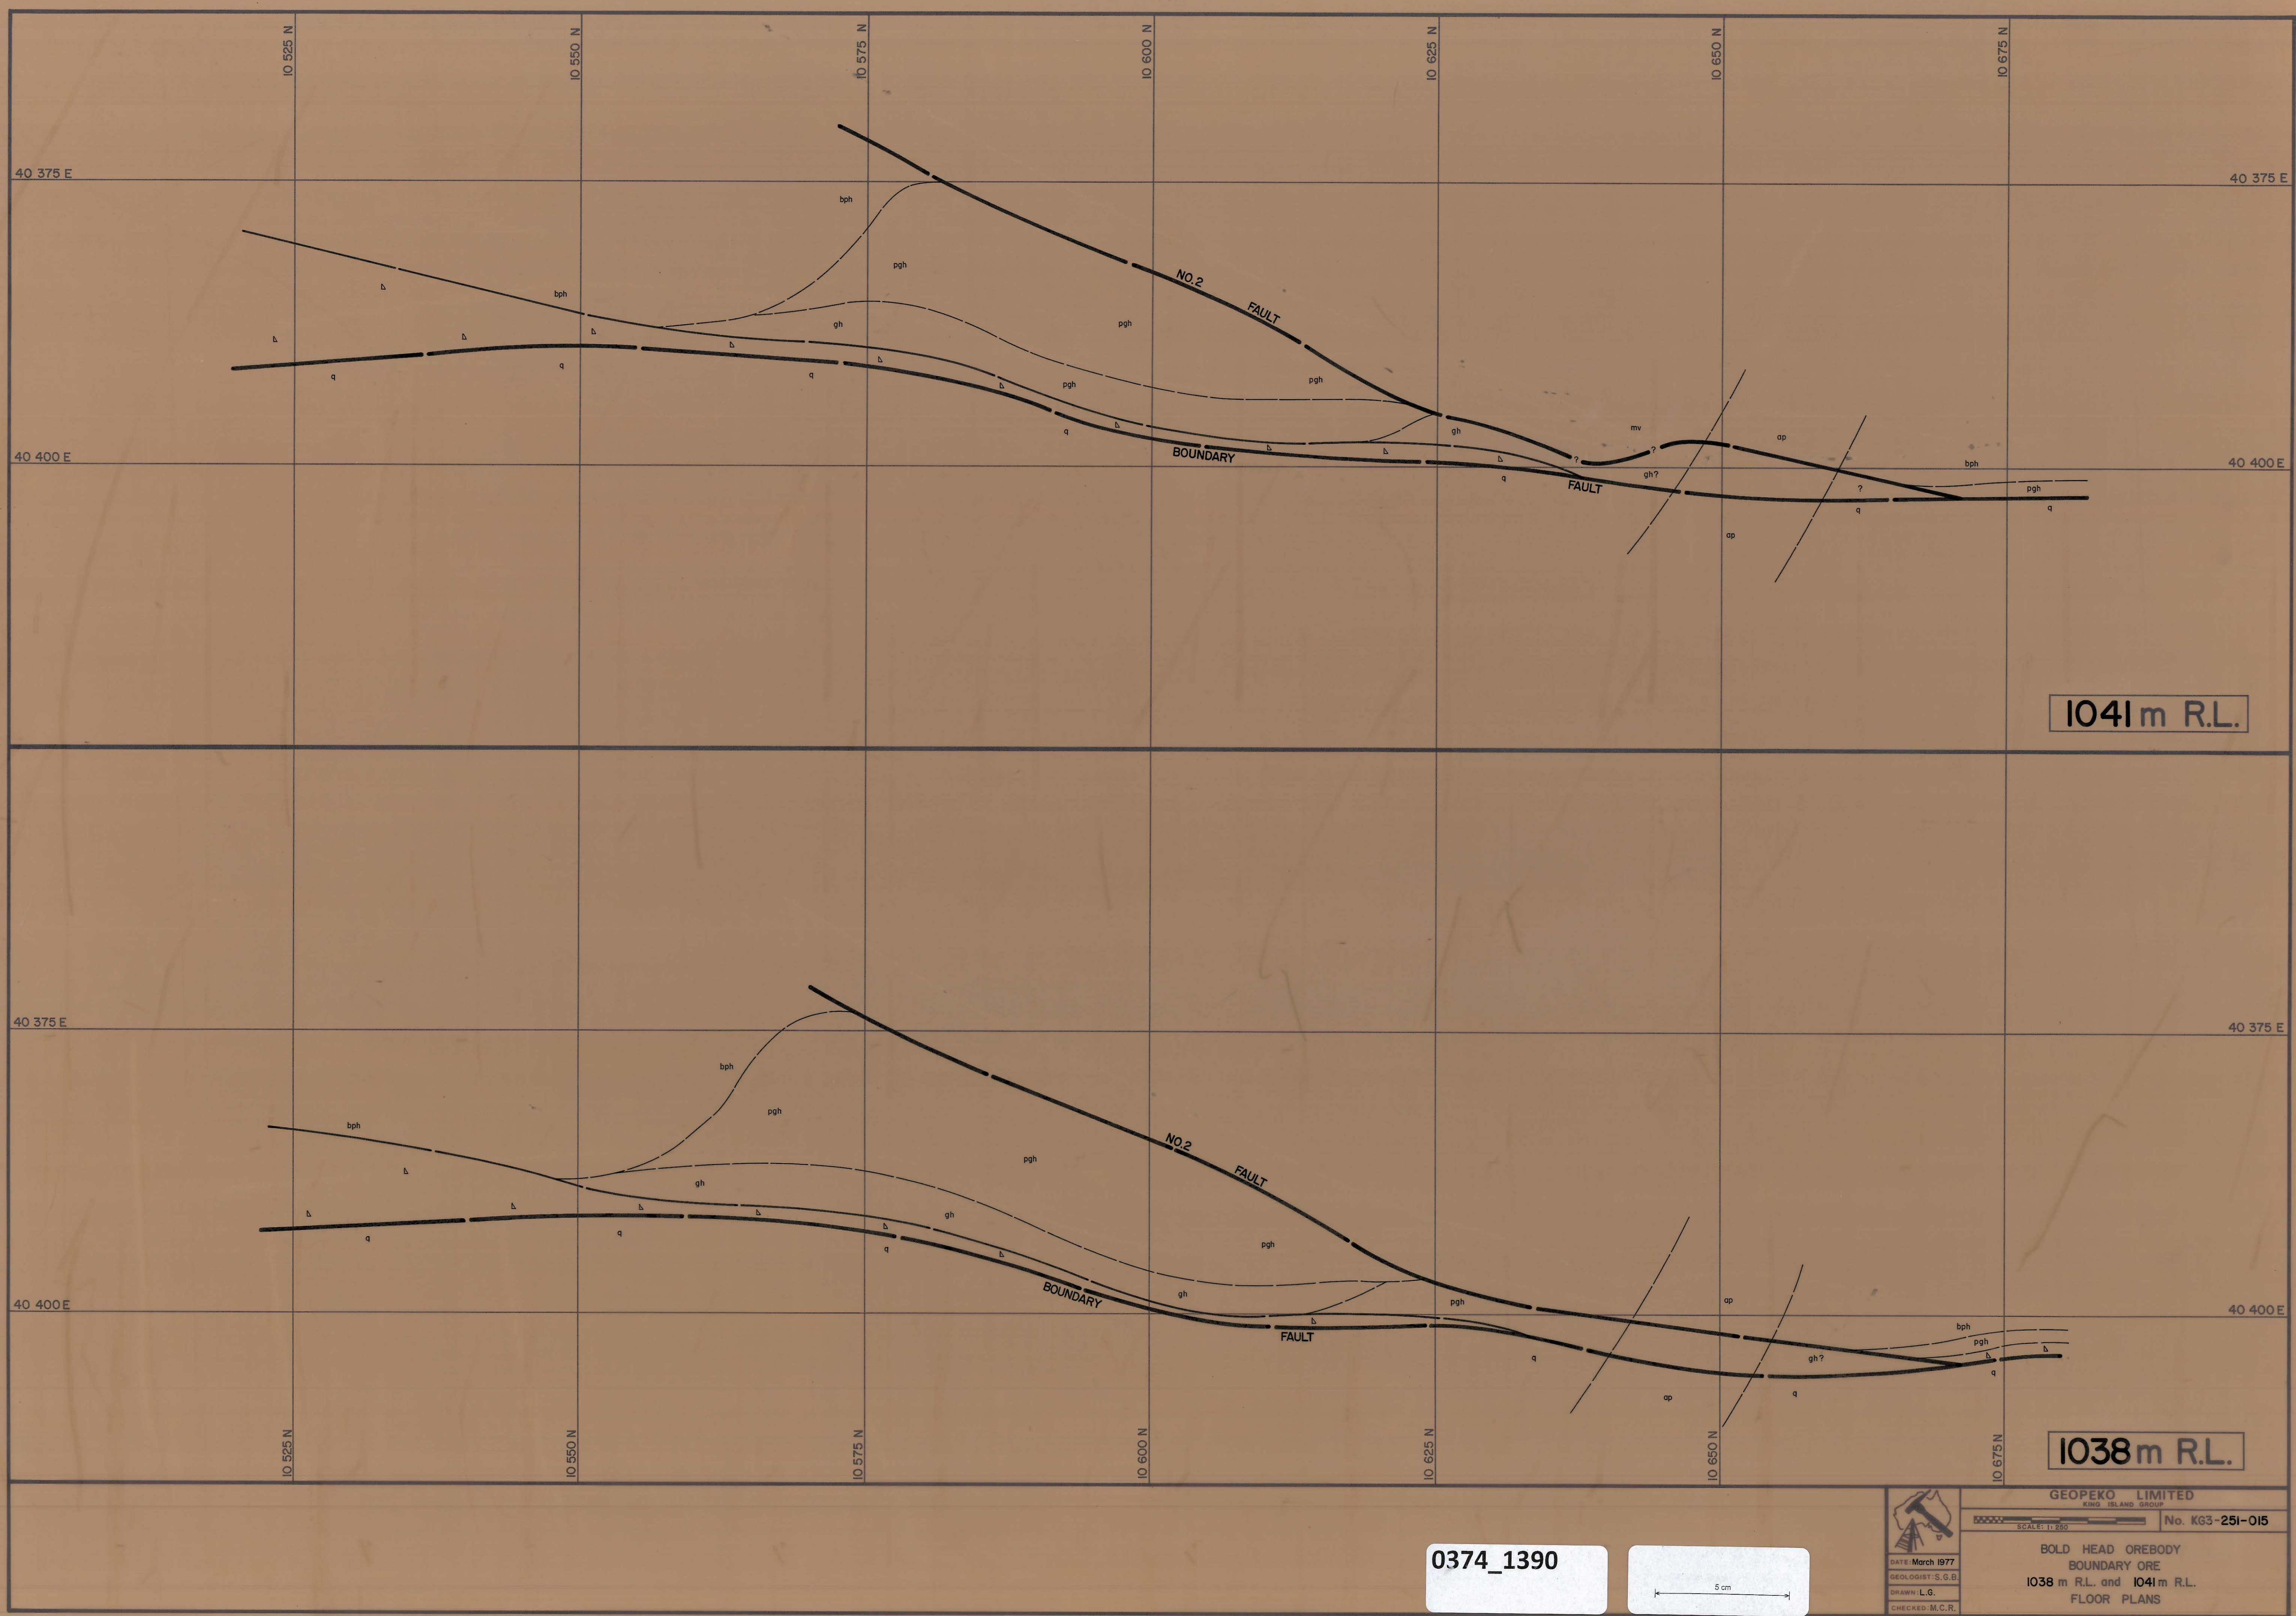

1041m R.L.

1038m R.L.

0374_1390

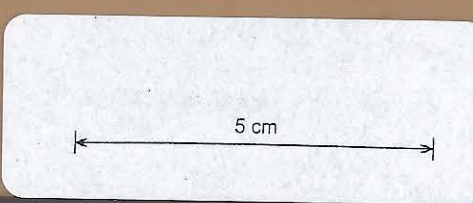

	GEOPEKO LIMITED KING ISLAND GROUP	
	No. KG3-251-015	
	SCALE: 1:250	
	BOLD HEAD OREBODY BOUNDARY ORE 1038 m R.L. and 1041 m R.L. FLOOR PLANS	

DATE: March 1977
GEOLOGIST: S.G.B.
DRAWN: L.G.
CHECKED: M.C.R.