



NOTES:

- 1 gh to roof
- 2 gh 1.70m.
ch 1.10m.
gh
- 3 calcite filled fault plane
214/variable dip
- 4 gh 1.7m.
ch 1.0m.
gh
- 5 gh 1.8m.
ch 1.4m.
gh
- 6 gh 1.7m.
ch 1.0m.
gh
- 7 gh 1.5m.
ch 0.6m.
gh
- 8 gh 1.4m.
ch
- 9 aplite in back
gh 2.10m.
ch
- 10 gh 1.0m.
ch
- 11 gh 0.9m.
ch

LEGEND:

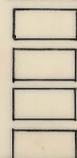

0374_1396

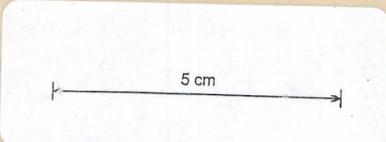

GEOPEKO LIMITED — KING ISLAND
 SCALE: 1:250 No. KG3-262-003/004

Date: May 77
 Geol: R.B.
 Dwn: C.T.
 Chkd: M.C.R.

**BOLD HEAD OREBODY
 FLOOR PLAN
 E53 DRIVE B LENS WEST**