


193-24-012
24 40373 E

0374_1467

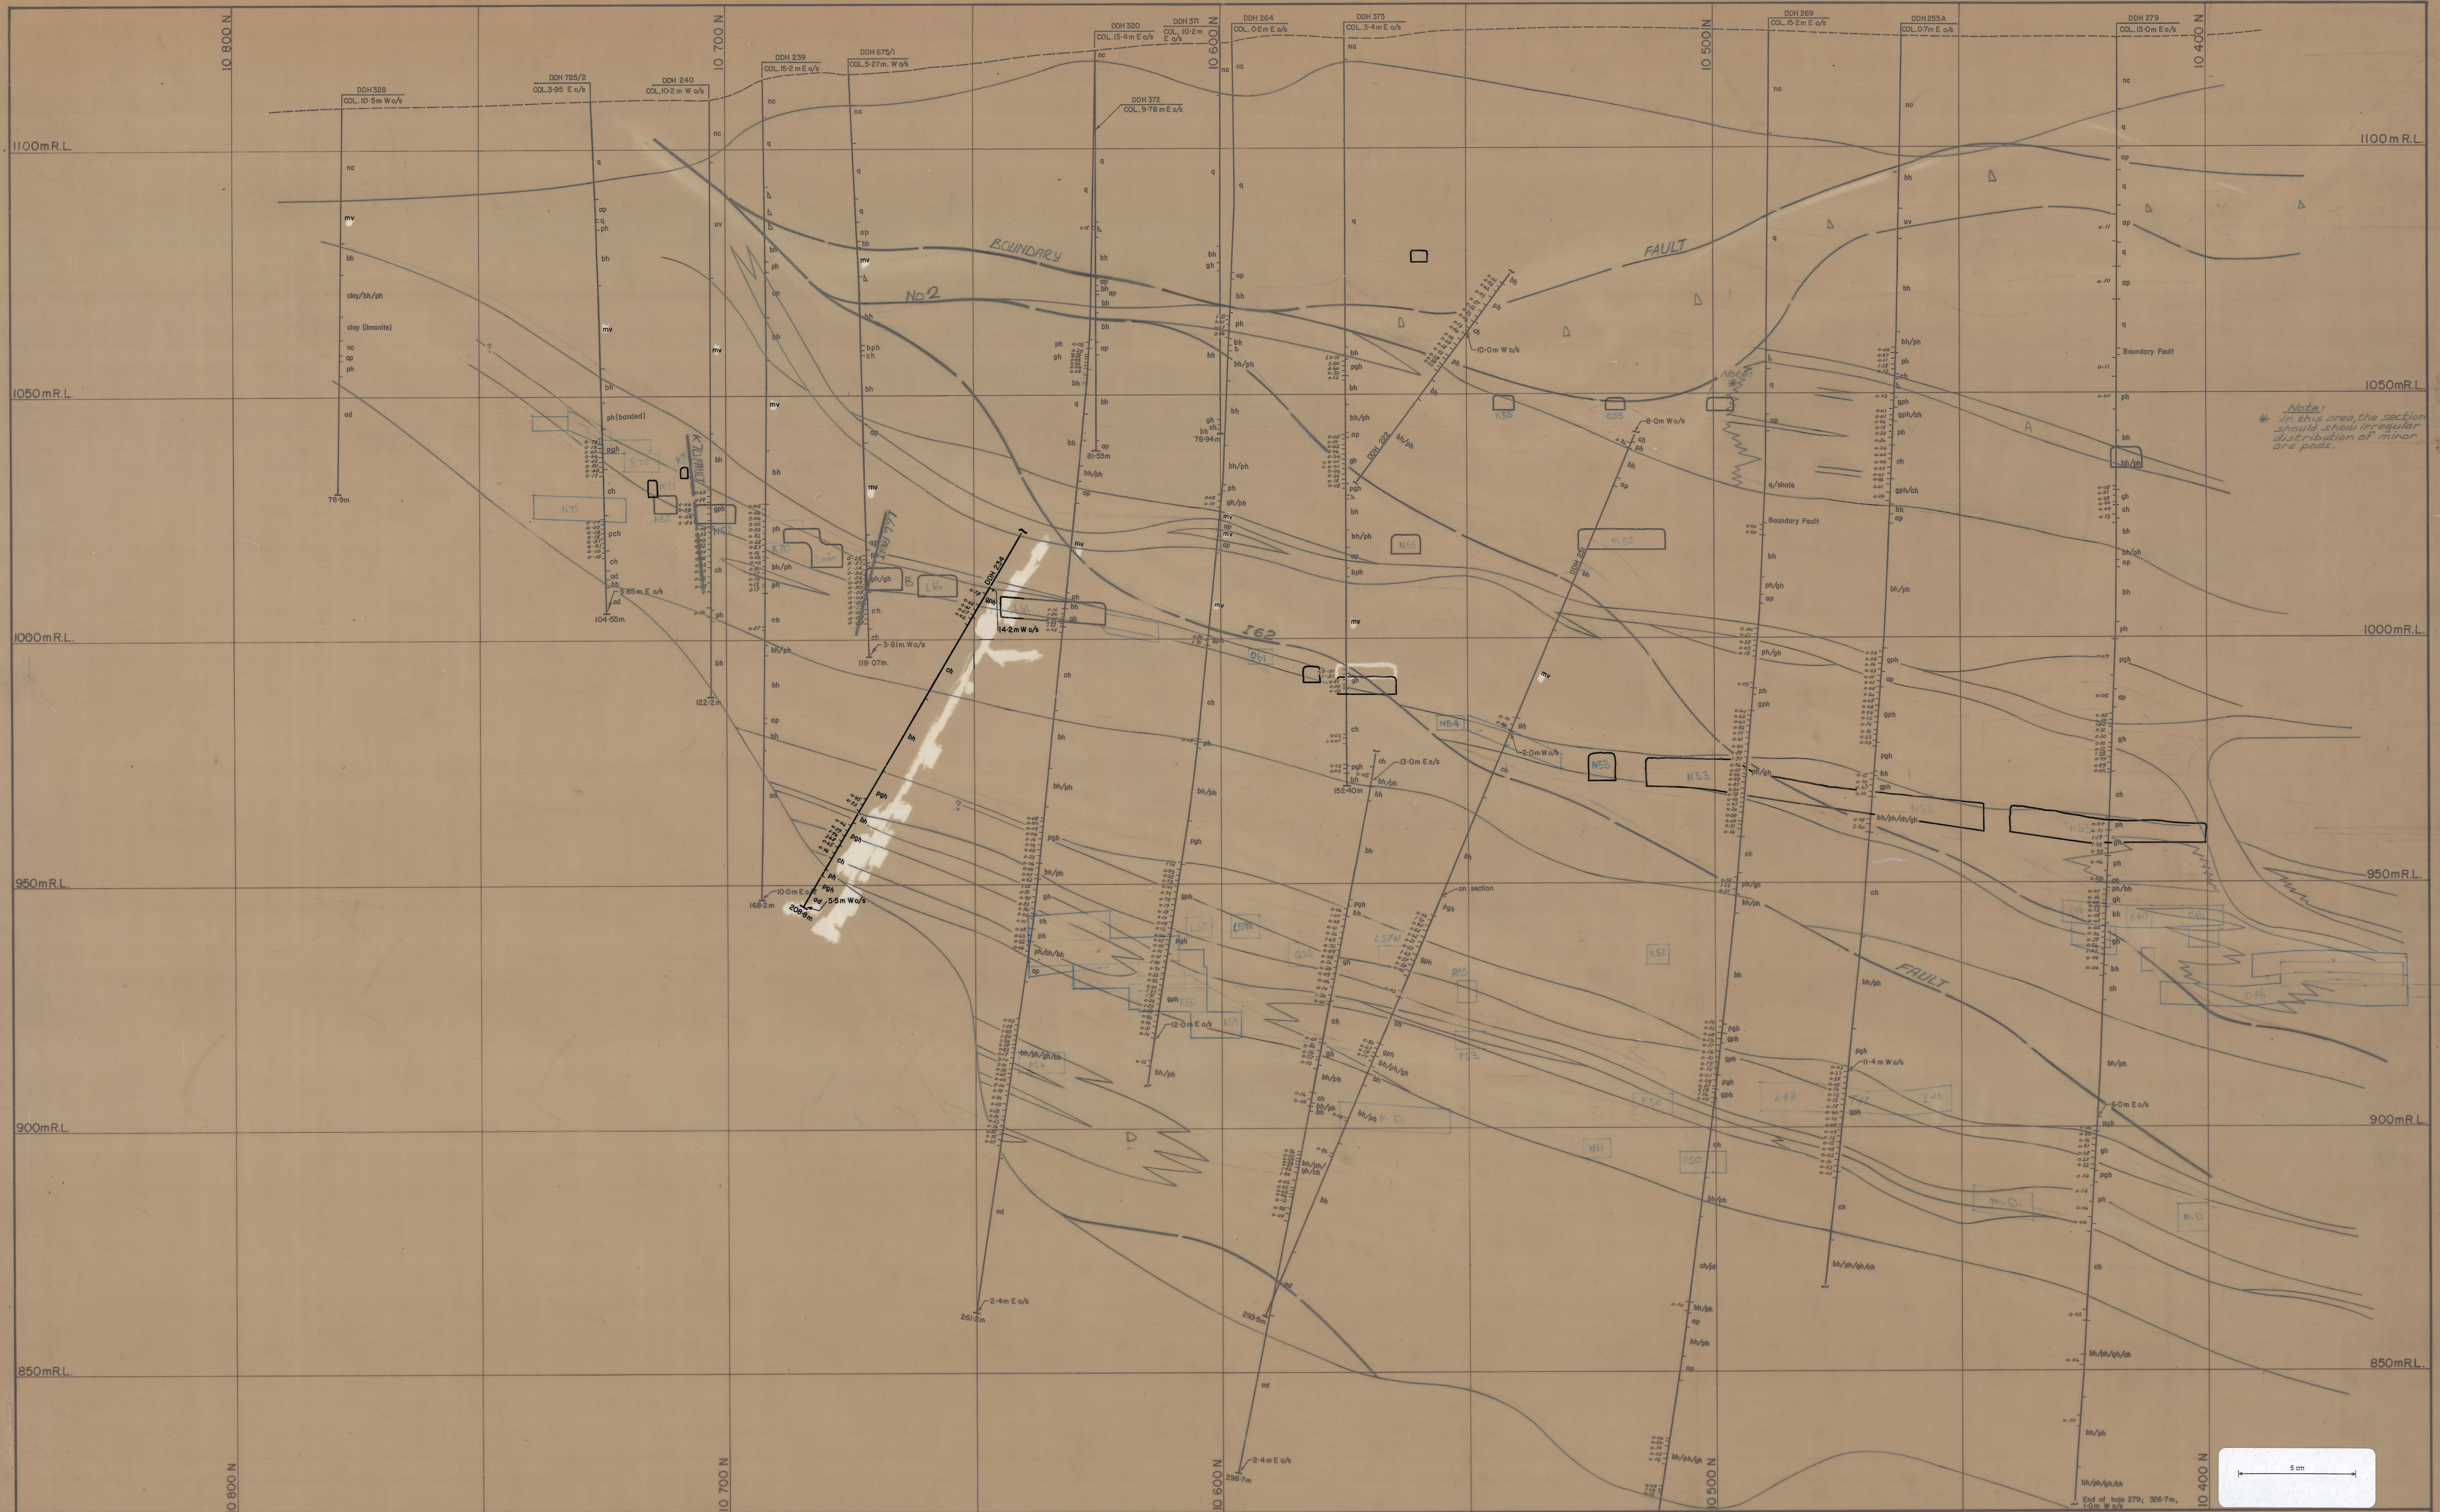

Legend:

uv	Upper metavolcanics	pgh	Pyroxene garnet hornfels	ad	Adamellite	bbb	Breccia
bh	Biotite hornfels	gh	Mineralized skarn (>0.25% WO ₃)	ap	Aplite	— —	Fault showing relative movement
ph	Pyroxene hornfels	gh	Unmineralized skarn (<0.25% WO ₃)			— —	Degree of uncertainty in fault position
ch	Marble	bh/ph	Banded footwall beds	C ₁	Ore lens designer	±	Figures refer to assay results in % WO ₃
lv	Lower metavolcanics	q	Quartzite			∠	Angle of bedding to long axis of core
						nc	No core recovered

DDH 479
COL. 8.3m E a/s

Indicates collar location as being 5.3 metres East of section

7.1m E a/s

Indicated point is 7.1 metres East of section

GEOPEKO LIMITED
KING ISLAND GROUP

SCALE: 1:500

No. KG3-24-012

BOLD HEAD OREBODY
GEOLOGICAL LONG SECTION

40 375 E

DATE: AUG, 1975
GEOLOGIST: S.B.B.
DRAWN: O.S.
CHECKED: M.C.R.

0374_1467

Note:
In this area, the section
should show irregular
distribution of minor
ore pods.