'C' LENS EXTRACTION

	WEDGE		CENTRAL		PIT		PIT DAG		SOUTHERN		DECLINE	TOTAL	
	53,521	1·11	16,863	1·17	3,604	0·85	NIL		NIL		NIL	73,988	1·11
	11,756	0·74	NIL		32,207	0·53	NIL		NIL		NIL	43,963	0·59
	65,277	1·04	16,863	1·17	35,811	0·56	NIL		NIL		NIL	117,951	0·92
-75													
	47,339	1·01	9,097	1·22	NIL		NIL		NIL		NIL	56,436	1·04
	47,222	0·75	NIL		10,280	0·48	NIL		NIL		NIL	57,502	0·70
	94,561	0·88	9,097	1·22	10,280	0·48	NIL		NIL		NIL	113,938	0·87
-100													
	191,522	1·07	62,226	1·04	32,861	0·64	NIL		NIL		NIL	286,609	1·01
	156,866	0·72	80,847	0·66	35,632	0·56	NIL		NIL		NIL	273,345	0·68
	348,388	0·91	143,073	0·83	68,493	0·60	NIL		NIL		NIL	559,954	0·85
-125													
	13,800	1·13	30,624	1·09	92,393	0·99	NIL		NIL		NIL	136,817	1·03
	4,505	0·61	103,254	0·75	62,931	0·67	NIL		NIL		NIL	170,690	0·72
	18,305	1·00	133,878	0·83	155,324	0·85	NIL		NIL		NIL	307,507	0·85
-150													
	7,392	1·41	NIL		1,981	1·58	NIL		NIL		NIL	9,373	1·45
	7,350	0·63	4,169	0·55	22,416	0·68	13,333	0·57	857	0·76	NIL	48,125	0·63
	14,742	1·02	4,169	0·55	24,397	0·75	13,333	0·57	857	0·76	NIL	57,498	0·76
-200													
	34,514	1·29	NIL		19,693	1·08	NIL		NIL		NIL	54,207	1·21
	31,528	0·77	53	0·51	76,838	0·63	NIL		NIL		NIL	108,419	0·67
	66,042	1·04	53	0·51	96,531	0·72	NIL		NIL		NIL	162,626	0·85
TOTAL	348,808	1·10	118,810	1·09	150,532	0·93	NIL		NIL		UPPER "C":	617,430	1·06
	259,227	0·73	188,323	0·71	240,304	0·61	13,333	0·57	857	0·76	LOWER "C":	702,044	0·68
	607,315	0·94	307,133	0·86	390,836	0·73	13,333	0·57	857	0·76	TOTAL:	1,319,474	0·86

'B' LENS EXTRACTION

	NIL		NIL		NIL		NIL		NIL		NIL	NIL	
-50													
	4,134	0·37	3,022	0·47	4,370	0·43	NIL		4,809	0·34	1,388	0·42	17,723	0·40

(Figures adjusted to mill weightometer)

KING ISLAND SCHEELITE

UNDERGROUND TECHNICAL SERVICES

EXTRACTION TABLE

1 - 2 - 81

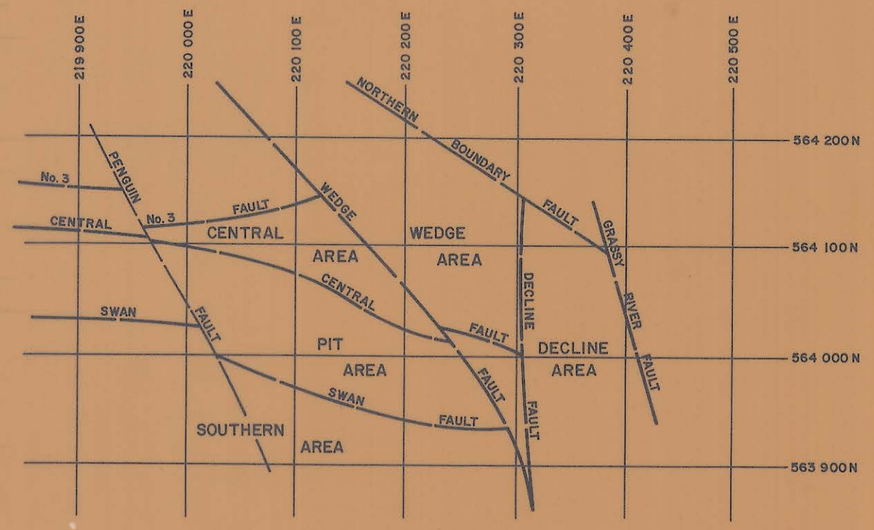

DOLPHIN EXTRACTION SUMMARY

ORE MINED: C LENS

UPPER C	617,430	TONNES at 1·06	$\%WO_3$
LOWER C	702,044	TONNES at 0·68	$\%WO_3$
TOTAL C LENS	1,319,474	TONNES at 0·86	$\%WO_3$

ORE MINED: B LENS 17,723 TONNES at 0·40 $\%WO_3$

TOTAL ORE MINED: 1,337,197 TONNES at 0·85 $\%WO_3$

5 cm

COMPILED BY: I.D.H.
DRAWN BY: R.F.
CHECKED BY: S.G.B.
DATE: APR., 1981

DOLPHIN EXTRACTION APRIL 1981
0374_1489
0374_1489