


A LENS
ORE RESOURCE
30 AUG 77
14 FEB 78

0374_1514

"A" Lens West	
TONNES	
5,080	
2,570	
50	
TOTAL	8,700

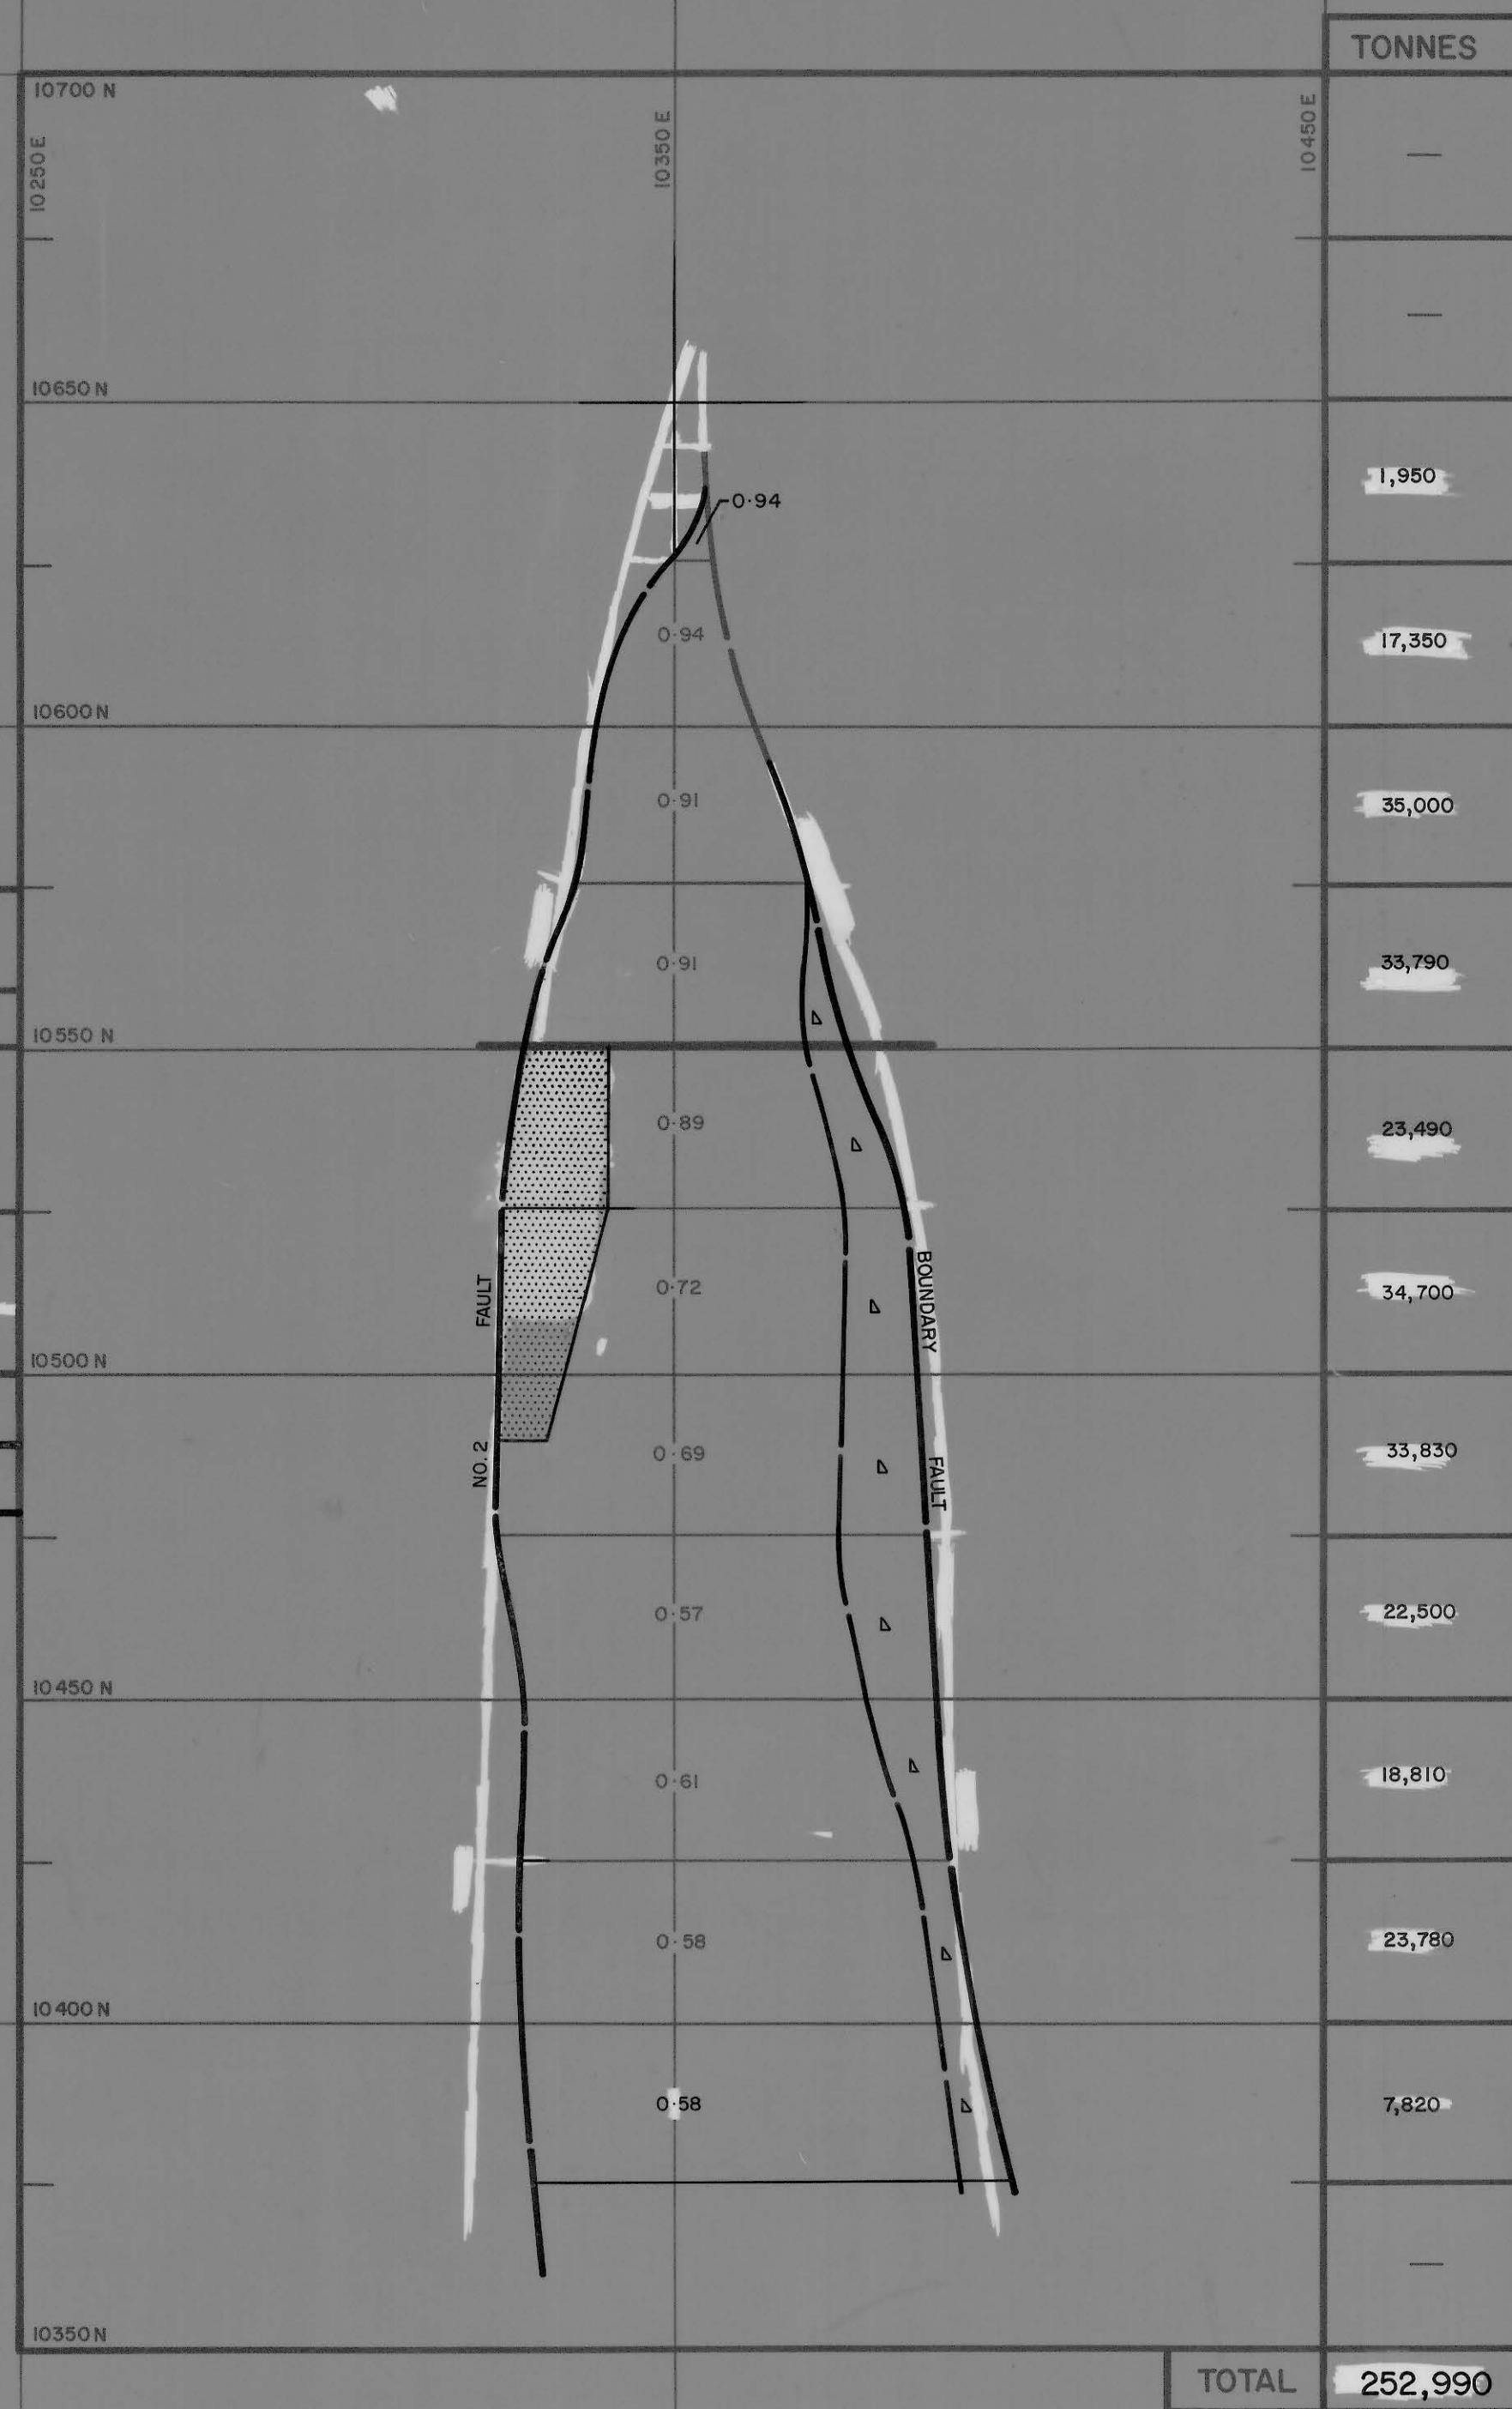

"A" LENS

PROVEN RESOURCE:

A LENS NORTH 88,090 TONNES at 0.92% WO₃

A LENS WEST 8,700 TONNES at 0.84% WO₃

TOTAL PROVEN ORE: 96,800 TONNES at 0.91% WO₃

PROBABLE RESOURCE:

A LENS SOUTH 164,900 TONNES at 0.68% WO₃


TOTAL "A" LENS RESOURCE: 261,700 TONNES at 0.77% WO₃

POSSIBLE ORE 20,000 TONNES

0374_1514

5 cm

NOTE:
1. 252,990 indicates PROVEN RESOURCE.
2. RESOURCE AS AT 14 FEB 78.

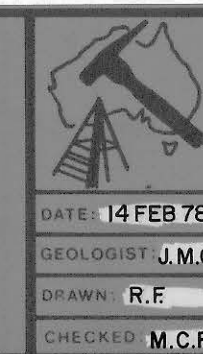

GEOPEKO LIMITED
KING ISLAND GROUP
No. K
SCALE: 1:1000
BOLD HEAD OREBODY
ORE RESOURCE TABLE
A LENS