



0374-1530
0374-1527

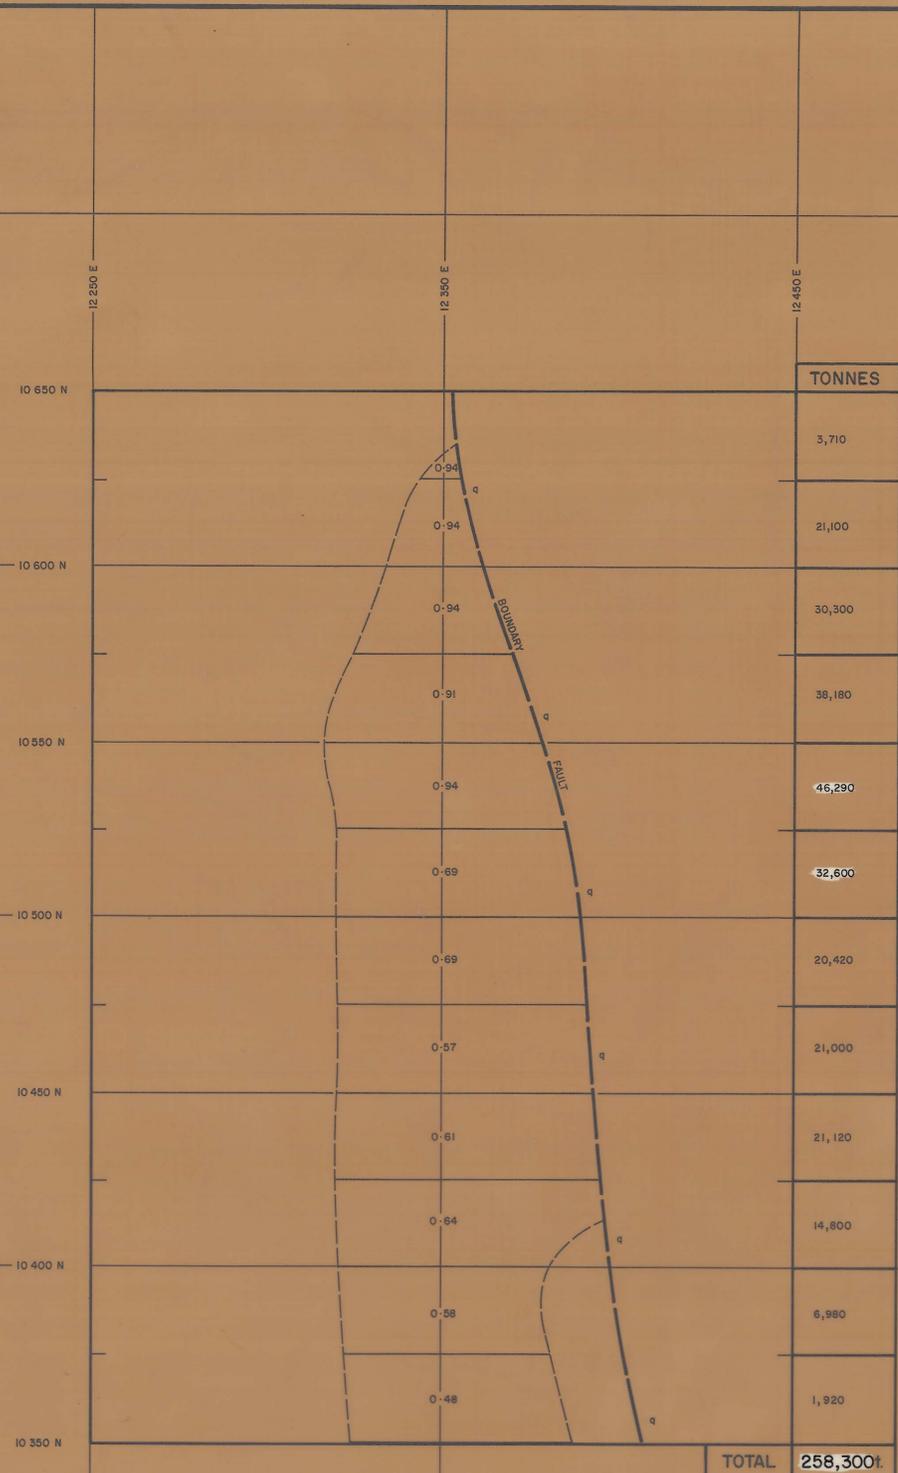

"A" LENS
 Main "A" Lens.....258,300t at 0.79%WO₃
 Lower "A" Lens.....33,400t at 0.84%WO₃
TOTAL: 291,760t at 0.79%WO₃

"B" LENS
PROVEN RESOURCE:
 "B" Lens Fault Block.....210,800t at 0.83%WO₃
PROBABLE RESOURCE:
 Main "B" Lens.....434,900t at 0.88%WO₃
 "B" Lens Fault Block.....247,000t at 0.78%WO₃
 Lower "B" Lens.....29,800t at 0.64%WO₃
711,700t at 0.83%WO₃
TOTAL:
 "B" Lens Resource.....922,500t at 0.83%WO₃

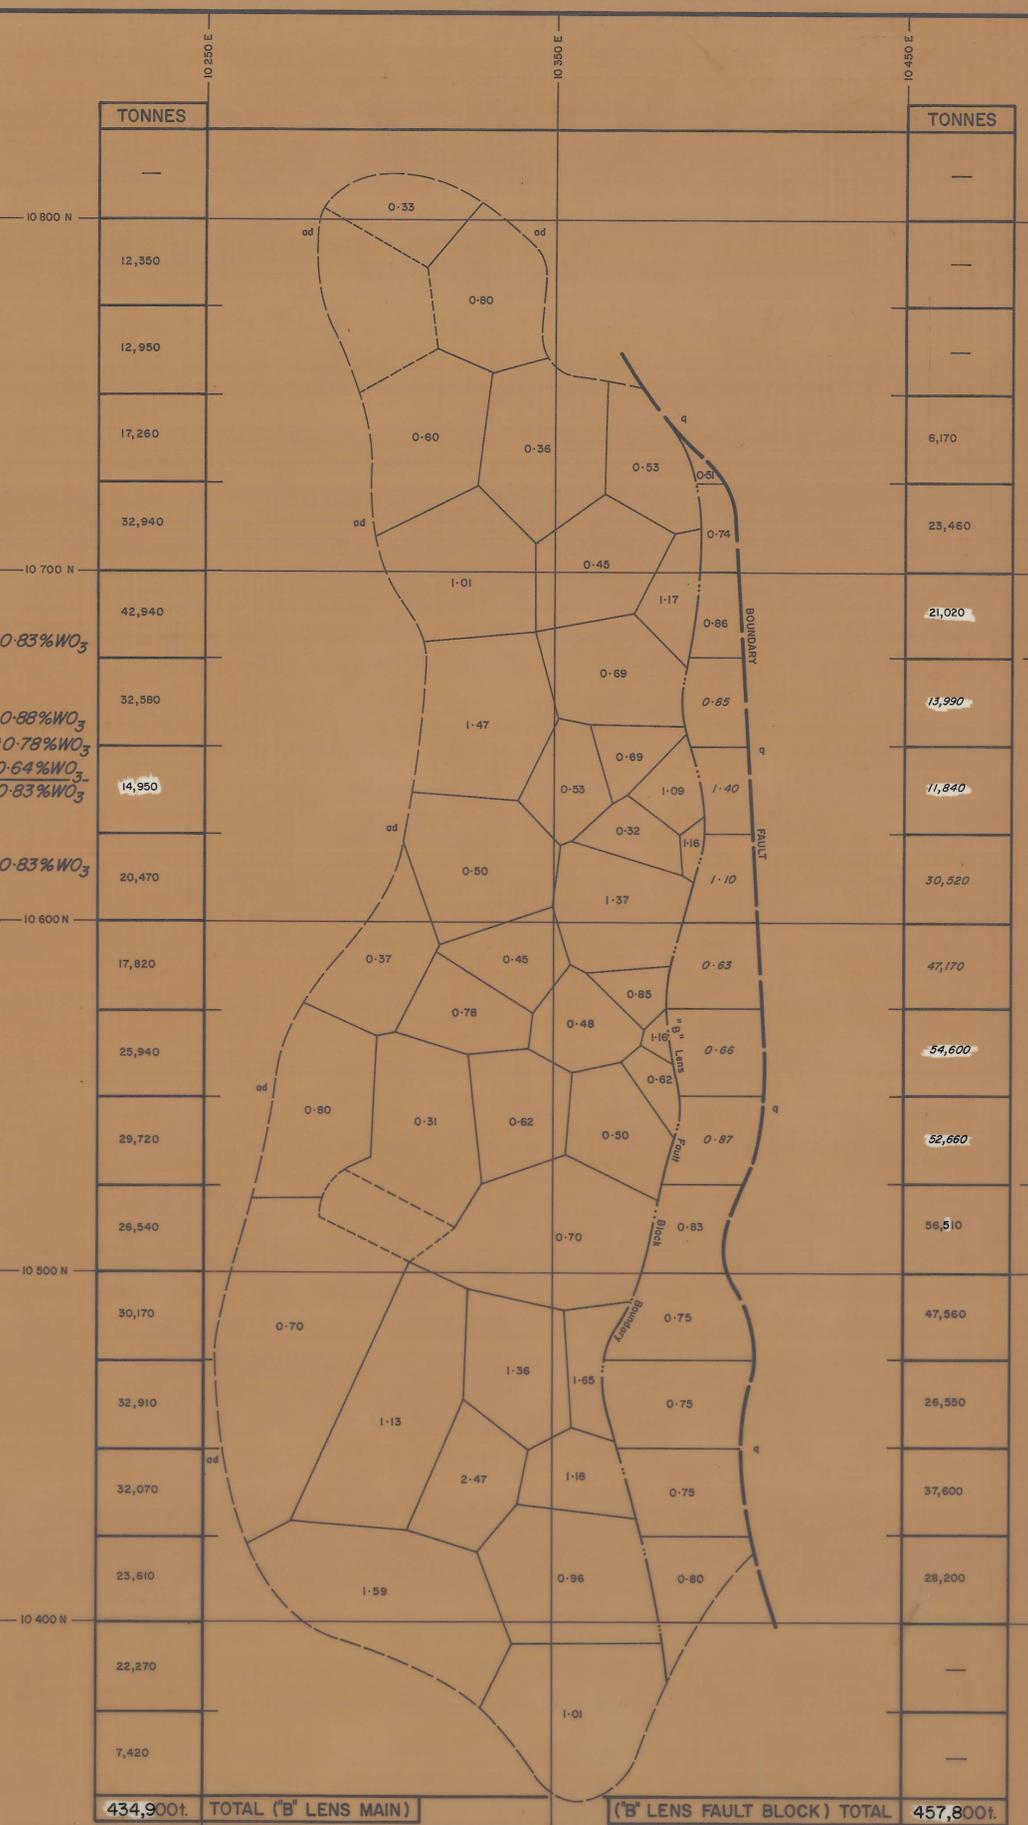

PROVEN RESOURCE
B LENS FAULT BLOCK

(B' LENS FAULT BLOCK) TOTAL 457,800t

NOTE:
RESOURCE AS AT 19/3/75, END PERIOD 9.

GEOPEKO LIMITED
KING ISLAND GROUP
DATE: MAR., 1975
GEOLOGIST: S.G.B.
DRAWN: S.E.
CHECKED: M.C.R.

SCALE 1:1000
No. K
BOLD HEAD OREBODY
ORE RESOURCE TABLES
A and B LENS

0374_1530
0374-1527

