


"B" Lens
Ore Resource
B.Lens
Ore Resource
Ore Resource

0374-1534
0374-1531

"B" Lens West	"B" Lens Main	TONNES		"B" Lens East	"B" Lens Fault Blocks	TONNES	
2,890	—	10 250 E		—	—	10 450 E	
6,260	—			—	—		
1,780	—			—	—		
880	5,280			3,020	—		
5,470	21,280			10,490	—		
5,470	24,790			15,530	—		
2,960	18,960			21,620	—		
2,700	16,080			18,160	—		
3,230	15,250			10,960	4,510		
4,370	14,920			8,700	17,990		
7,190	19,360			2,780	29,540		
6,690	25,130			—	45,280		
2,310	27,230			—	57,570		
2,730	24,020			—	64,260		
5,180	26,670			—	61,600		
6,990	26,130			—	40,370		
9,450	19,130			—	27,060		
3,630	12,390			—	8,470		
—	2,480			—	—		
80,180t.	299,100t.	TOTALS		TOTALS	91,260t.	356,650t.	

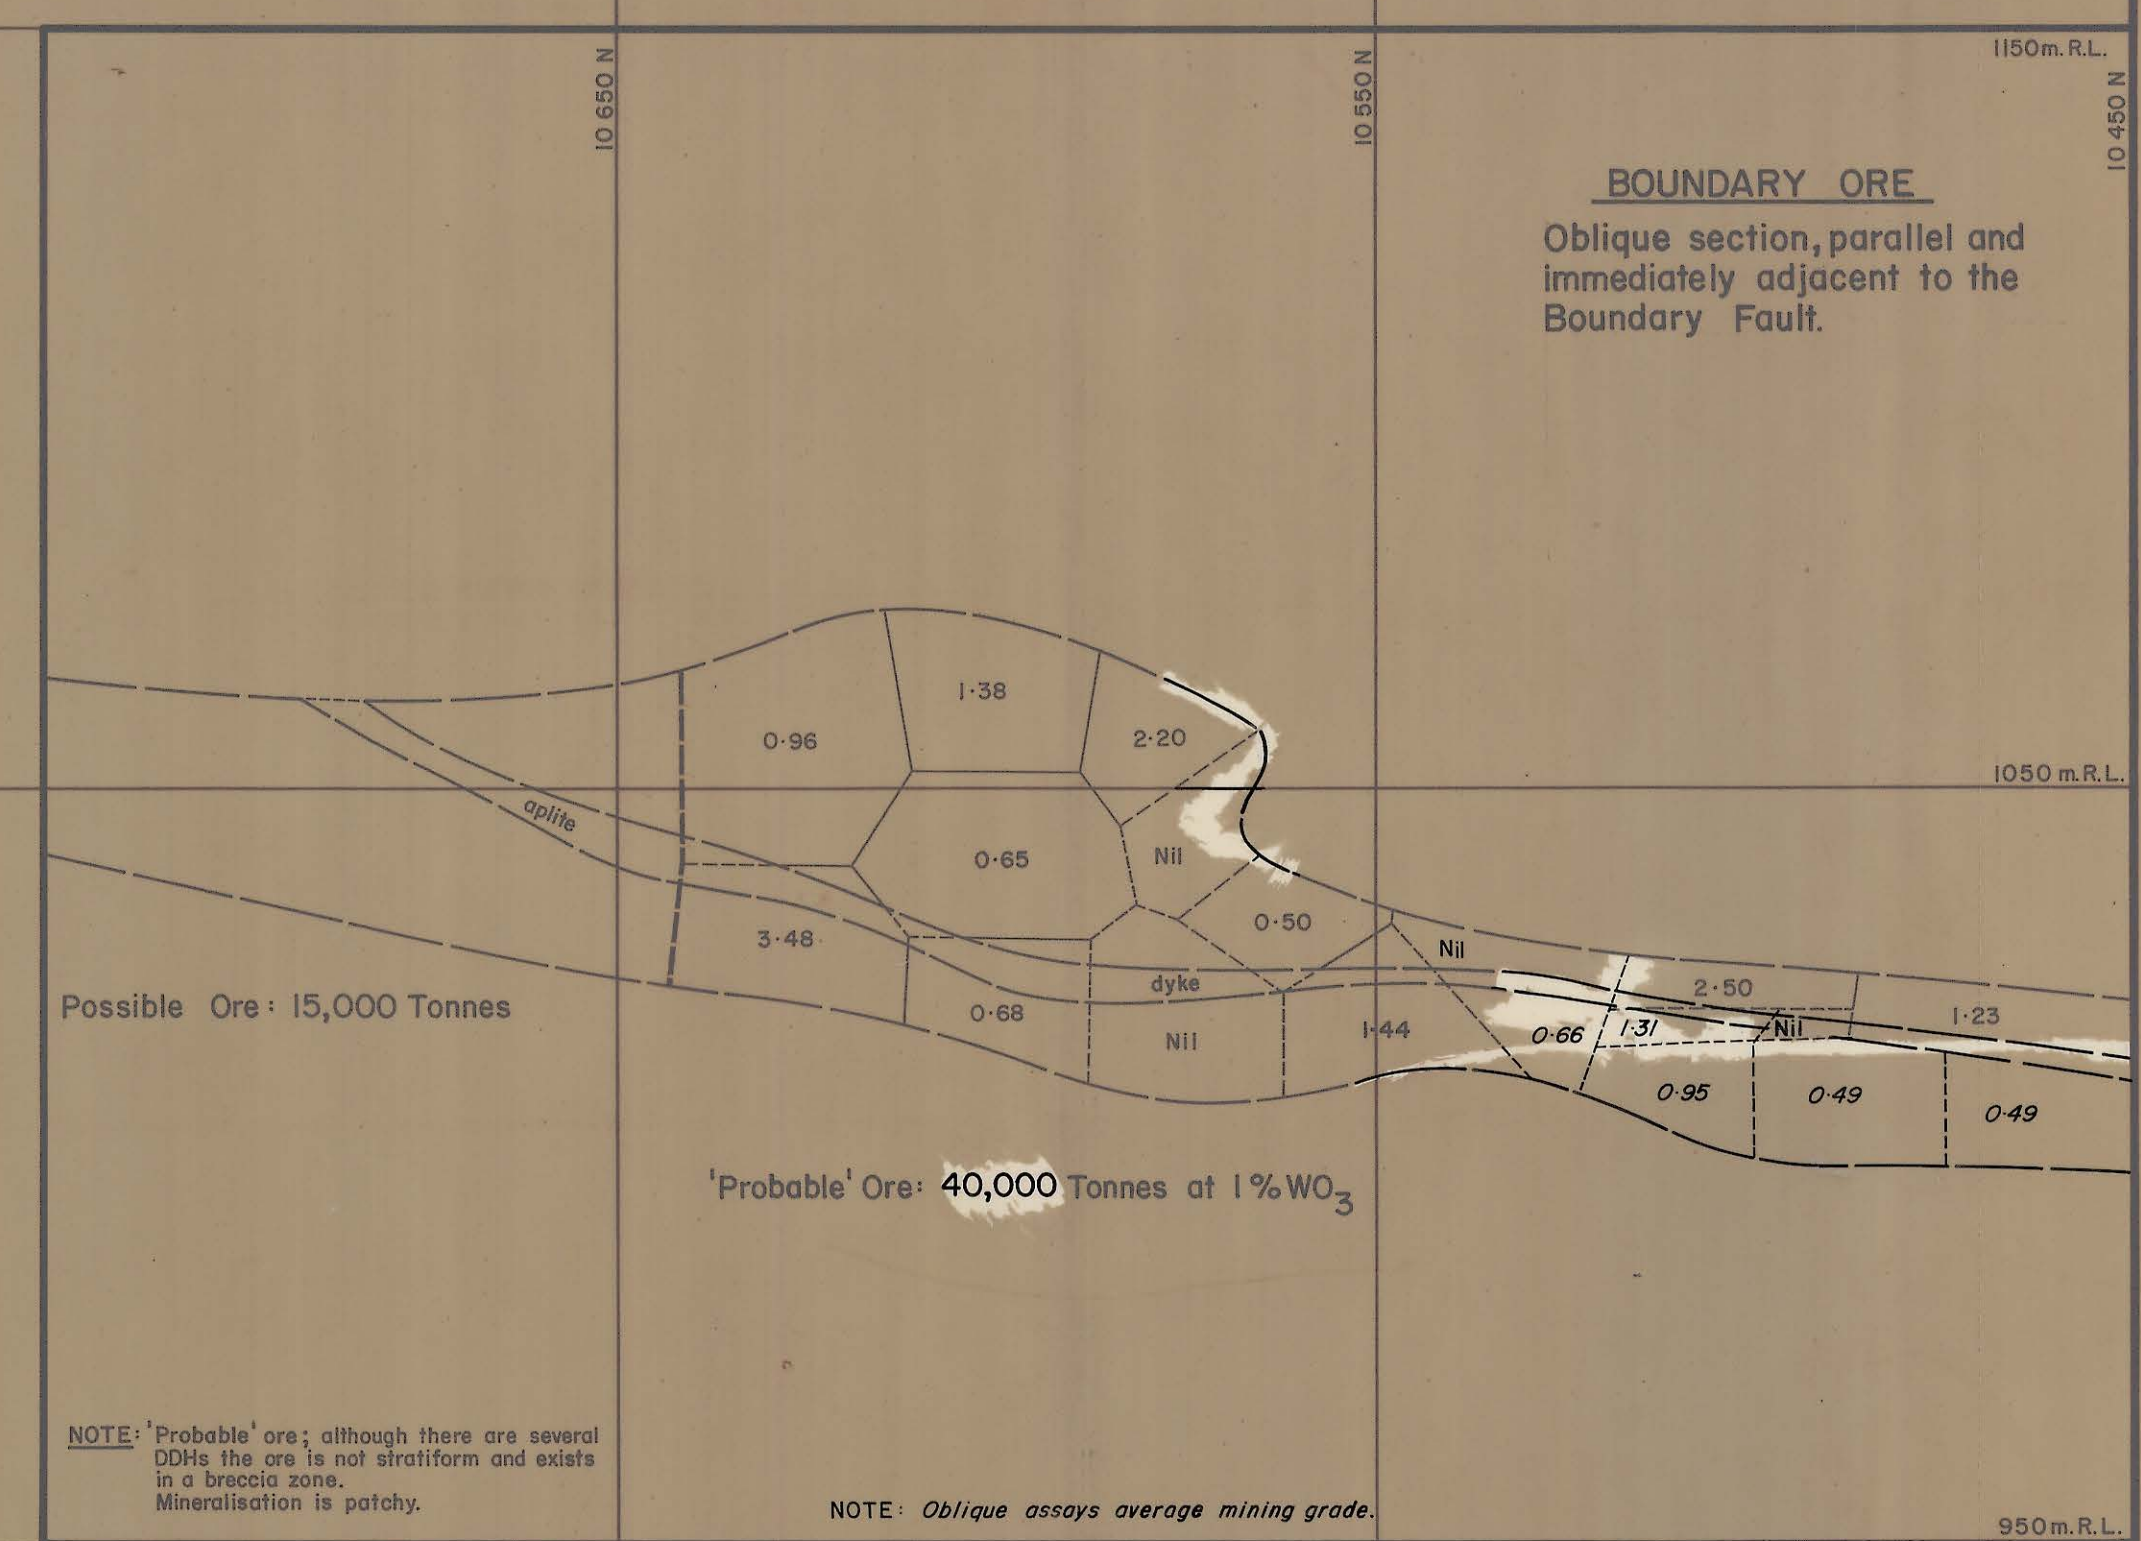

0374-1534
0374-1531
5 cm

NB: Original tonnage. Mined tonnage not subtracted.

