


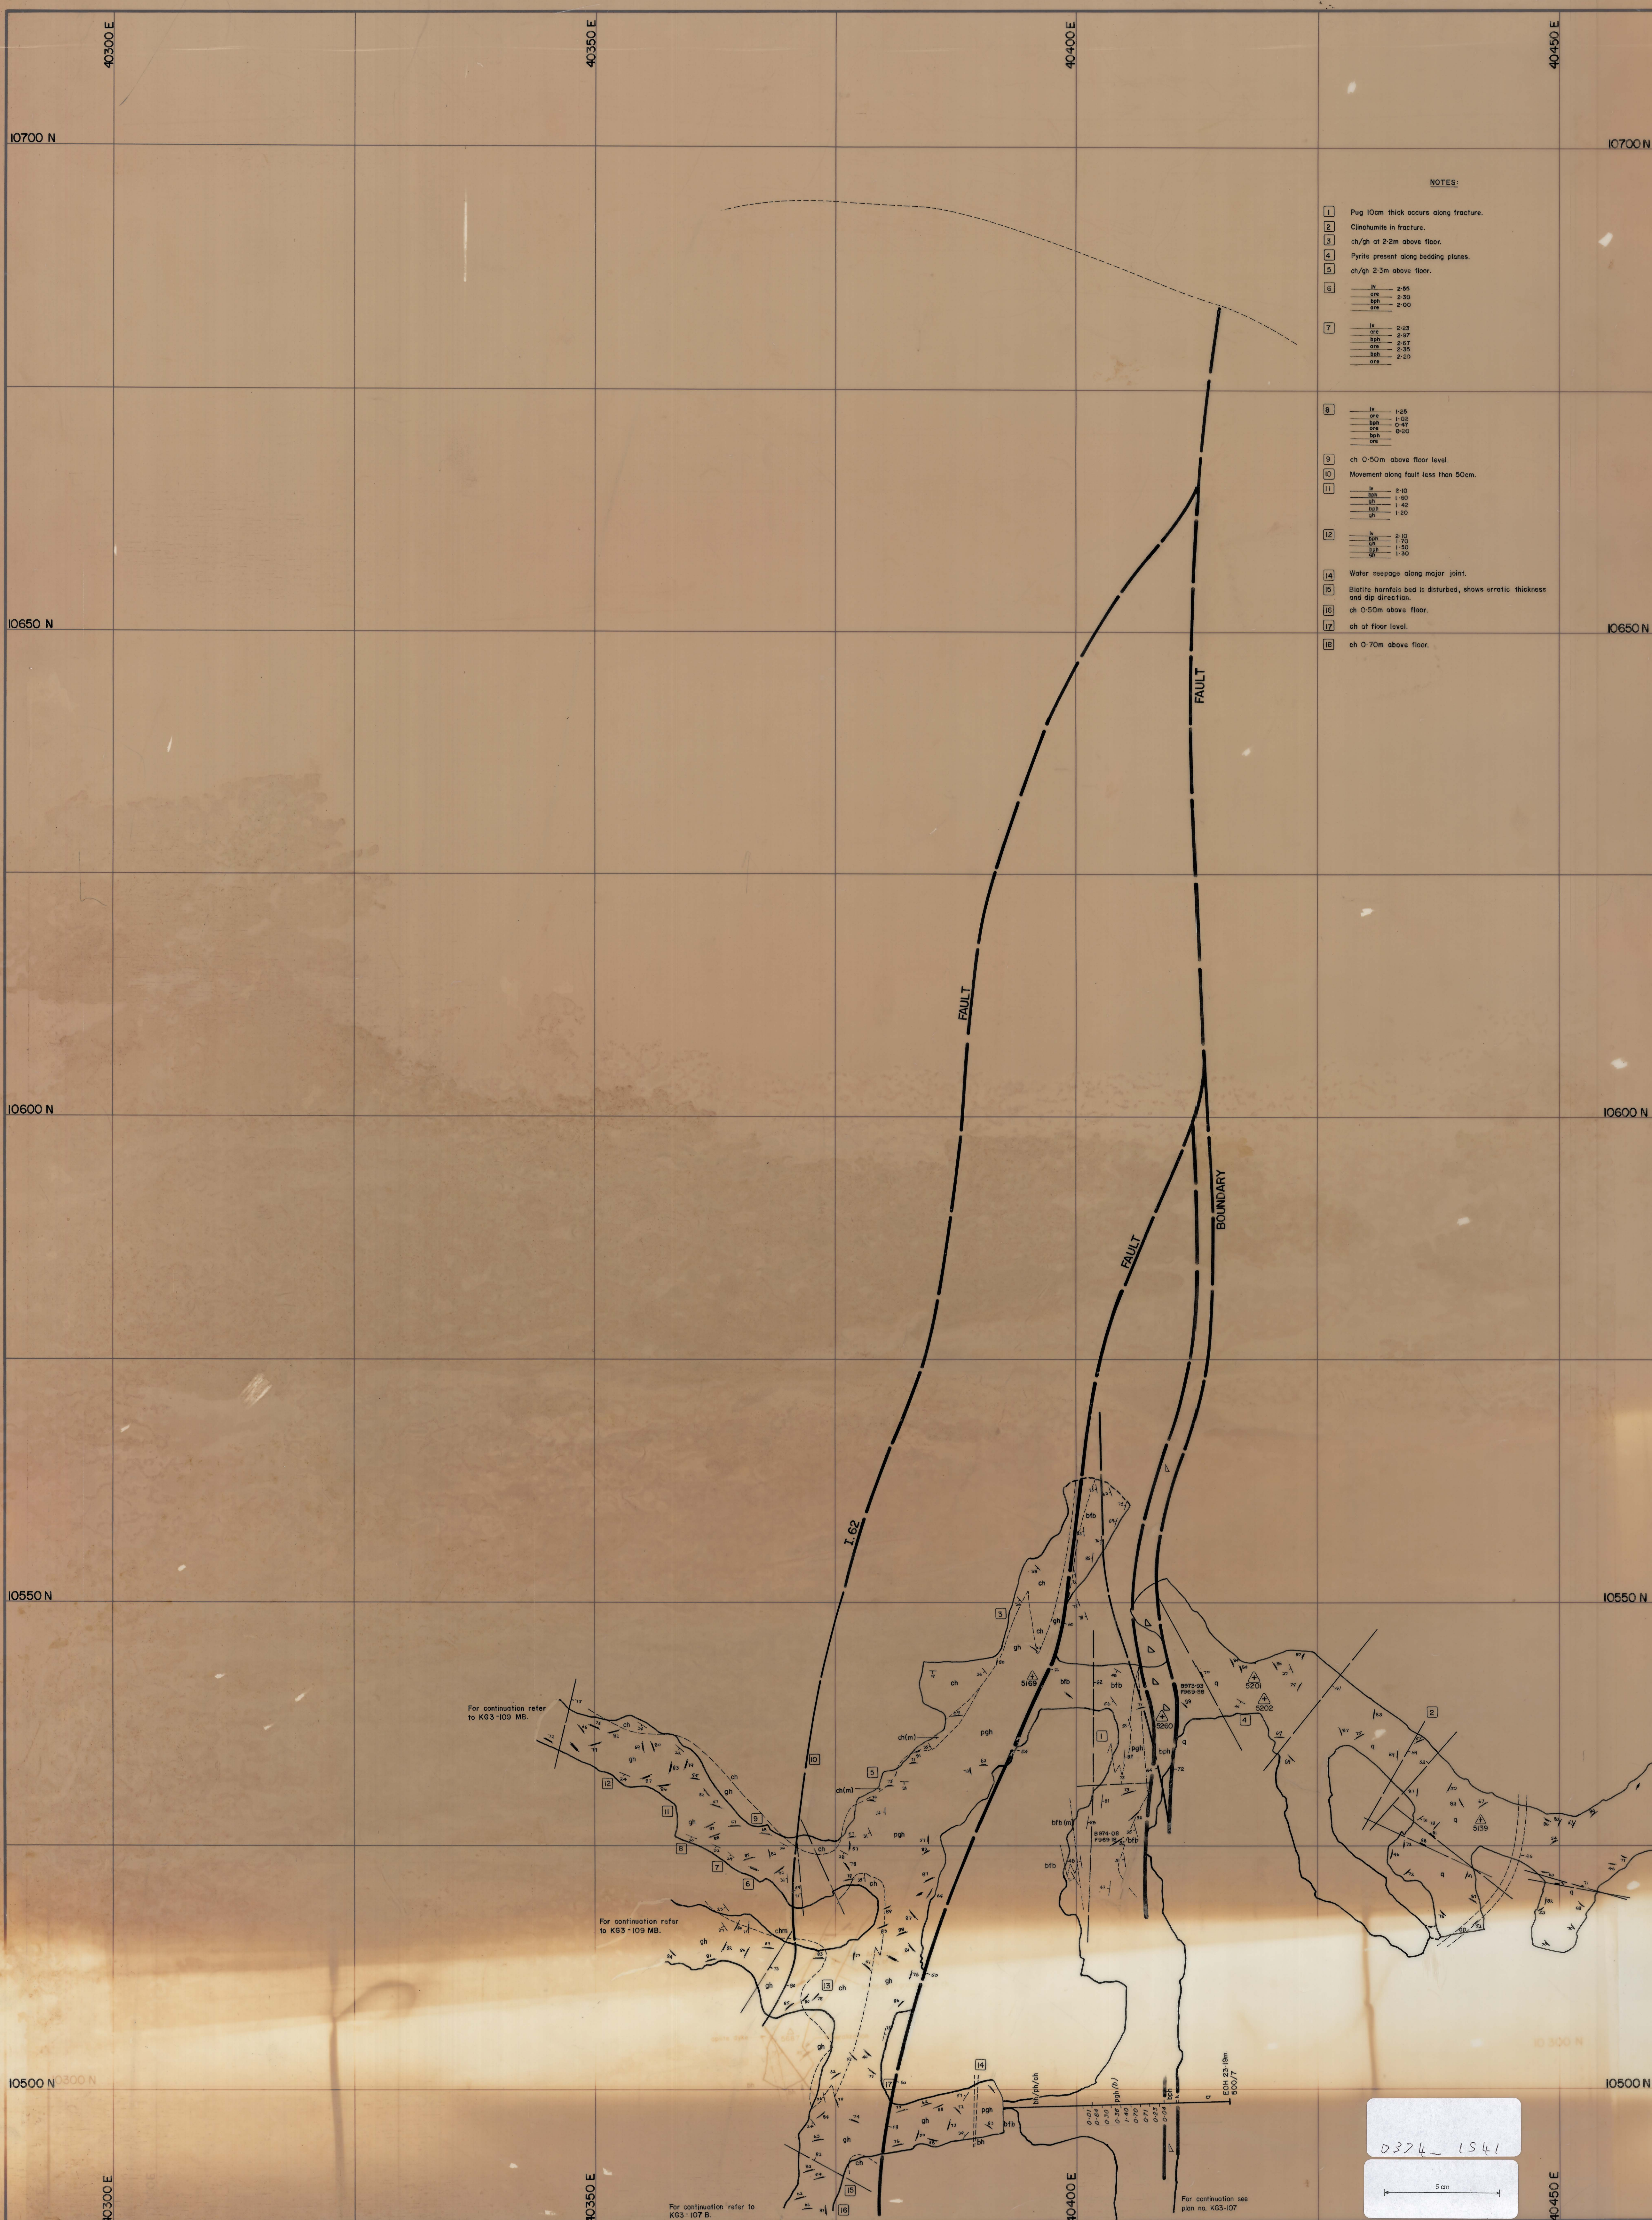

NOTES:

- 1 Pug 10cm thick occurs along fracture.
- 2 Clinohumite in fracture.
- 3 ch/gh at 2.2m above floor.
- 4 Pyrite present along bedding planes.
- 5 ch/gh 2.3m above floor.

10
11
12











LEGEND:

uv

Upper metavolcanics

pgh

Pyroxene garnet hornfels

ad

Adamellite

60

Strike and dip

50

Joint, inclined

Joint, vertical

Fault

Fault showing relative movement

Degree of uncertainty in fault position

bfb

Banded footwall beds (bfb)

ch/gh

ch/gh

ch

Marble

ch

Marble

