Lower Pit STOPE -216.5 Contour
KG04DM15-1056
0374_1679
27 JUN 1981

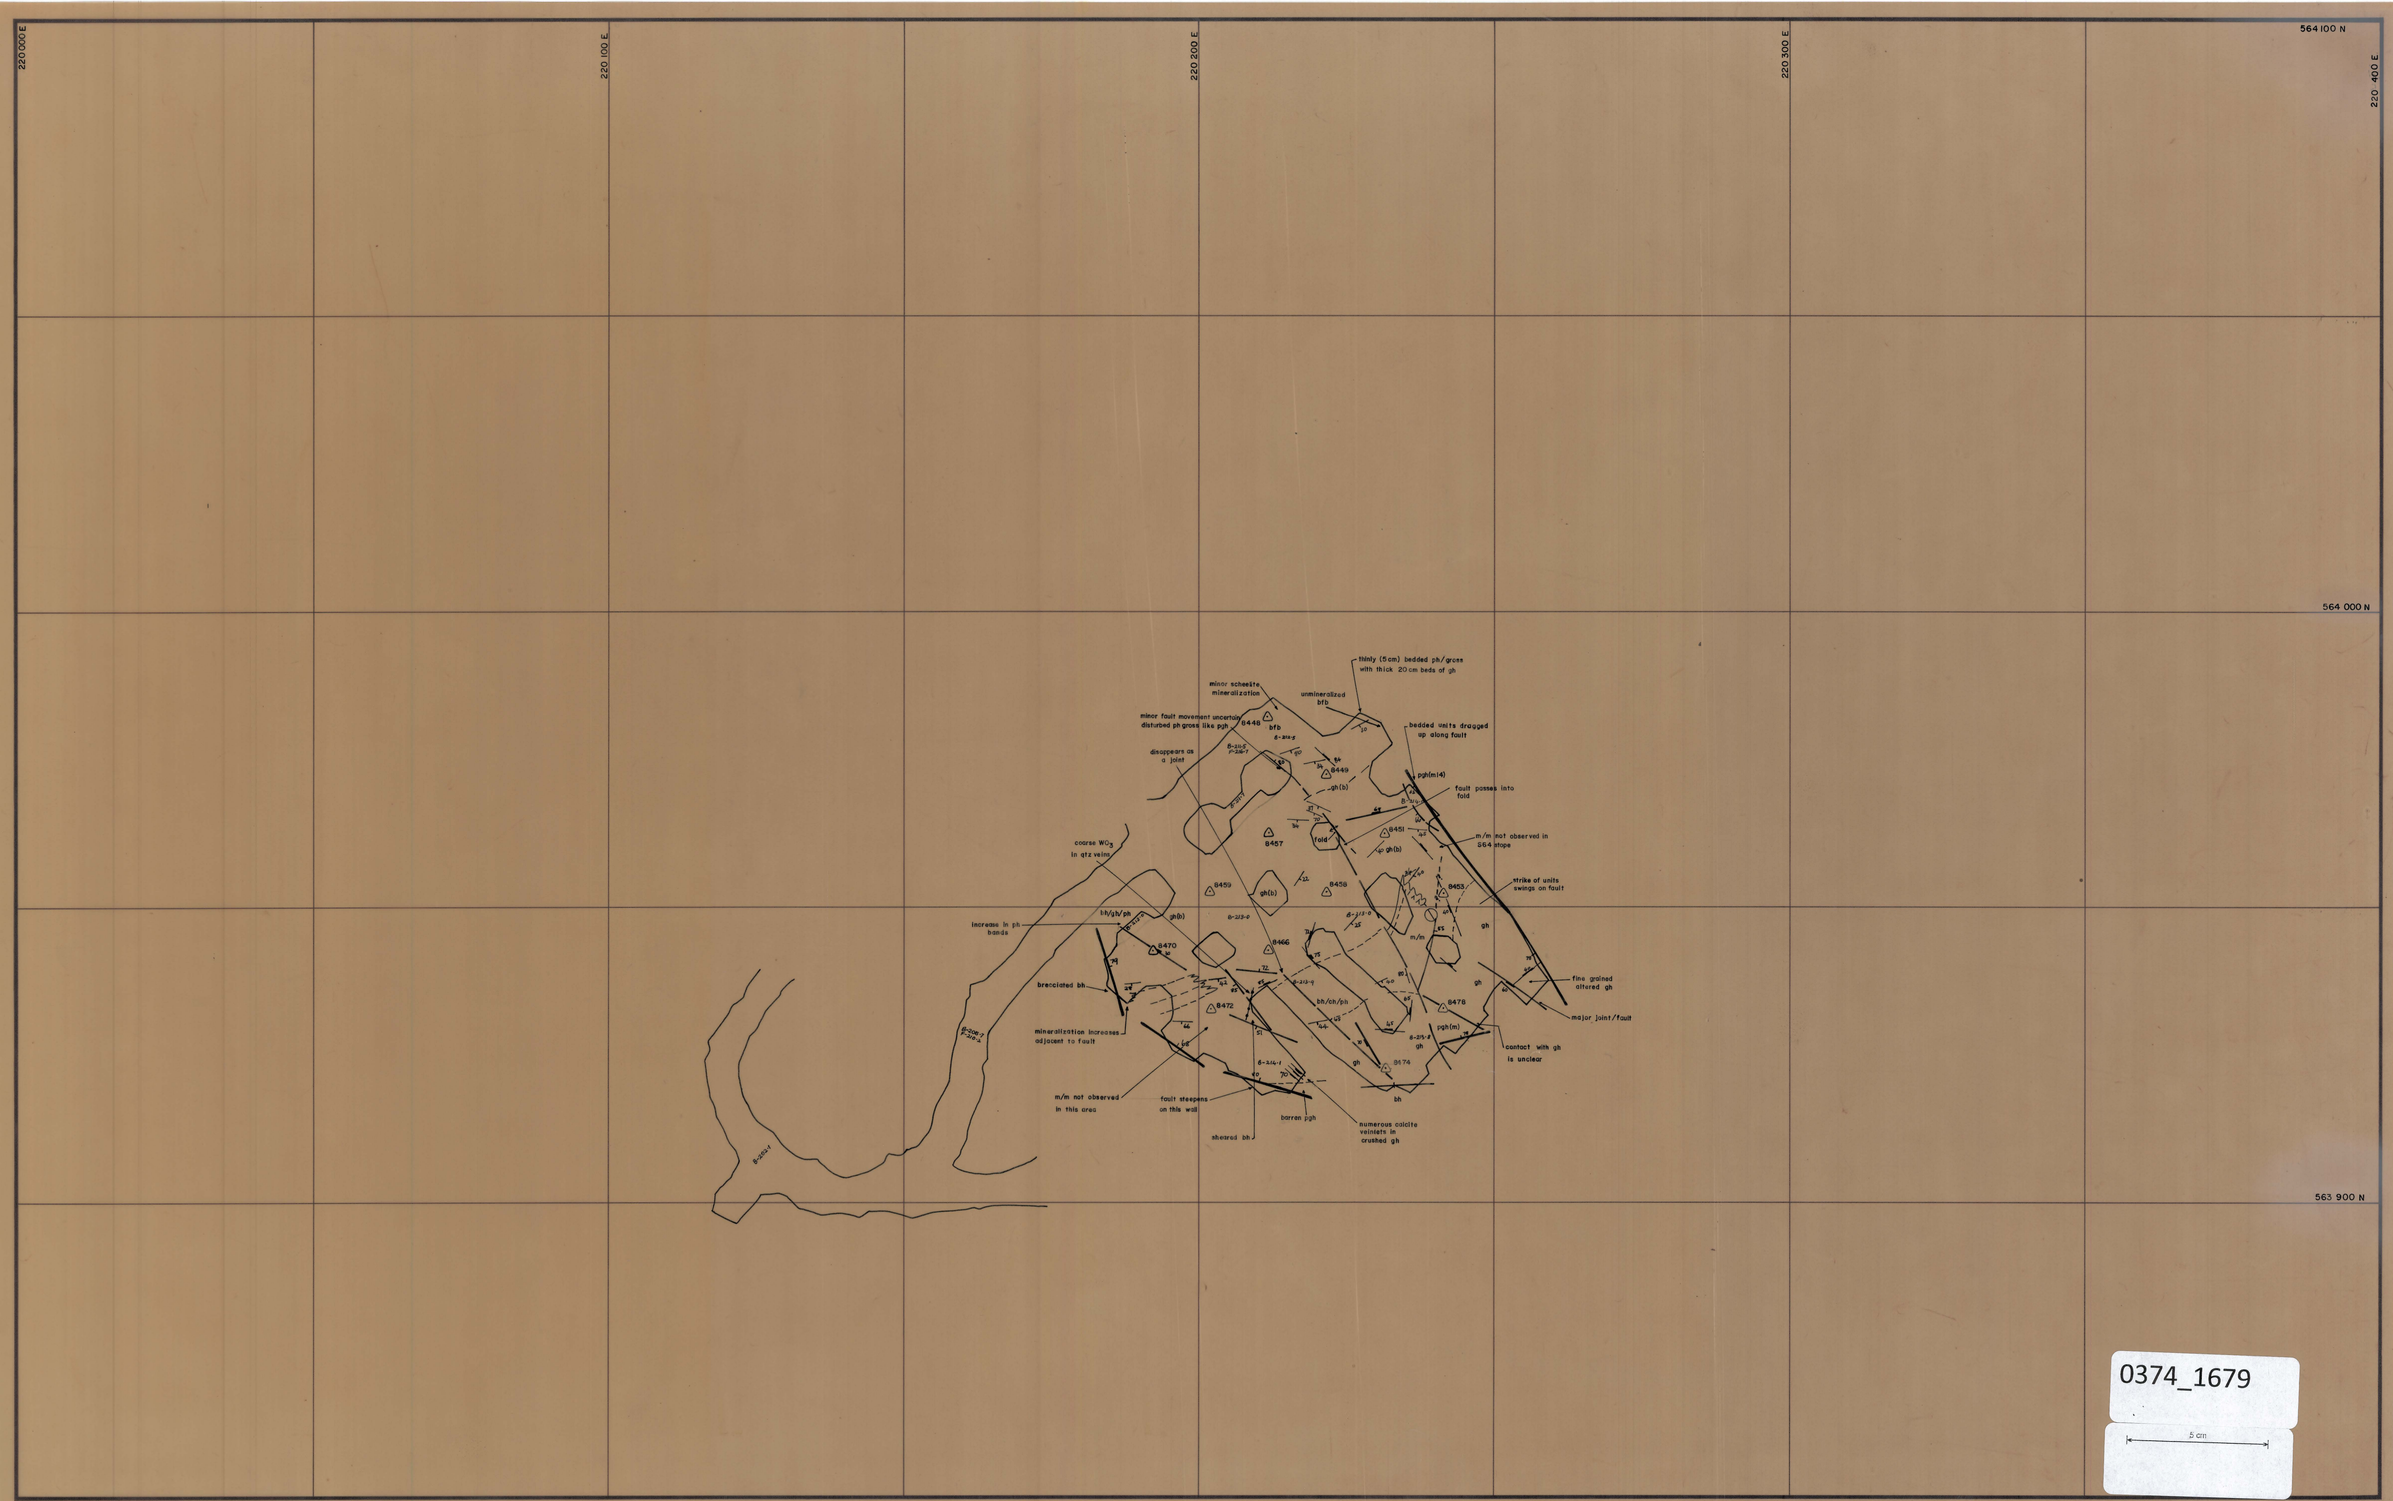

0374_1679

5 cm

LEGEND:

v	Upper metavolcanics
bh/ph	Banded hornfels
ch	Marble
bh	Biotite hornfels
pgh	Pyroxene garnet hornfels
gh	Garnet hornfels
bh/ph ch/gh	Banded footwall beds
bph	Biotite pyroxene hornfels
lv	Lower metavolcanics
q	Quartzite
ap	Aplite
gr	Granite

strike and dip
strike and dip vertical
joint
joint vertical
unconformity
relative movement
rise extending through level
head of rise
foot of rise
survey station

geological boundary
minor fault
major fault

b back
f floor
r road
s spad

KING ISLAND SCHEELITE

SCALE 1:

DWG. No. KG04DM15-1056

DATE: JAN 81
DRAWN: M.F.
GEOLOGY: R.H.D.
CHECKED:

DOLPHIN MINE

LOWER PIT STOPE-216·5m CONTOUR

3rd LIFT MAPPING AT BACK R.L.