0374-1713

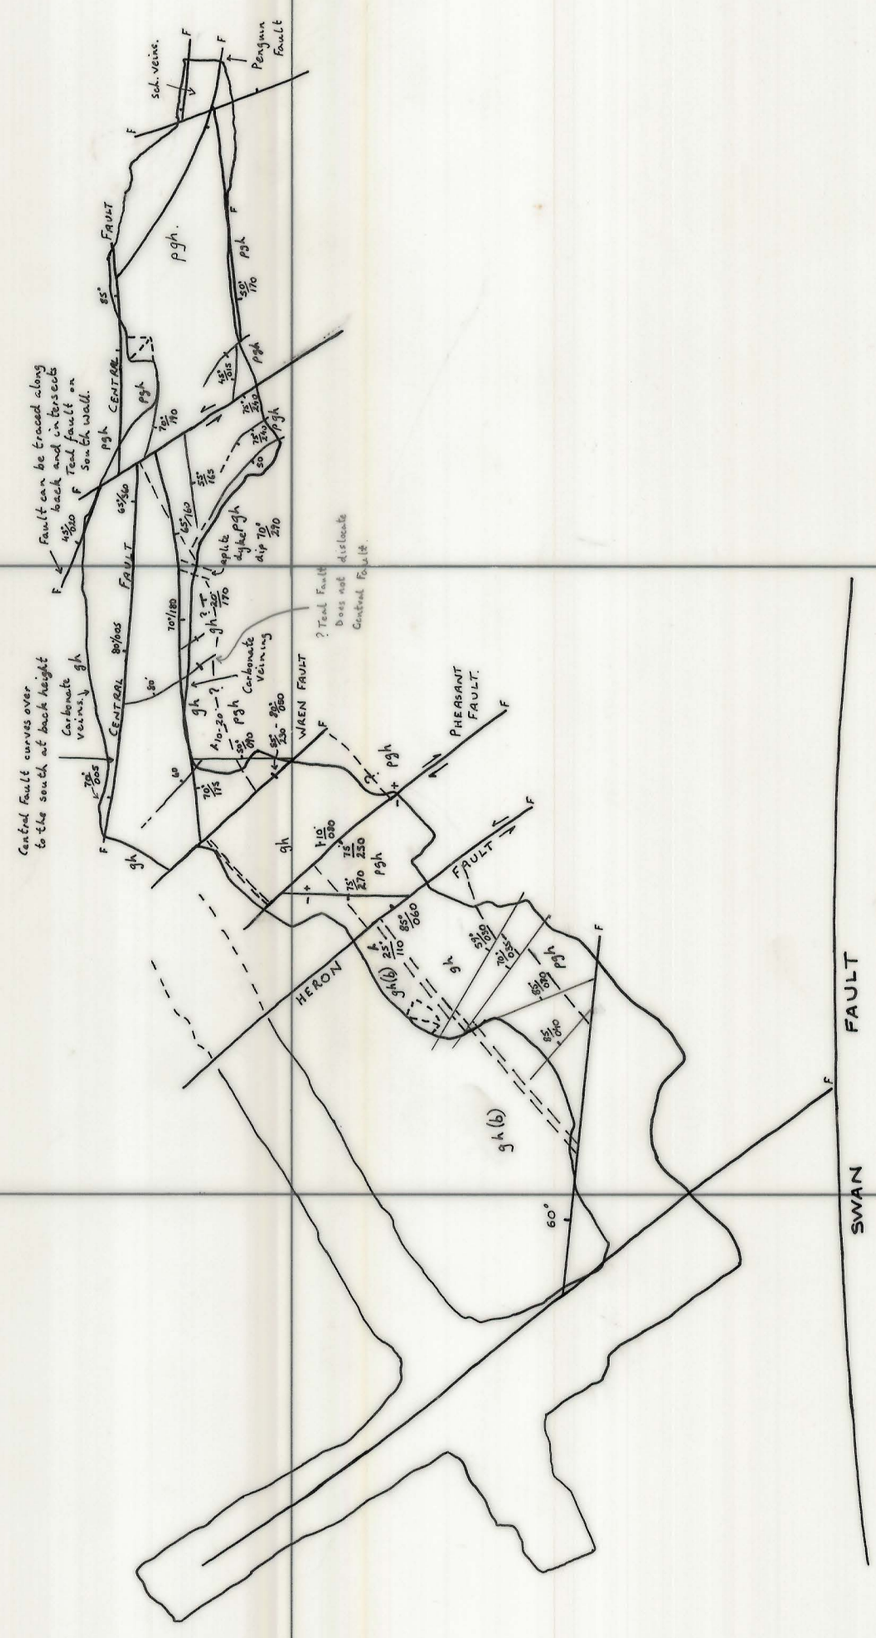

SCALE 1: 500

Geology approximately at -88.5 m RL

north

LOCATION

DOLPHIN MINE

SUBJECT

UPPER PIT

LIFT 18 GEOLOGICAL PLAN

KING ISLAND SCHEELITE
A DIVISION OF WARMAN INTERNATIONAL

GRASSY KING ISLAND

GAF MAR'81

PLAN NUMBER