0374_1820

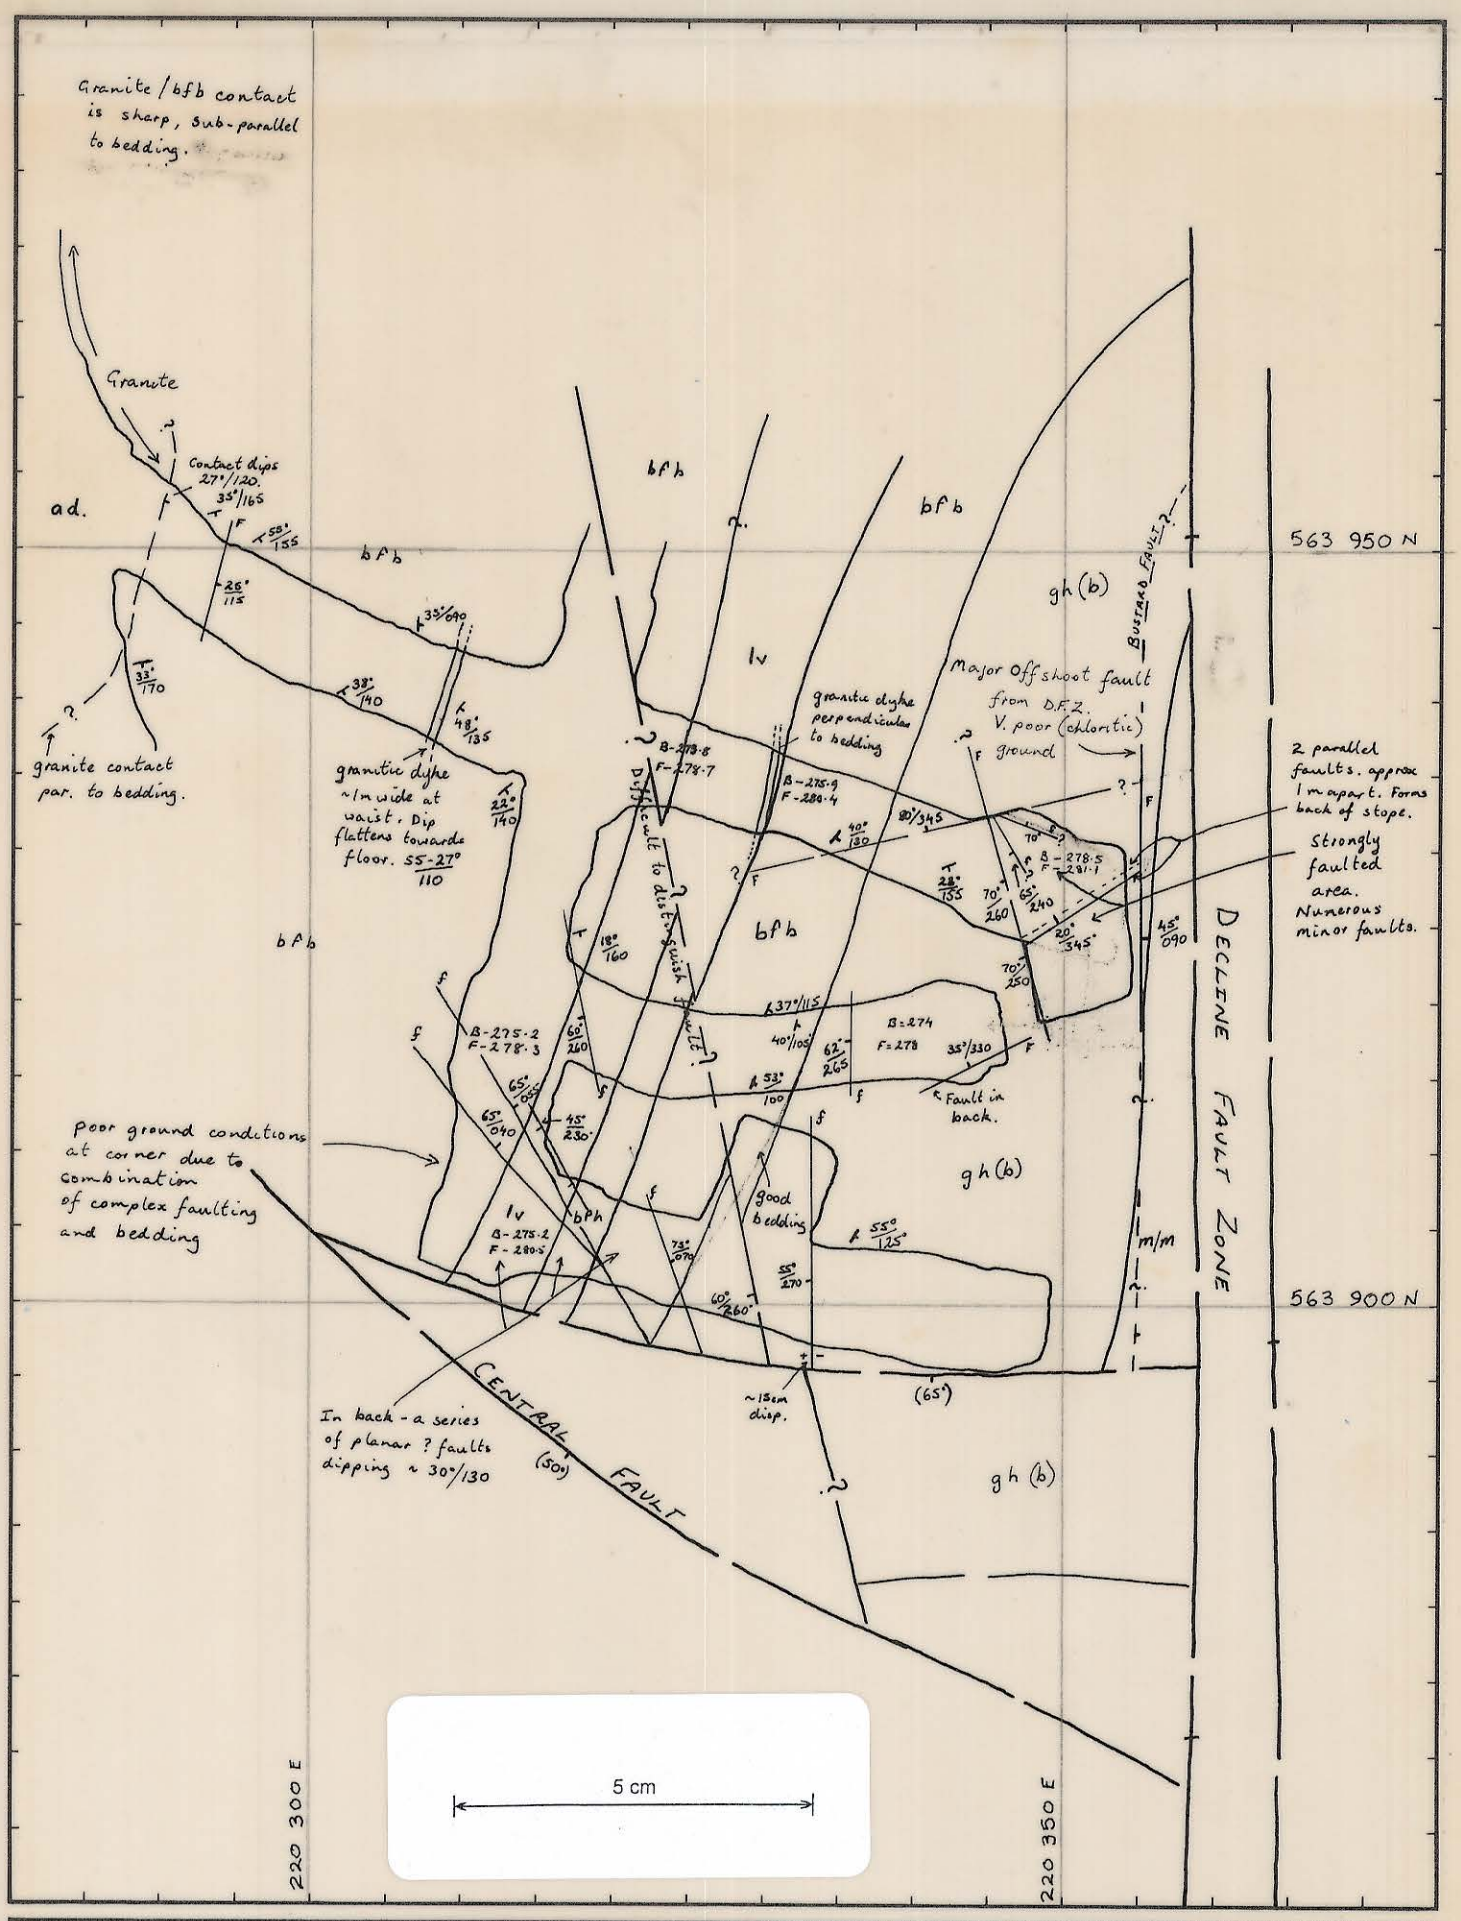

REF. PLAN	GEOLOGY	P.R.B.	15/11/88	1 : 500 SCALE	KING ISLAND SCHEELITE GRASSY KING ISLAND
	SURVEY				
	PLANNING				
	ROCK.MEC.				
	GRADE CON.				
	DRAFTING				
	T.S.S.				

WEDGE REMNANT
LIFT No 2.

GEOLOGY AT 280mRL (Approx.)

DRAWING NUMBER

0374_1820