0374_1830


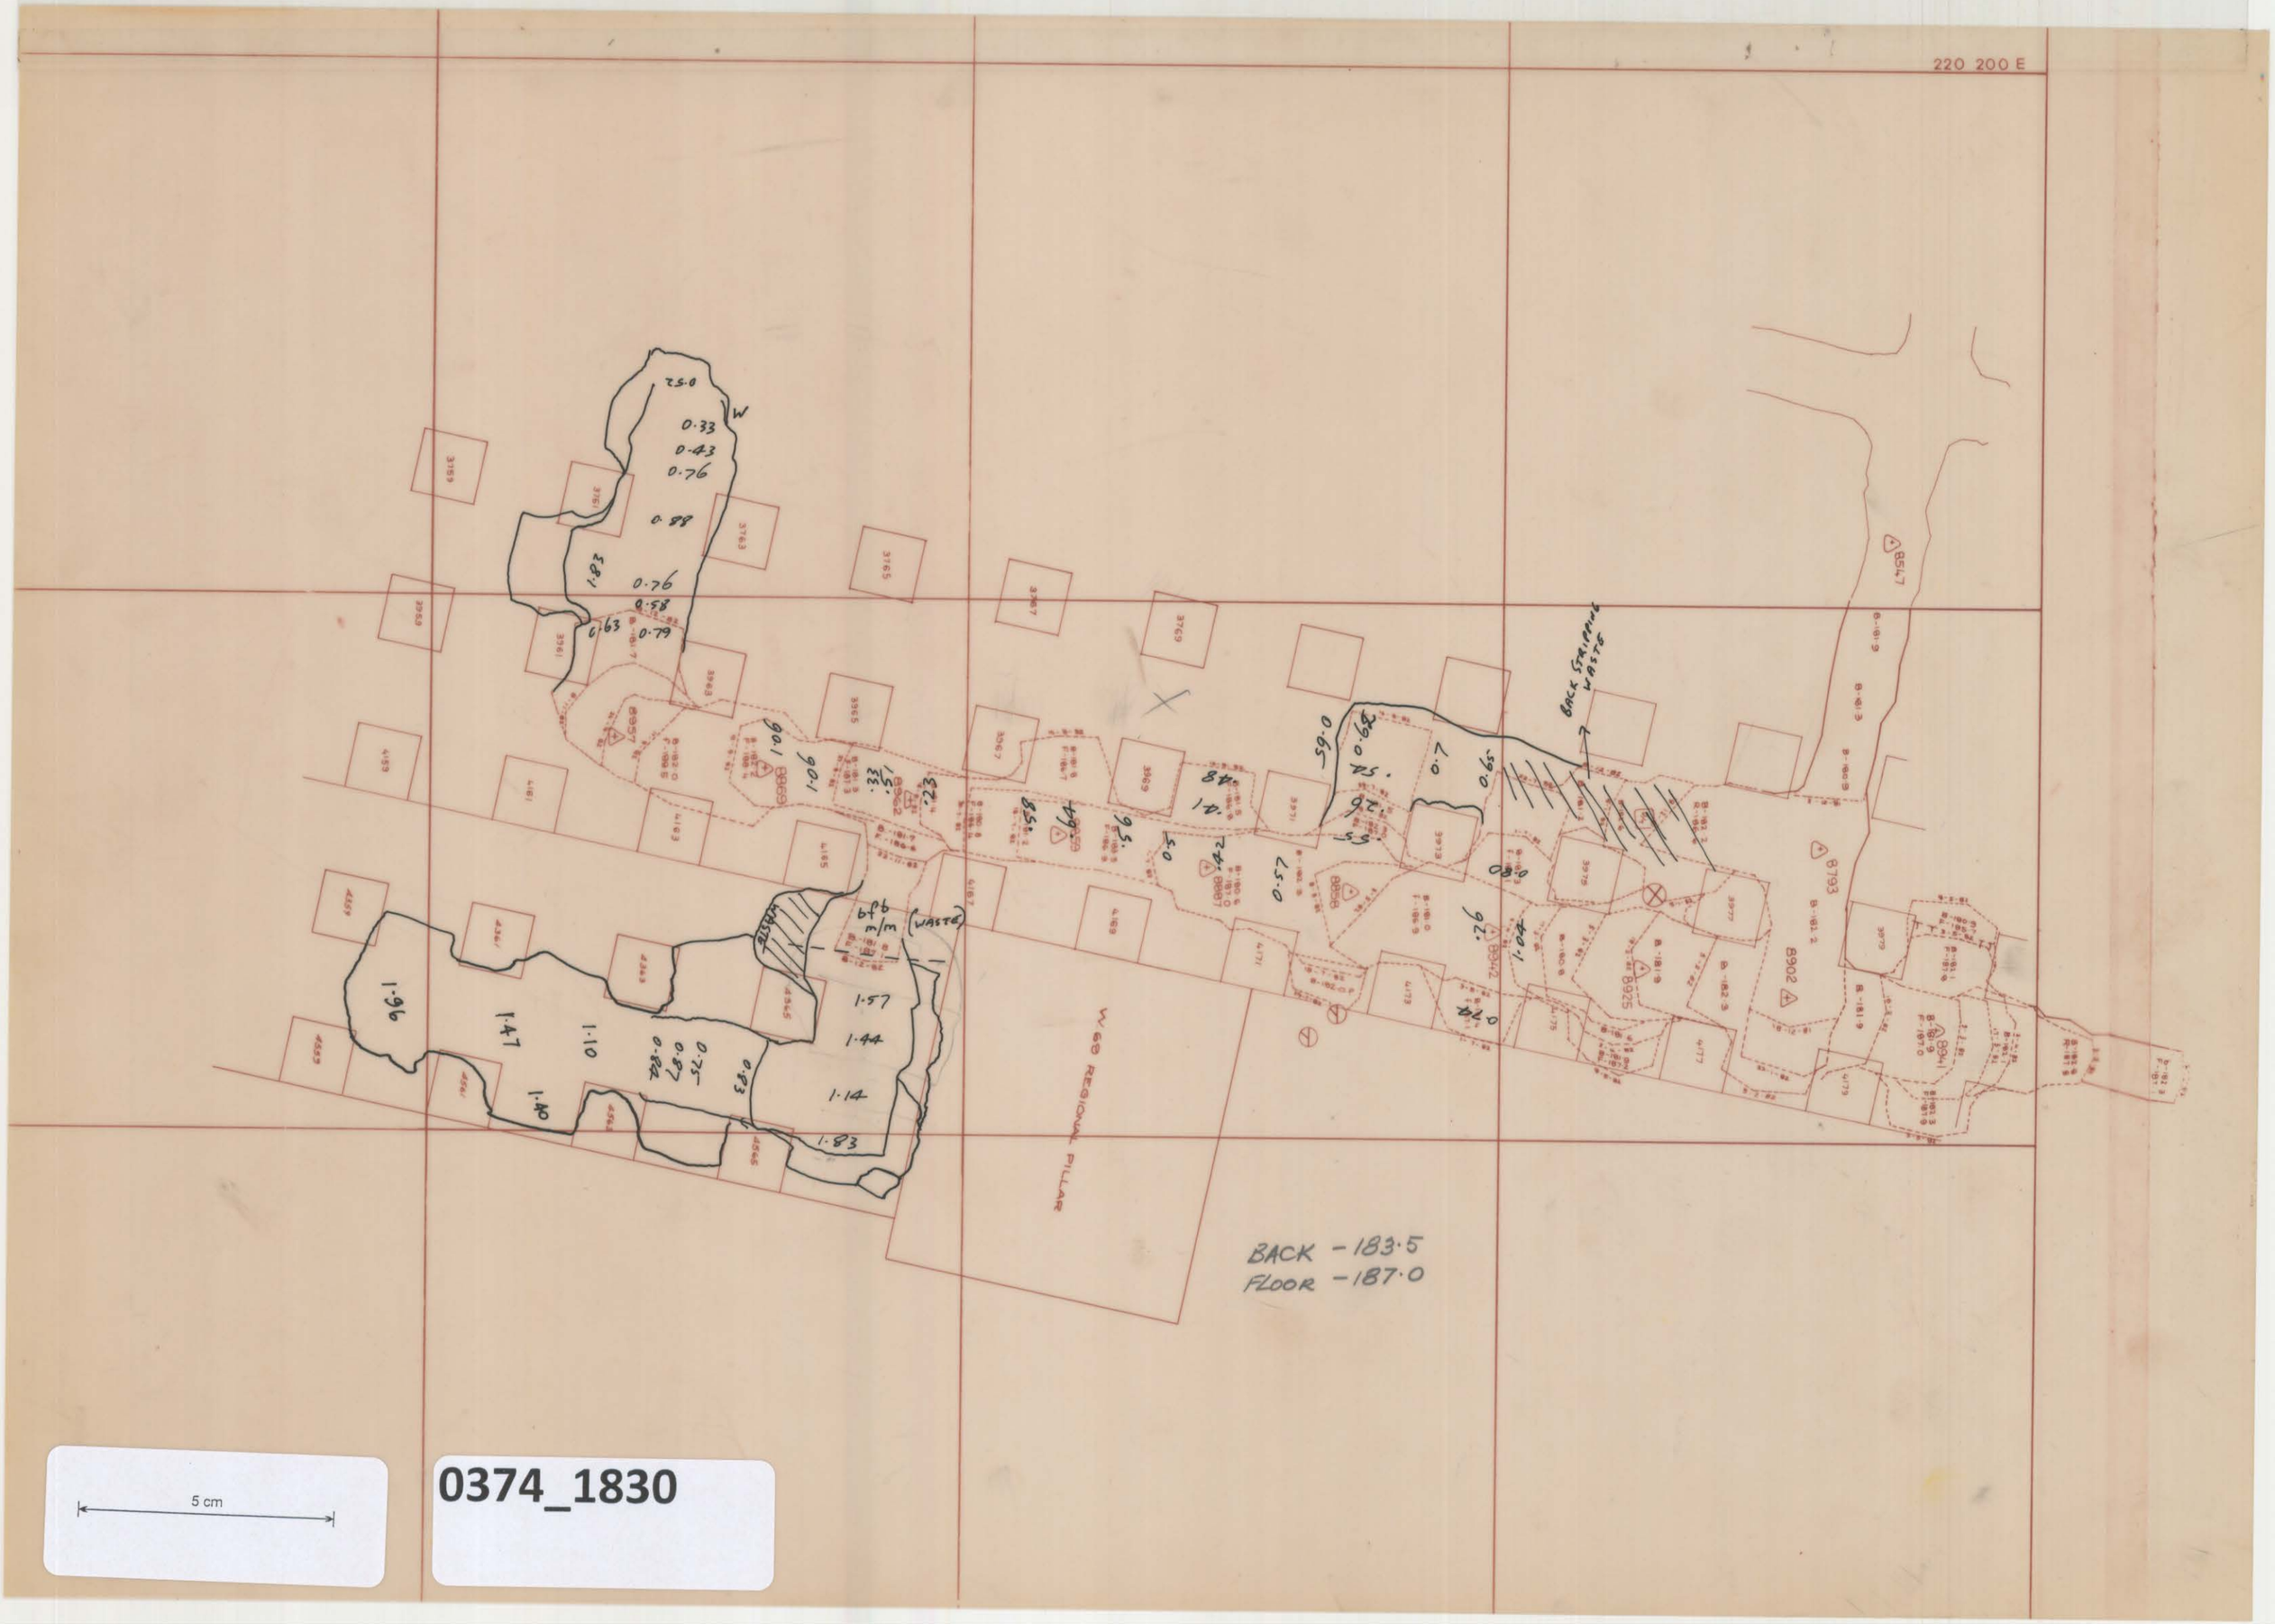

5 cm

0374_1830