



0374_1831

M. wedge Lift 05

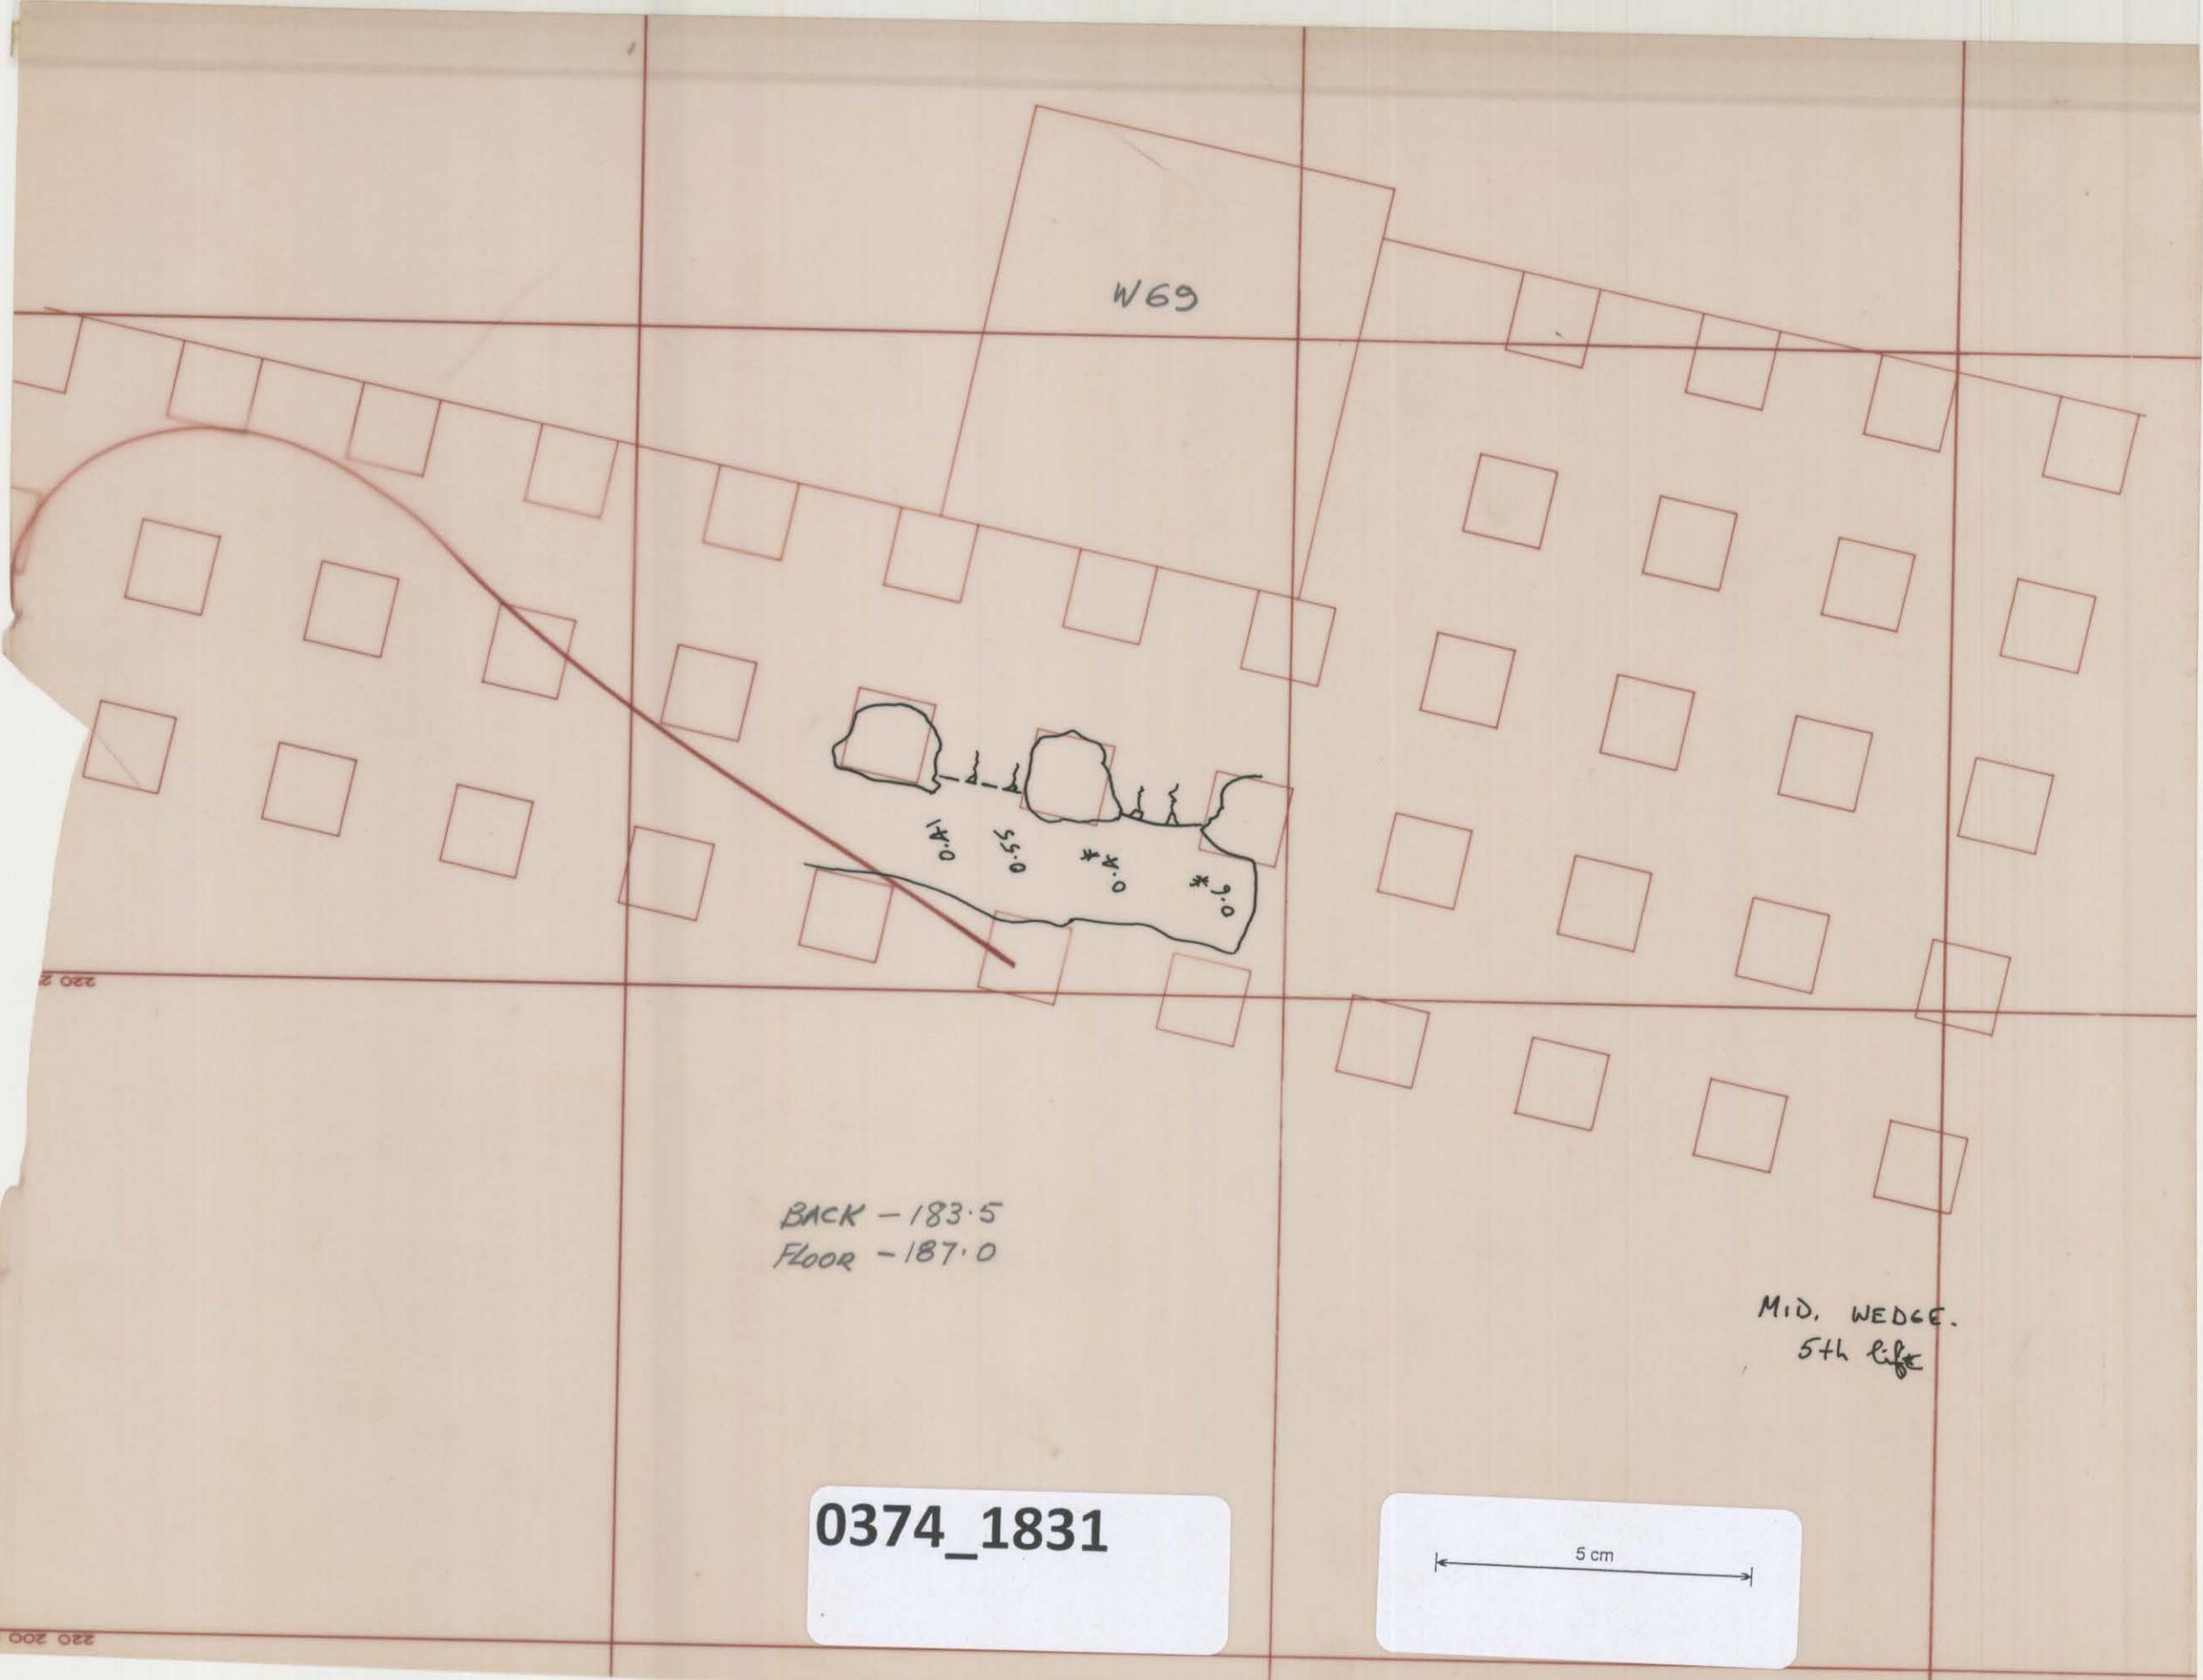

0374_1831

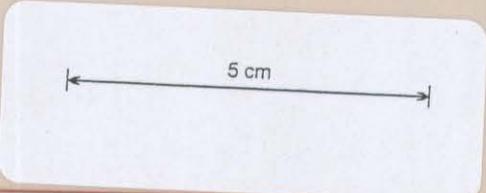

220 2

220 200 E