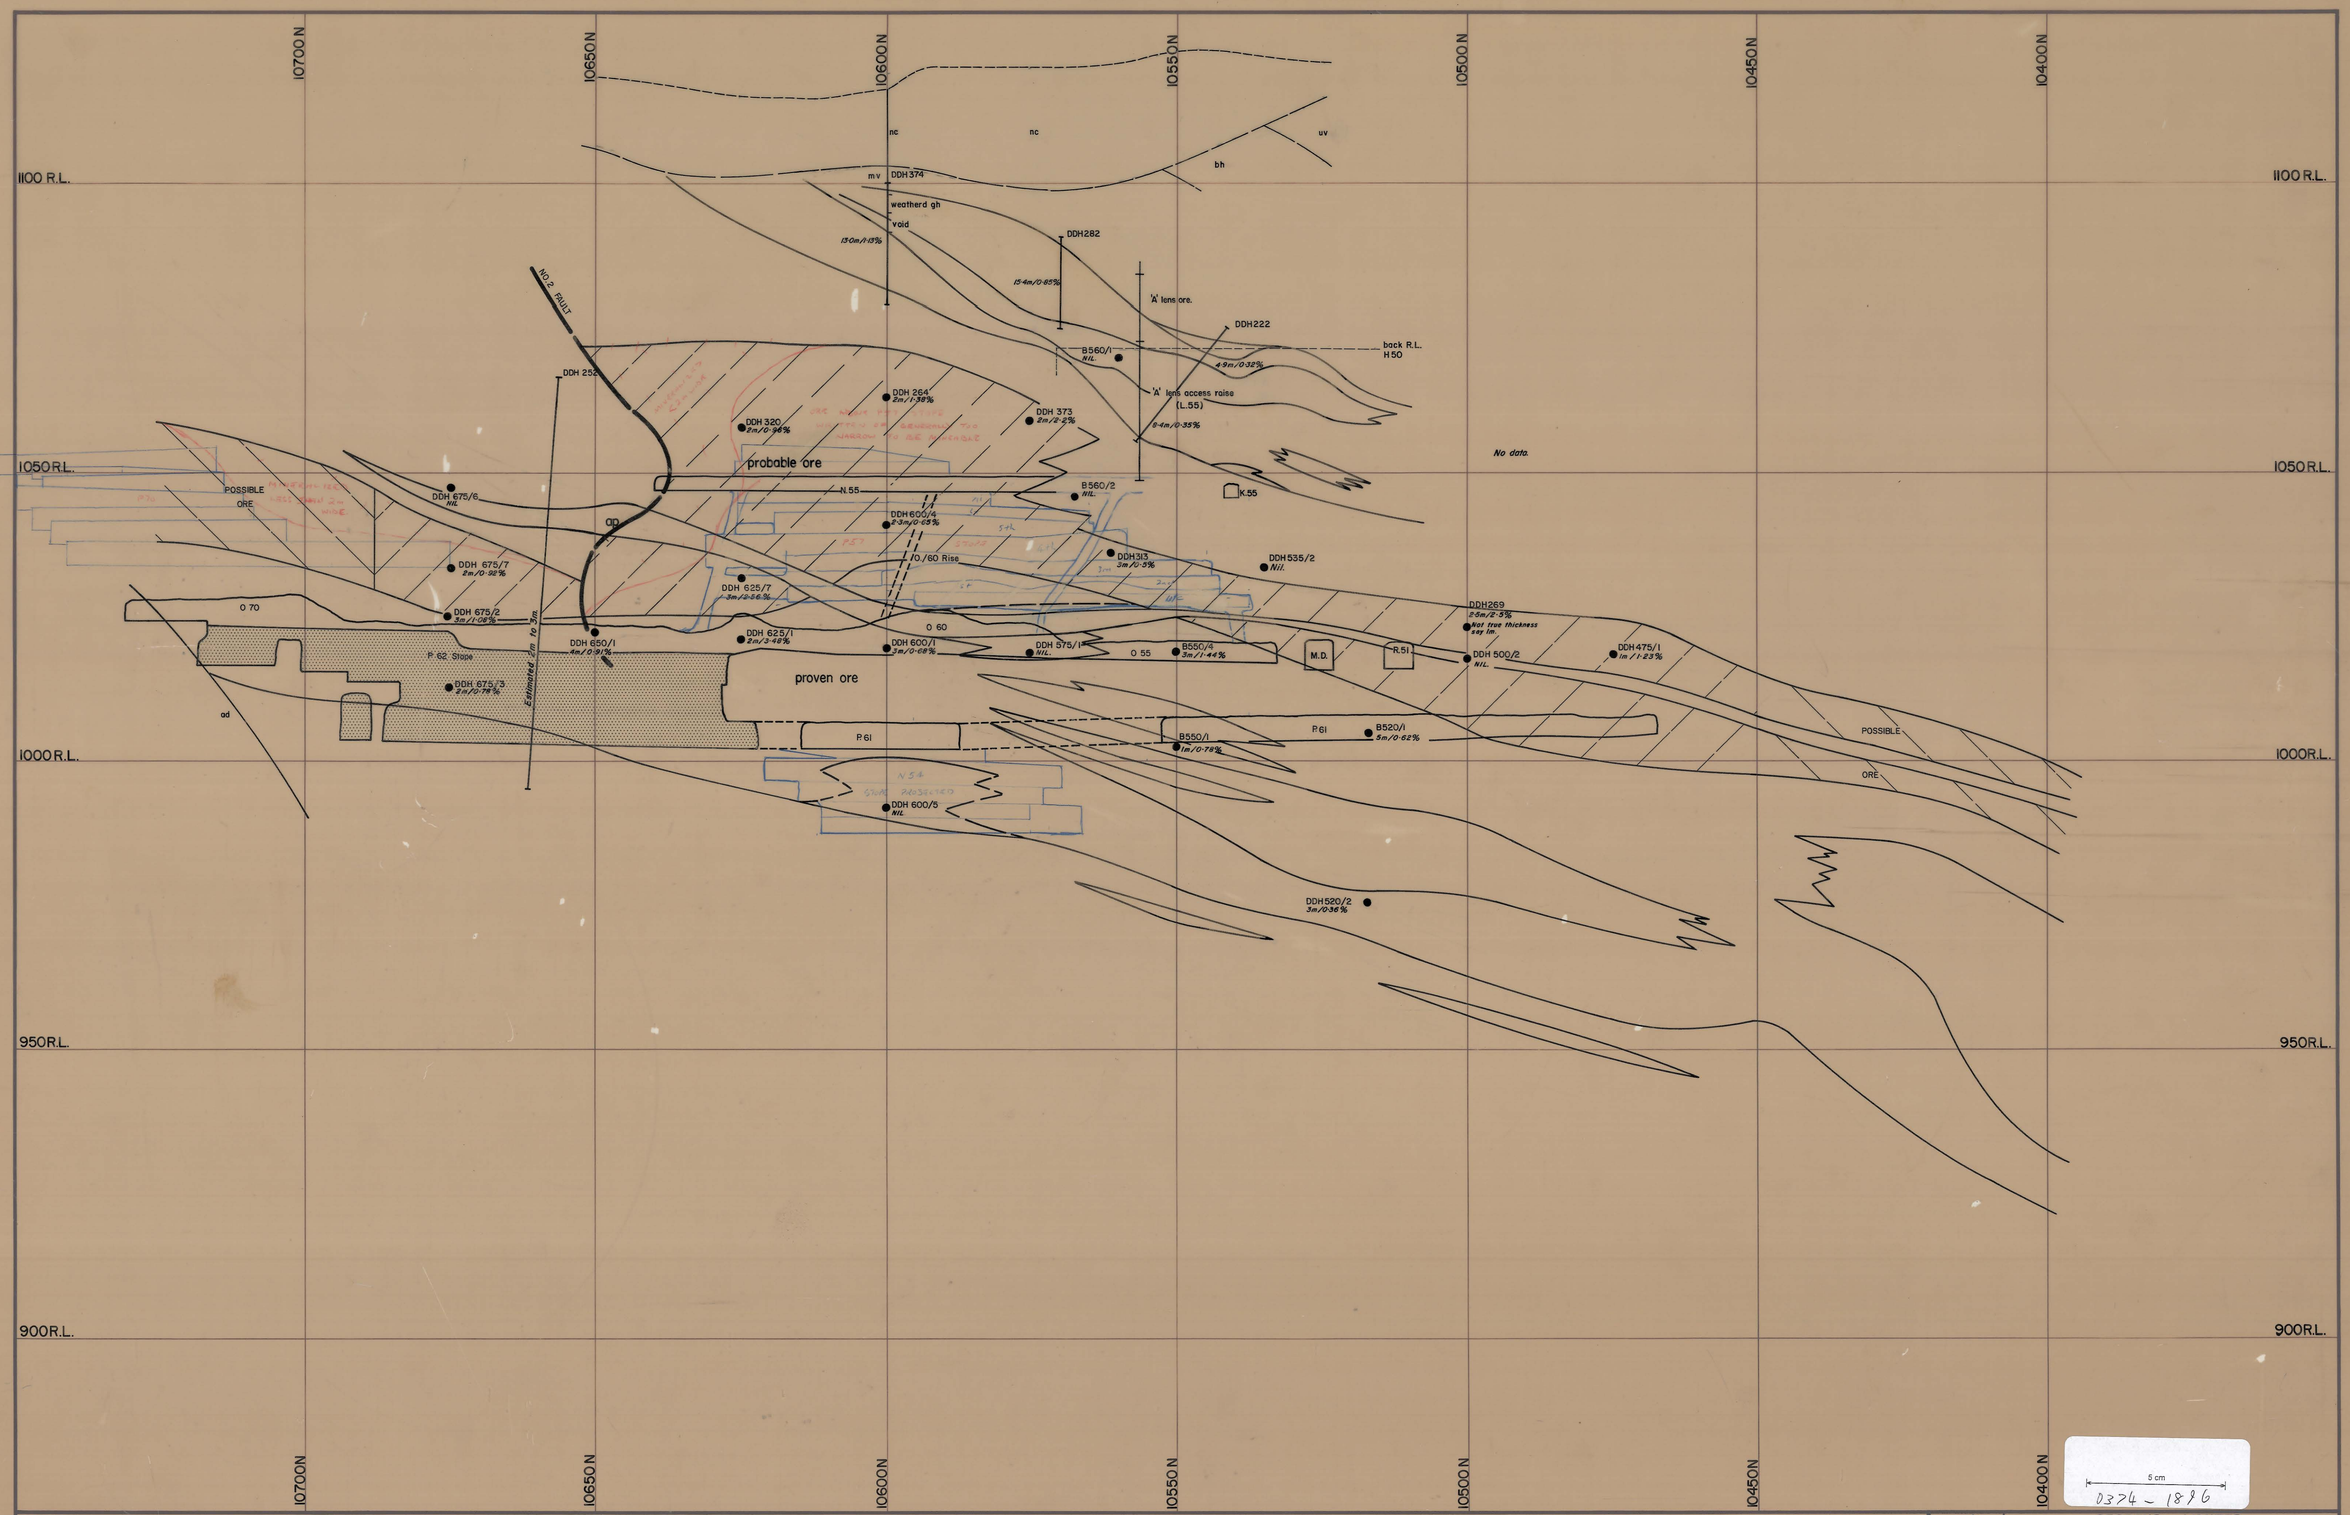

LEGEND:

pgh	Pyroxene garnet hornfels.
gh	Garnet hornfels.
ap	Aplite.
ad	Adamellite.

N.B. This section is diagonal and oblique to grid.

N.B. Because of the various directions of drill hole intersections this section should be used in conjunction with the 25m cross-section.

ISSUE DATE:

DATE: July, 1975.
GEOLOGIST: S.G.B.
DRAWN: A.H.
CHECKED: M.C.R.

GEOPEKO LIMITED
KING ISLAND GROUP

SCALE: 1:500

No. KG3-24-025

Section 1·0m West of Boundary Fault

5 cm

0374 - 1896