



CROSS SECTION B-B

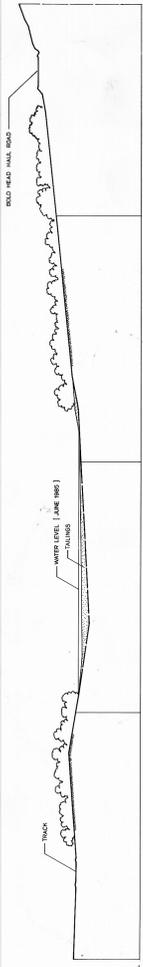

CROSS SECTION A-A

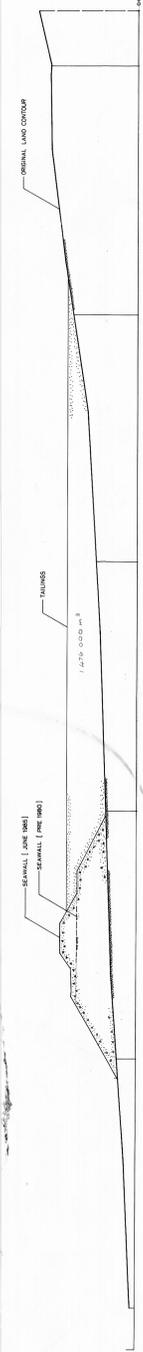

LONG SECTION C-C



NOTE: Nº 1 SETTLING POND, SEAWALL AND Nº 2 TAILINGS DAM, SEPARATION WALL, SHOWING AS THE MAXIMUM CIRCUMFERENCE.

SCALE 1:1000

VOLUME CALC.	
BY JUNE 1985	
TAILINGS - Nº 1 SETTLING POND	- 1 080 825 m ³
WATER - Nº 1 SETTLING POND	- 68 190 m ³
TAILINGS - Nº 2 SETTLING POND	- 26 800 000 litres
WATER - Nº 2 SETTLING POND	- 30 810 000 litres
VOLUME OF SEPARATION WALL	- 65 000 m ³

TAILINGS DISPOSAL

Nº 1 SETTLING POND & ENVIRONS
30 JUNE 1985

046D04 - 0006