


LINE 9  
SCALE 1in=50ft  
FROM QC-70 AS OF 15.12.70

5m

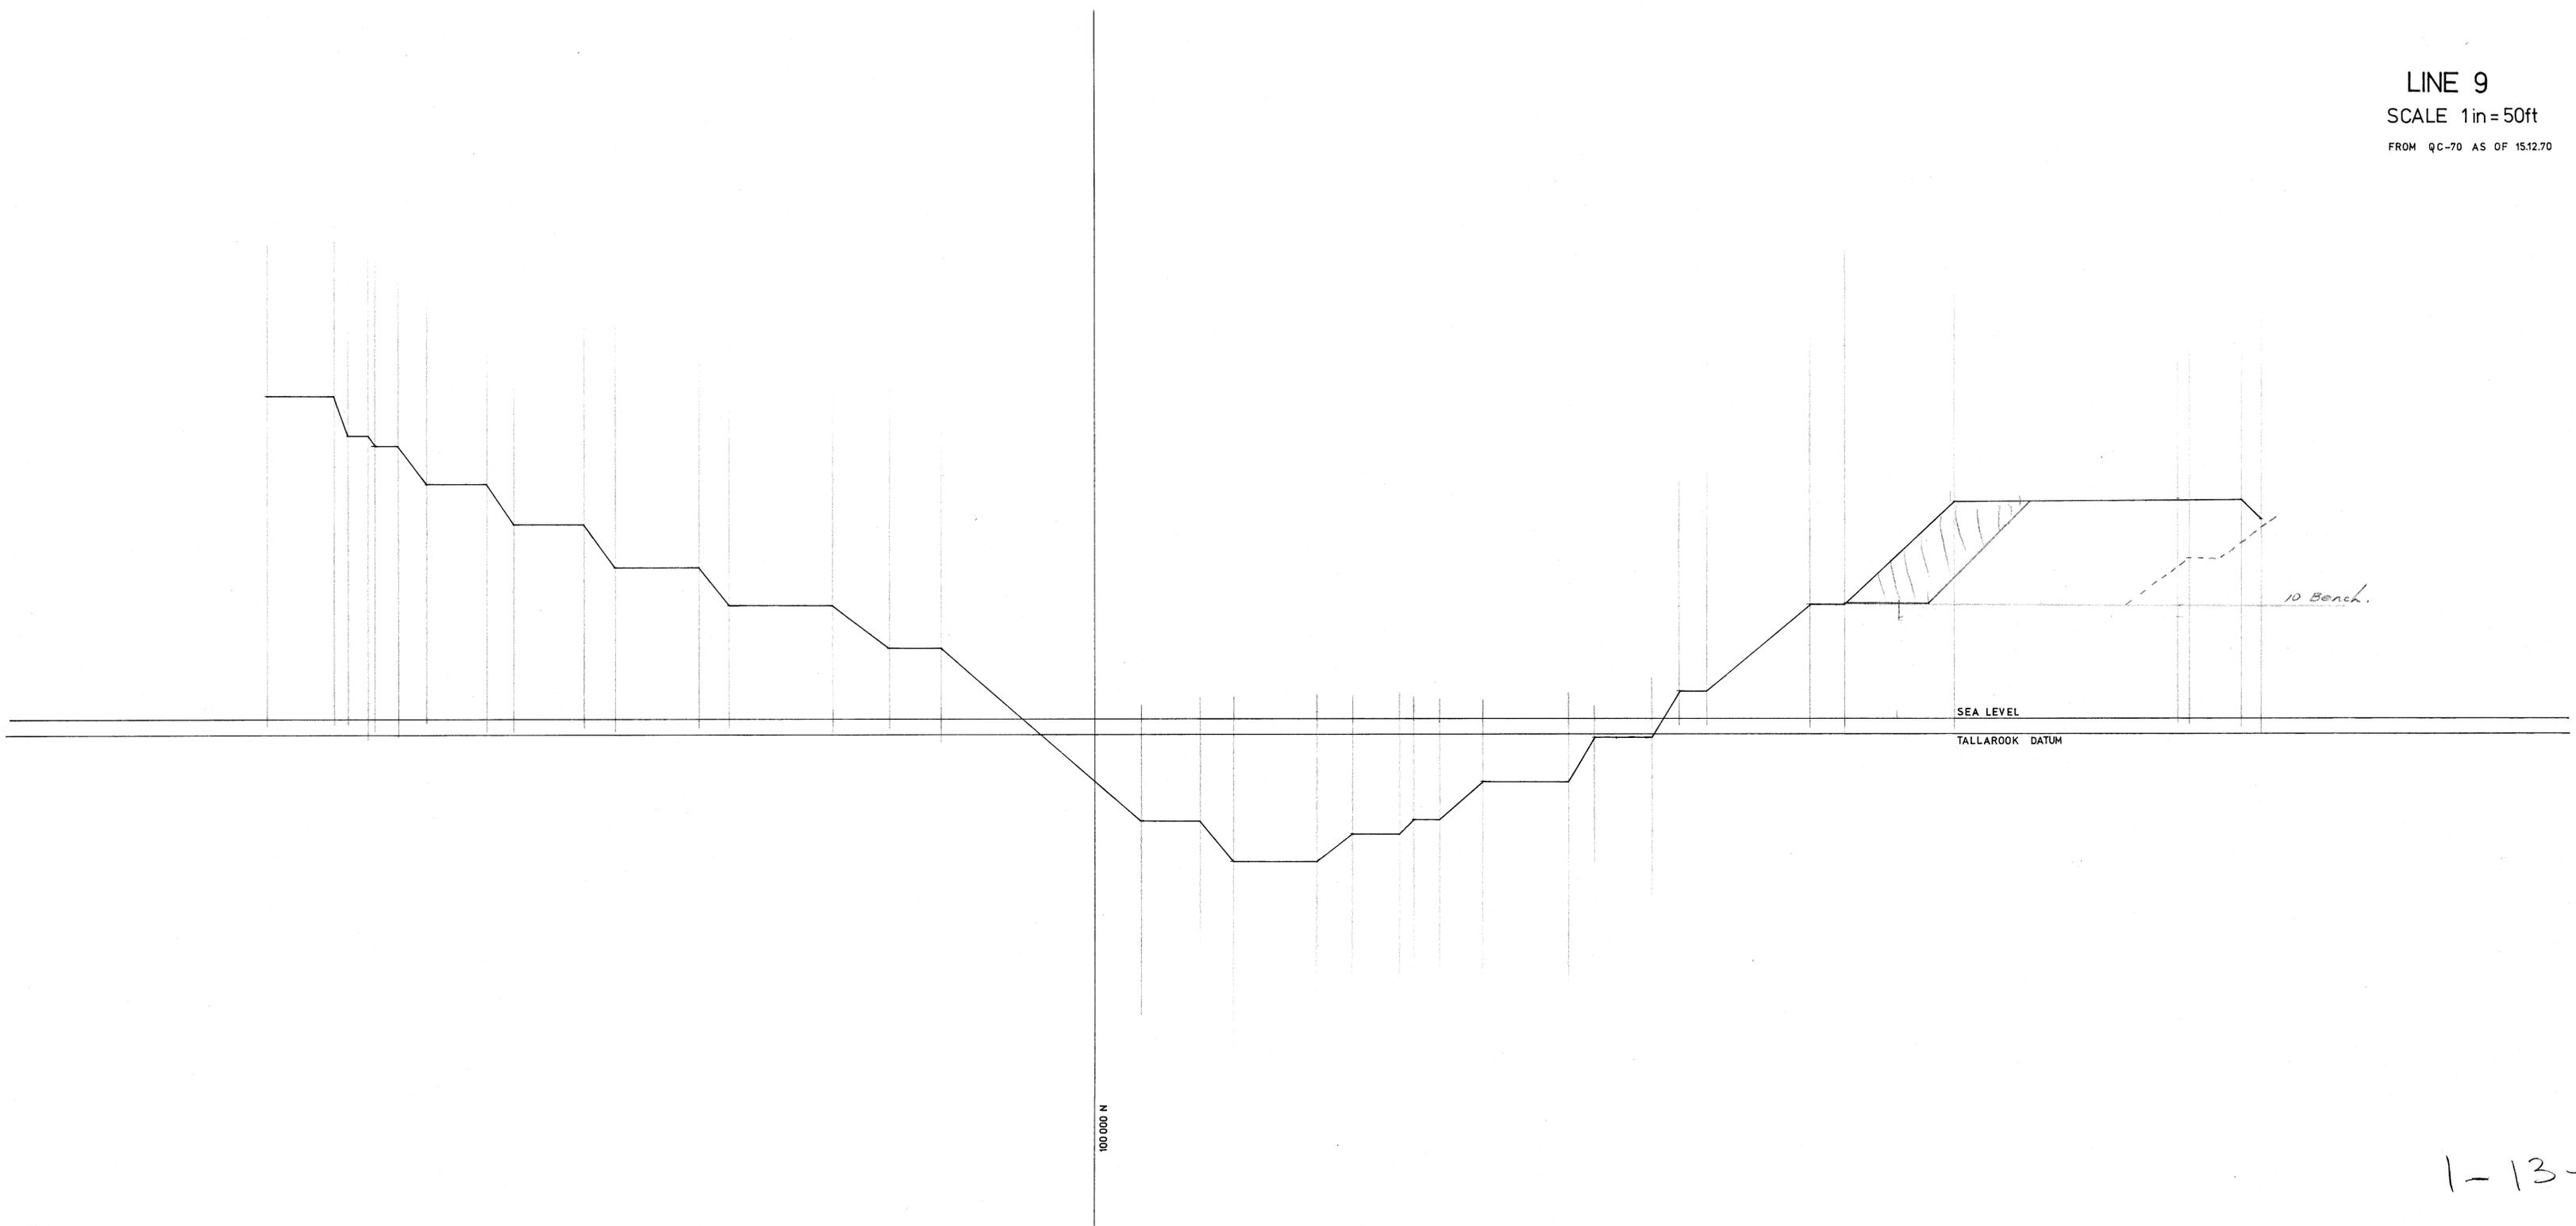

Roll 50  
ID. 2346

1-13-18