


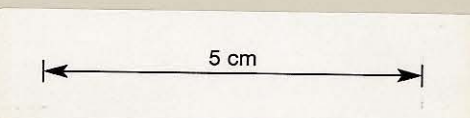

LETTER 30-6-1983
F.512-5-3

	SCALE 1:2500	north	LOCATION N° 6 TAILINGS DAM	KIS KING ISLAND SCHEELITE A DIVISION OF WARMAN INTERNATIONAL GRASSY KING ISLAND PLAN NUMBER
			SUBJECT TAILINGS DAM GENERAL LAYOUT AS AT 28/6/83	

0374_1989