
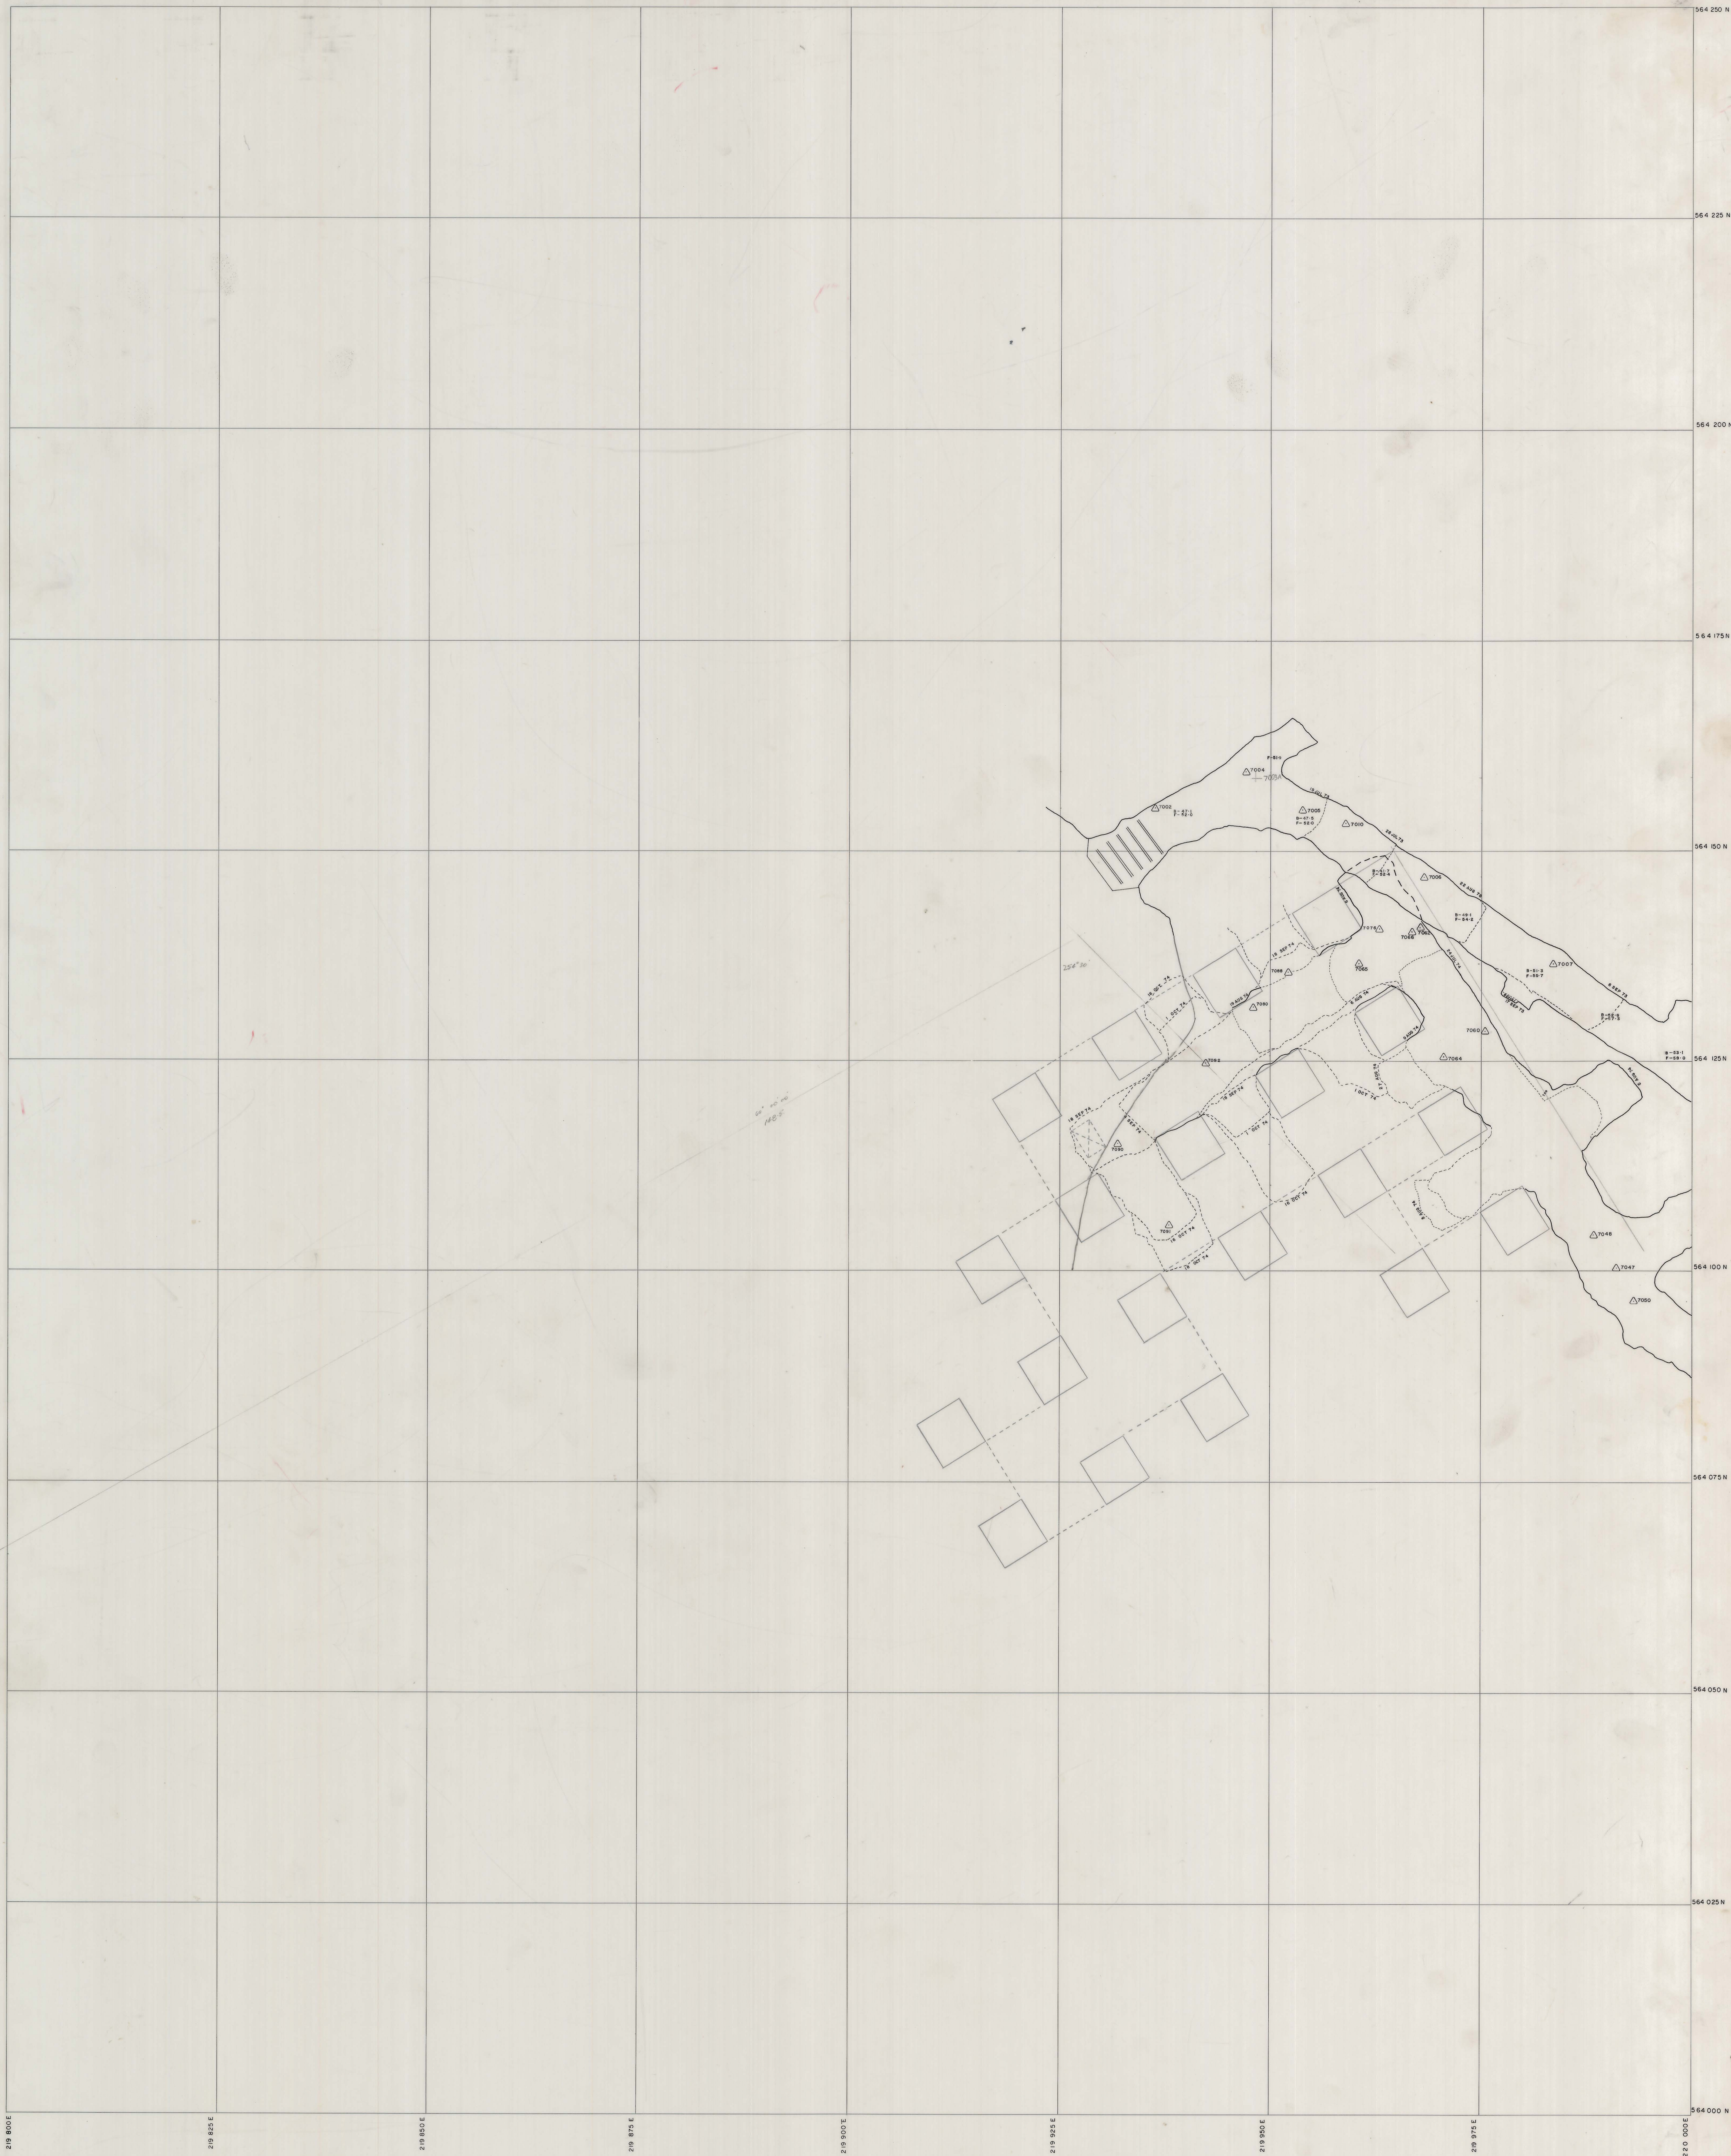


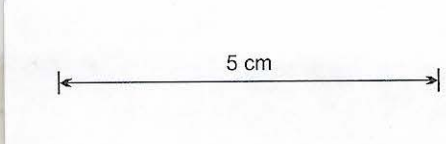

KING ISLAND SCHEELITE LTD.
DOLPHIN MINE

SCALE 1: 250