5 cm
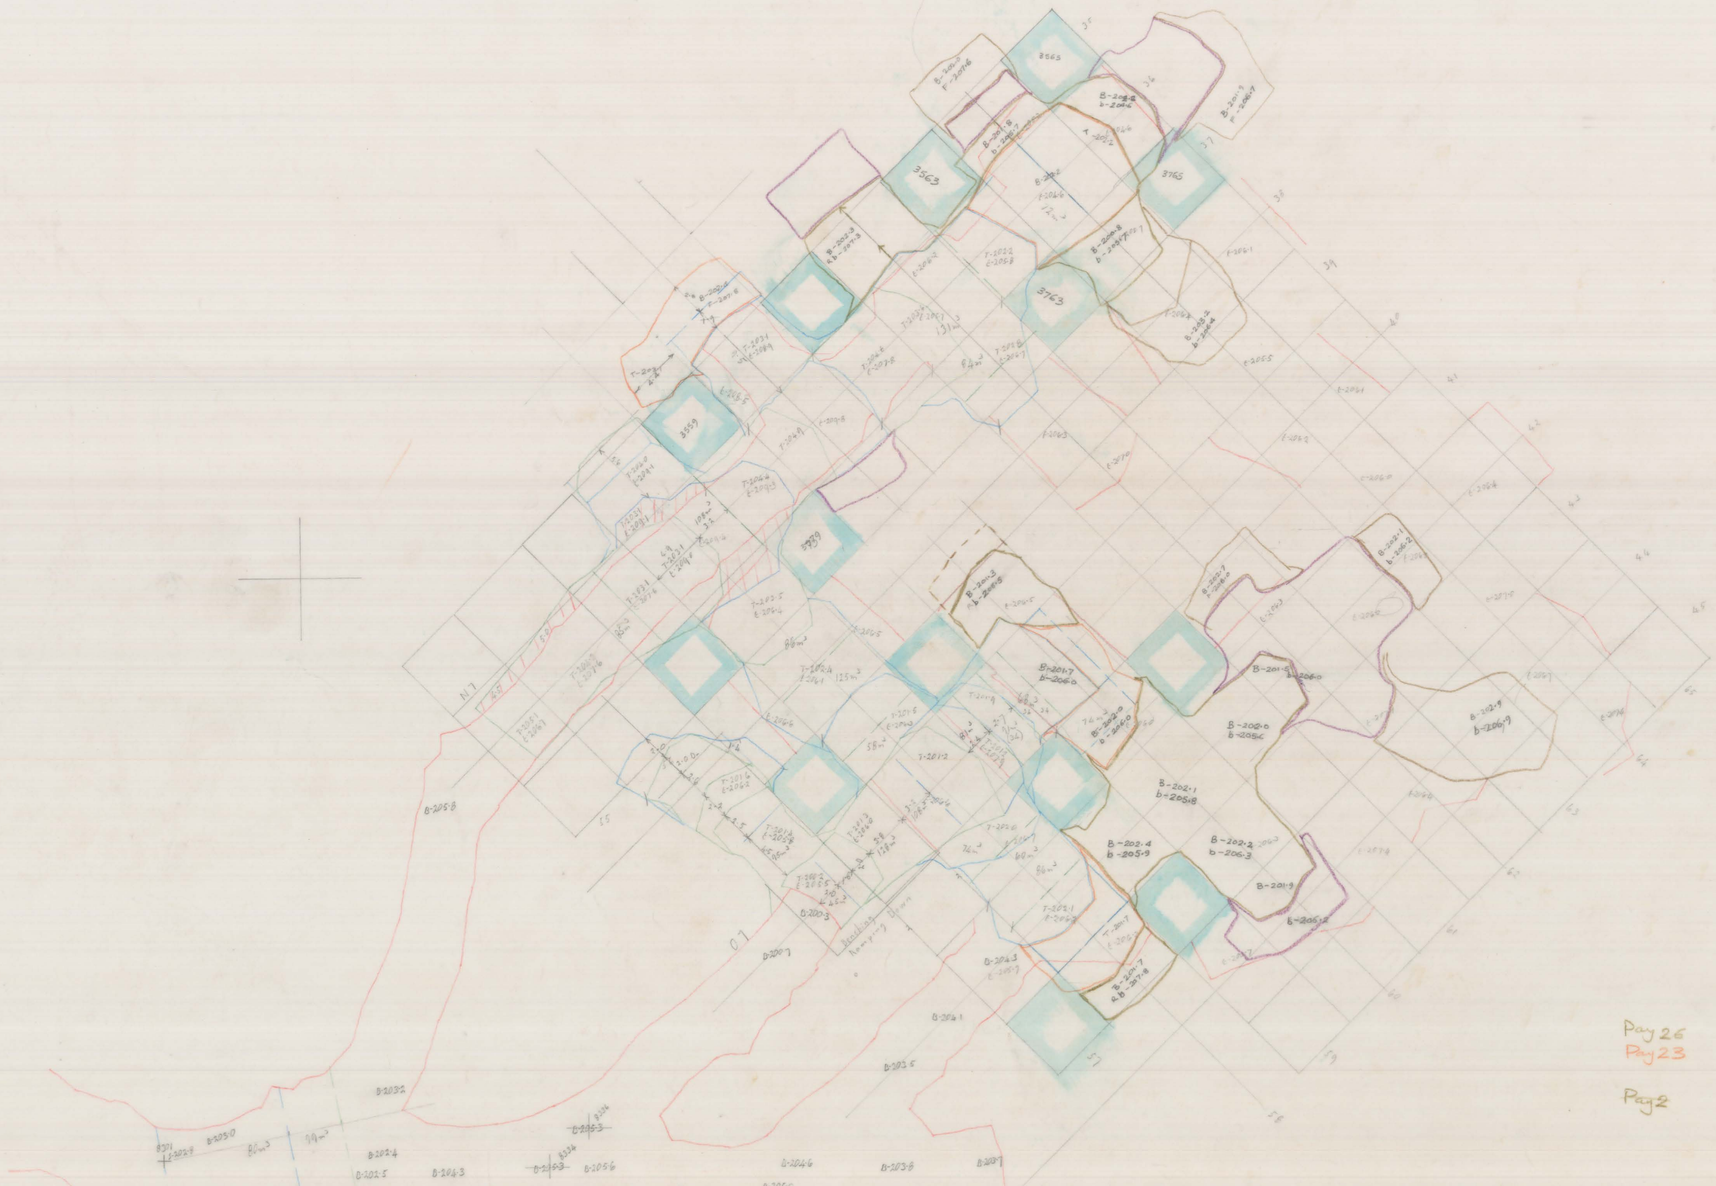
0374-1999