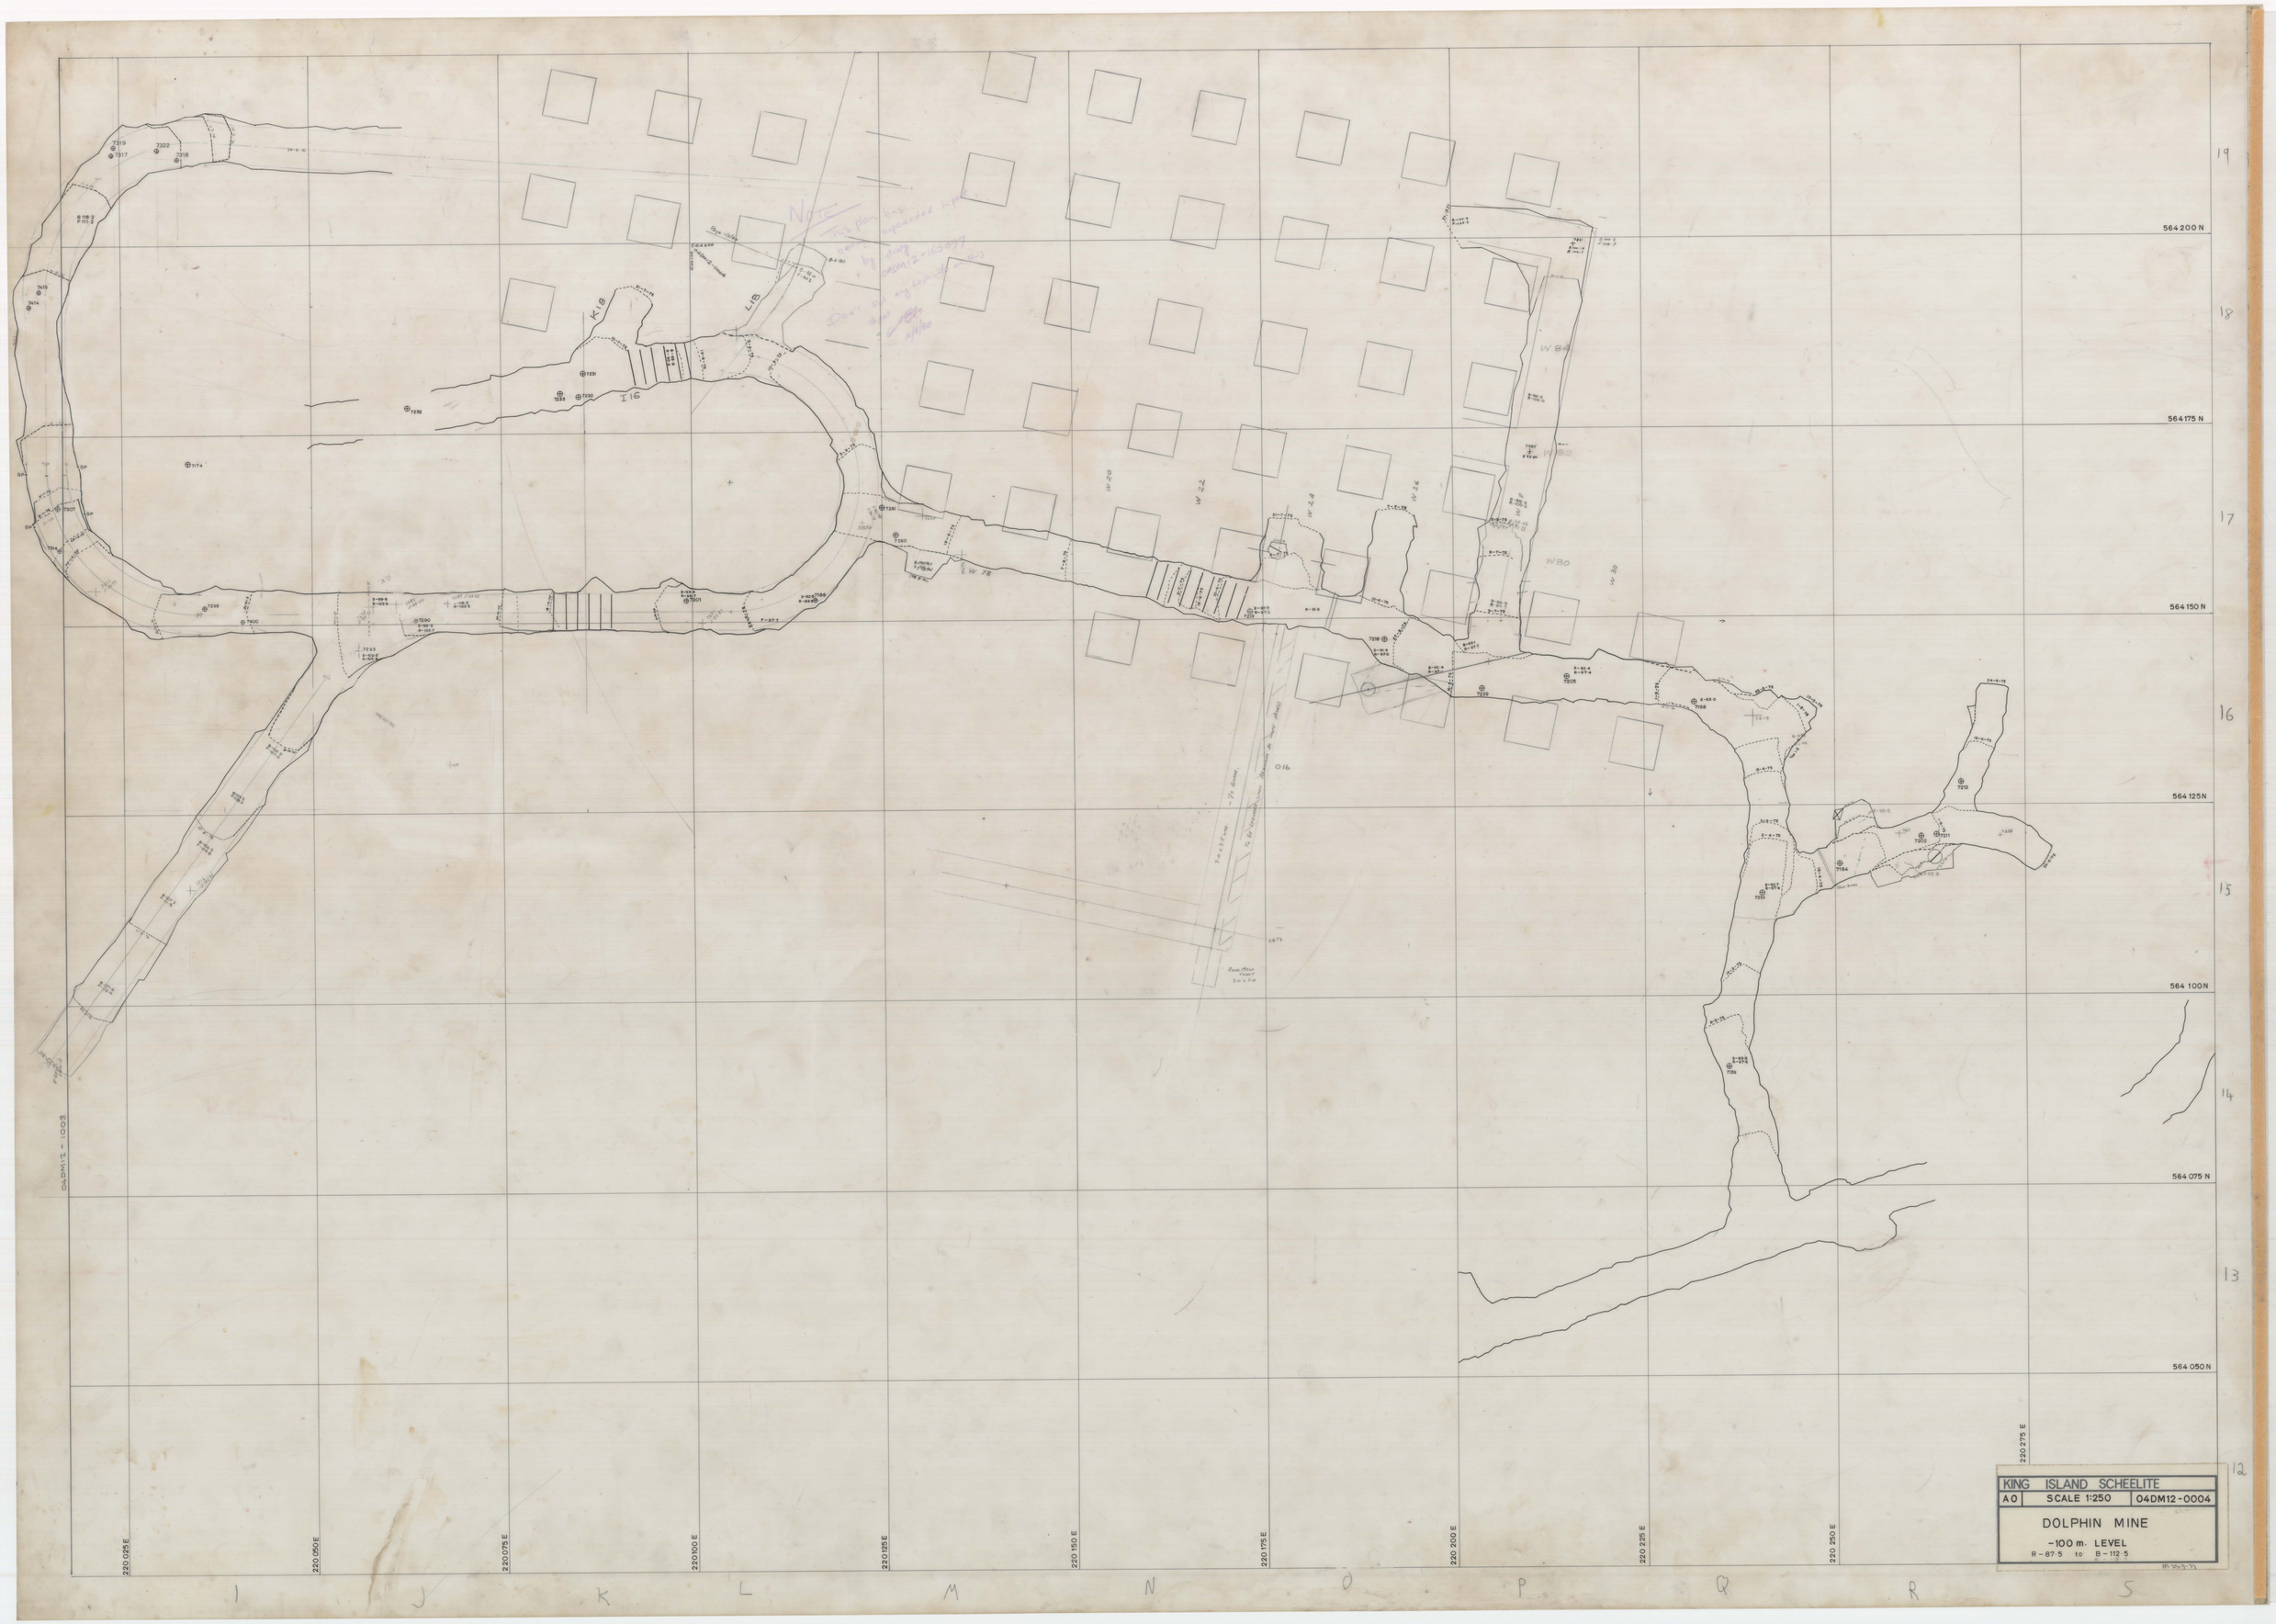

0374-2005

SUPERSEDED

04DM12-0004
DOLPHIN MINE
-100 m. LEVEL