27 JUN 1981

0374- 201

04BH15 - 105

P57
Undercut

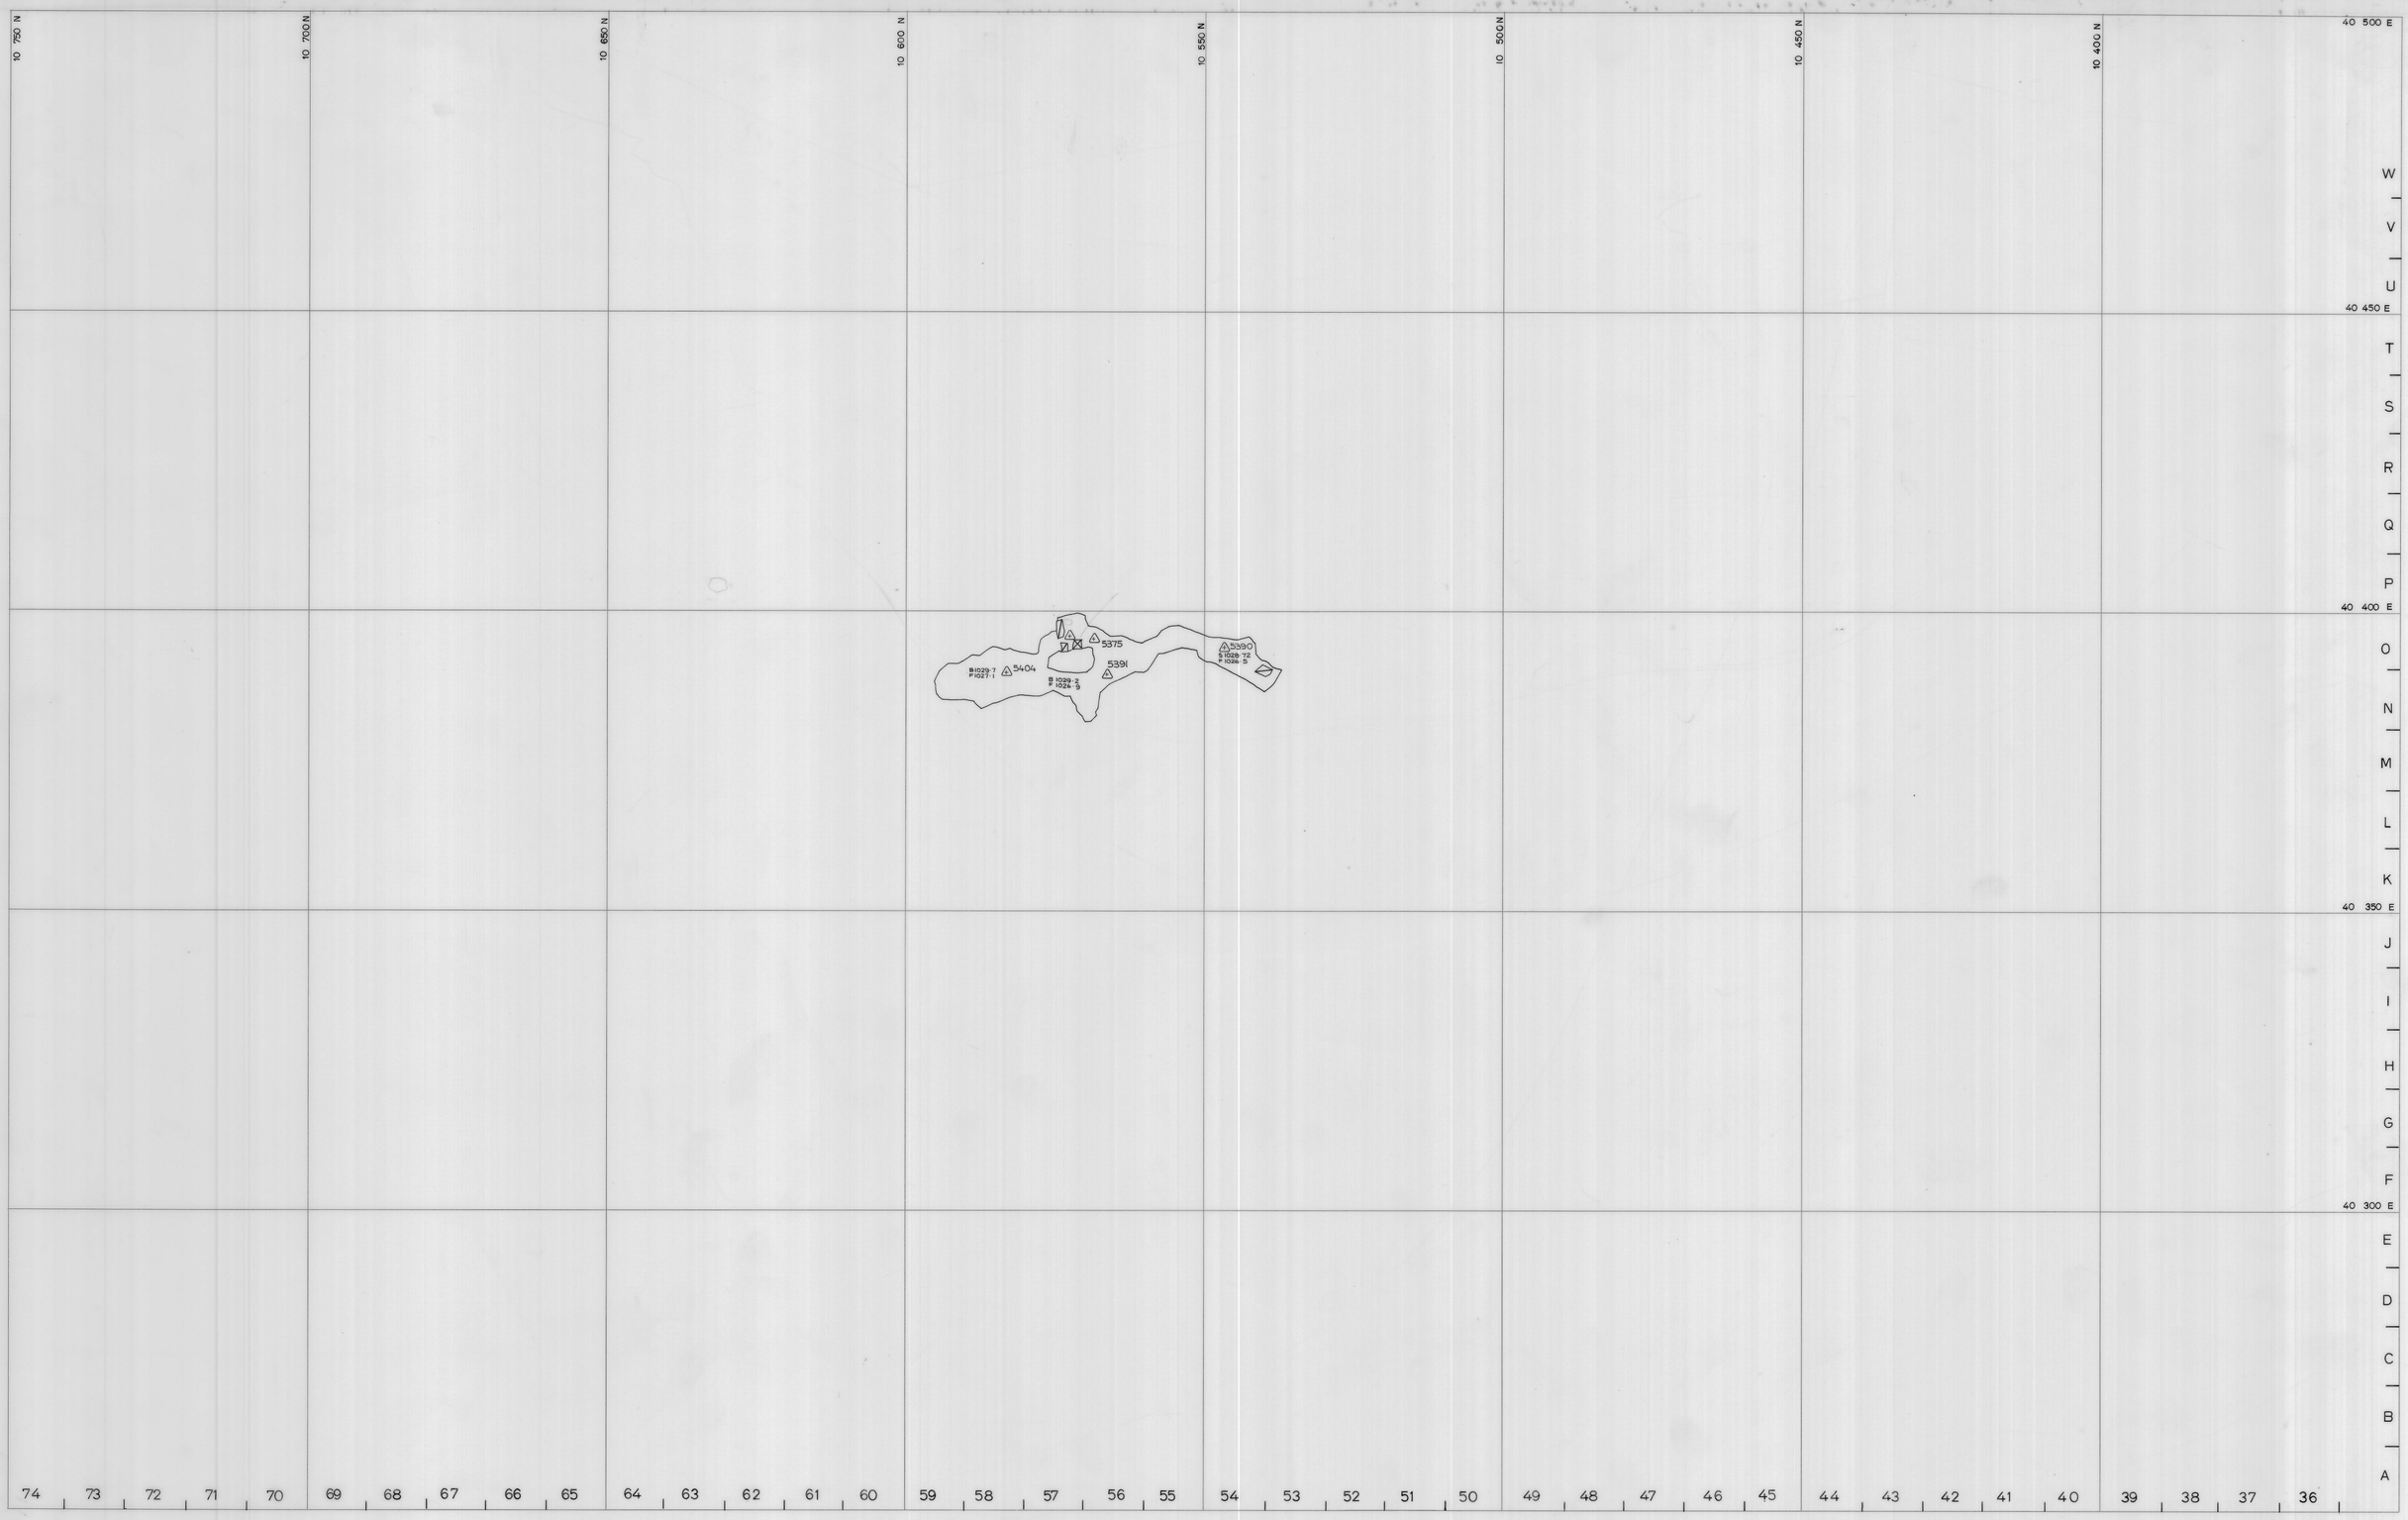

SCALE 1:500

5 cm

north

LOCATION
BOLD HEAD MINE

SUBJECT
P 57 STOPE
[Undercut]

KING ISLAND SCHEELITE
A DIVISION OF WARMAN INTERNATIONAL
GRASSY KING ISLAND

PLAN NUMBER
04BH15-105