0374_2012

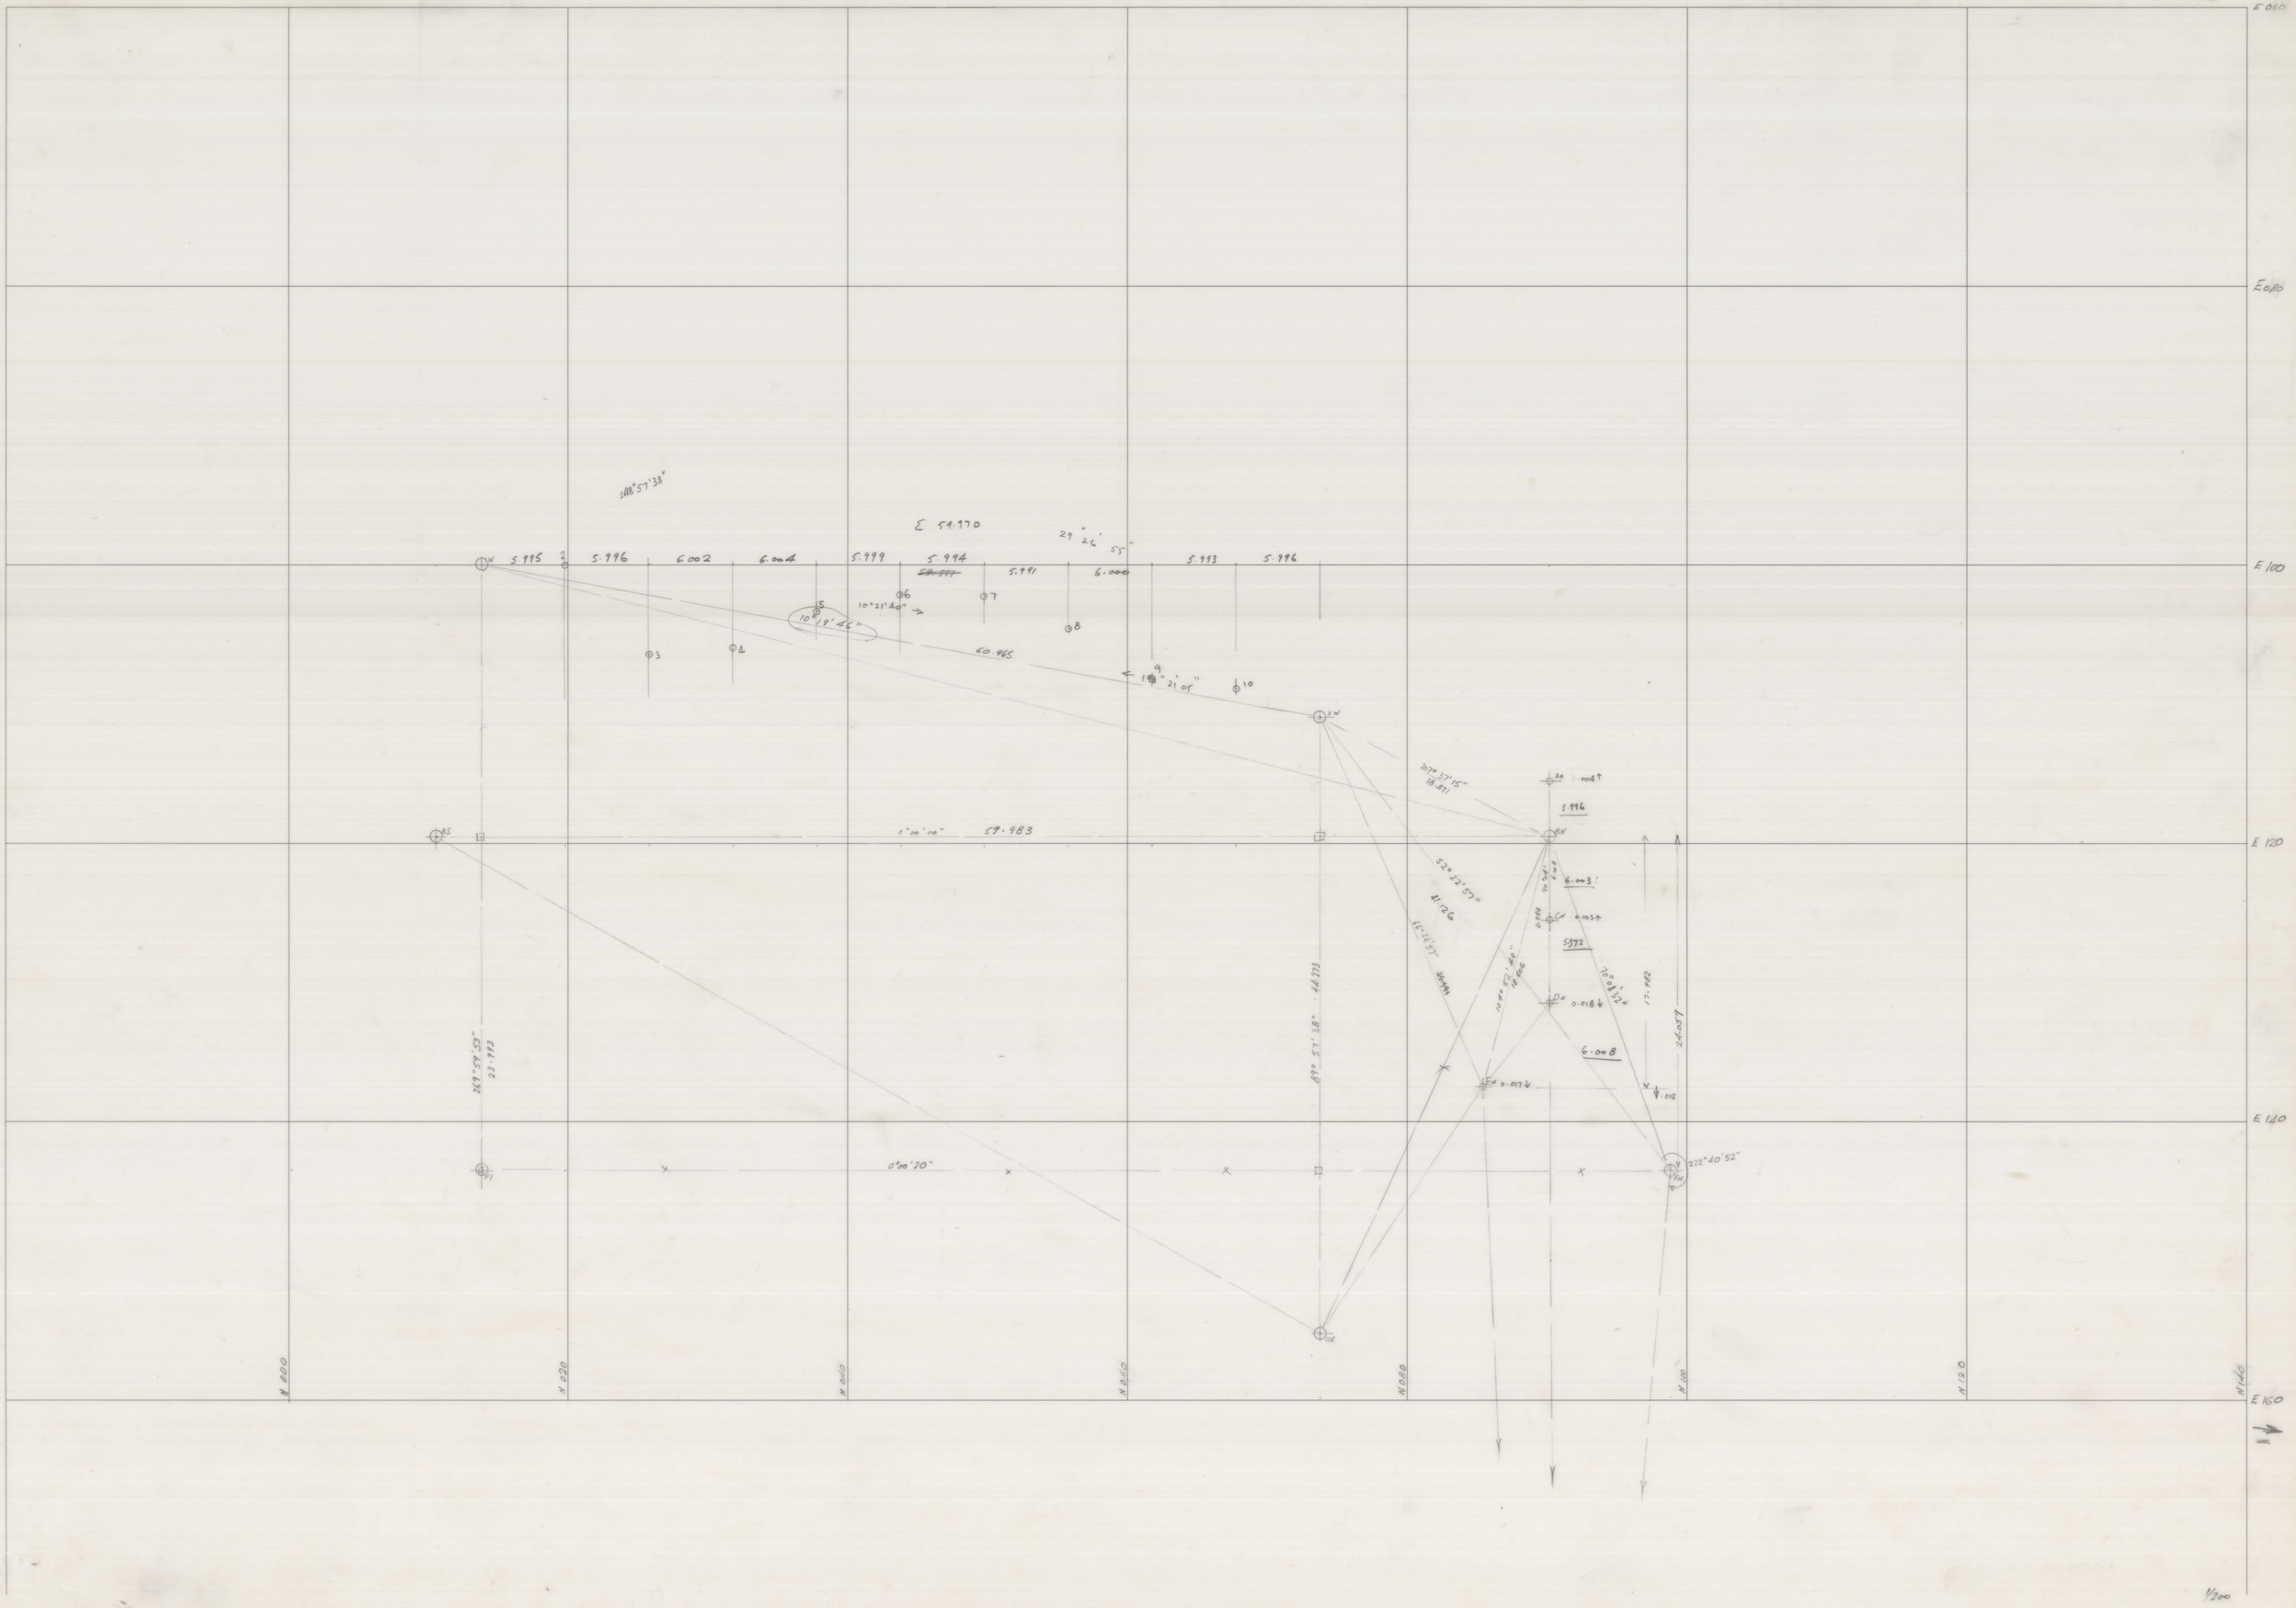
E 060
E 080
E 100
E 120
E 140
E 160
N 000
N 020
N 040
N 060
N 080
N 100
N 120
N 140
5.995
5.996
6.002
6.004
5.999
5.994
5.991
6.000
5.993
5.996
Σ 54.970
29° 26' 55"
10°21'40"
10° 9' 45"
60.945
10° 21' 05"
0°00'00"
59.983
89° 57' 38"
14.173
89°59'53"
23.993
0°00'20"
52° 22' 57"
41.26
10° 57' 15"
18.371
5.996
6.003
5.972
6.008
17.442
24.057
222° 40' 52"
1/200