27 JUN 1981

5 cm

04 DM13-1020

C WEDGE

119

0374_2021

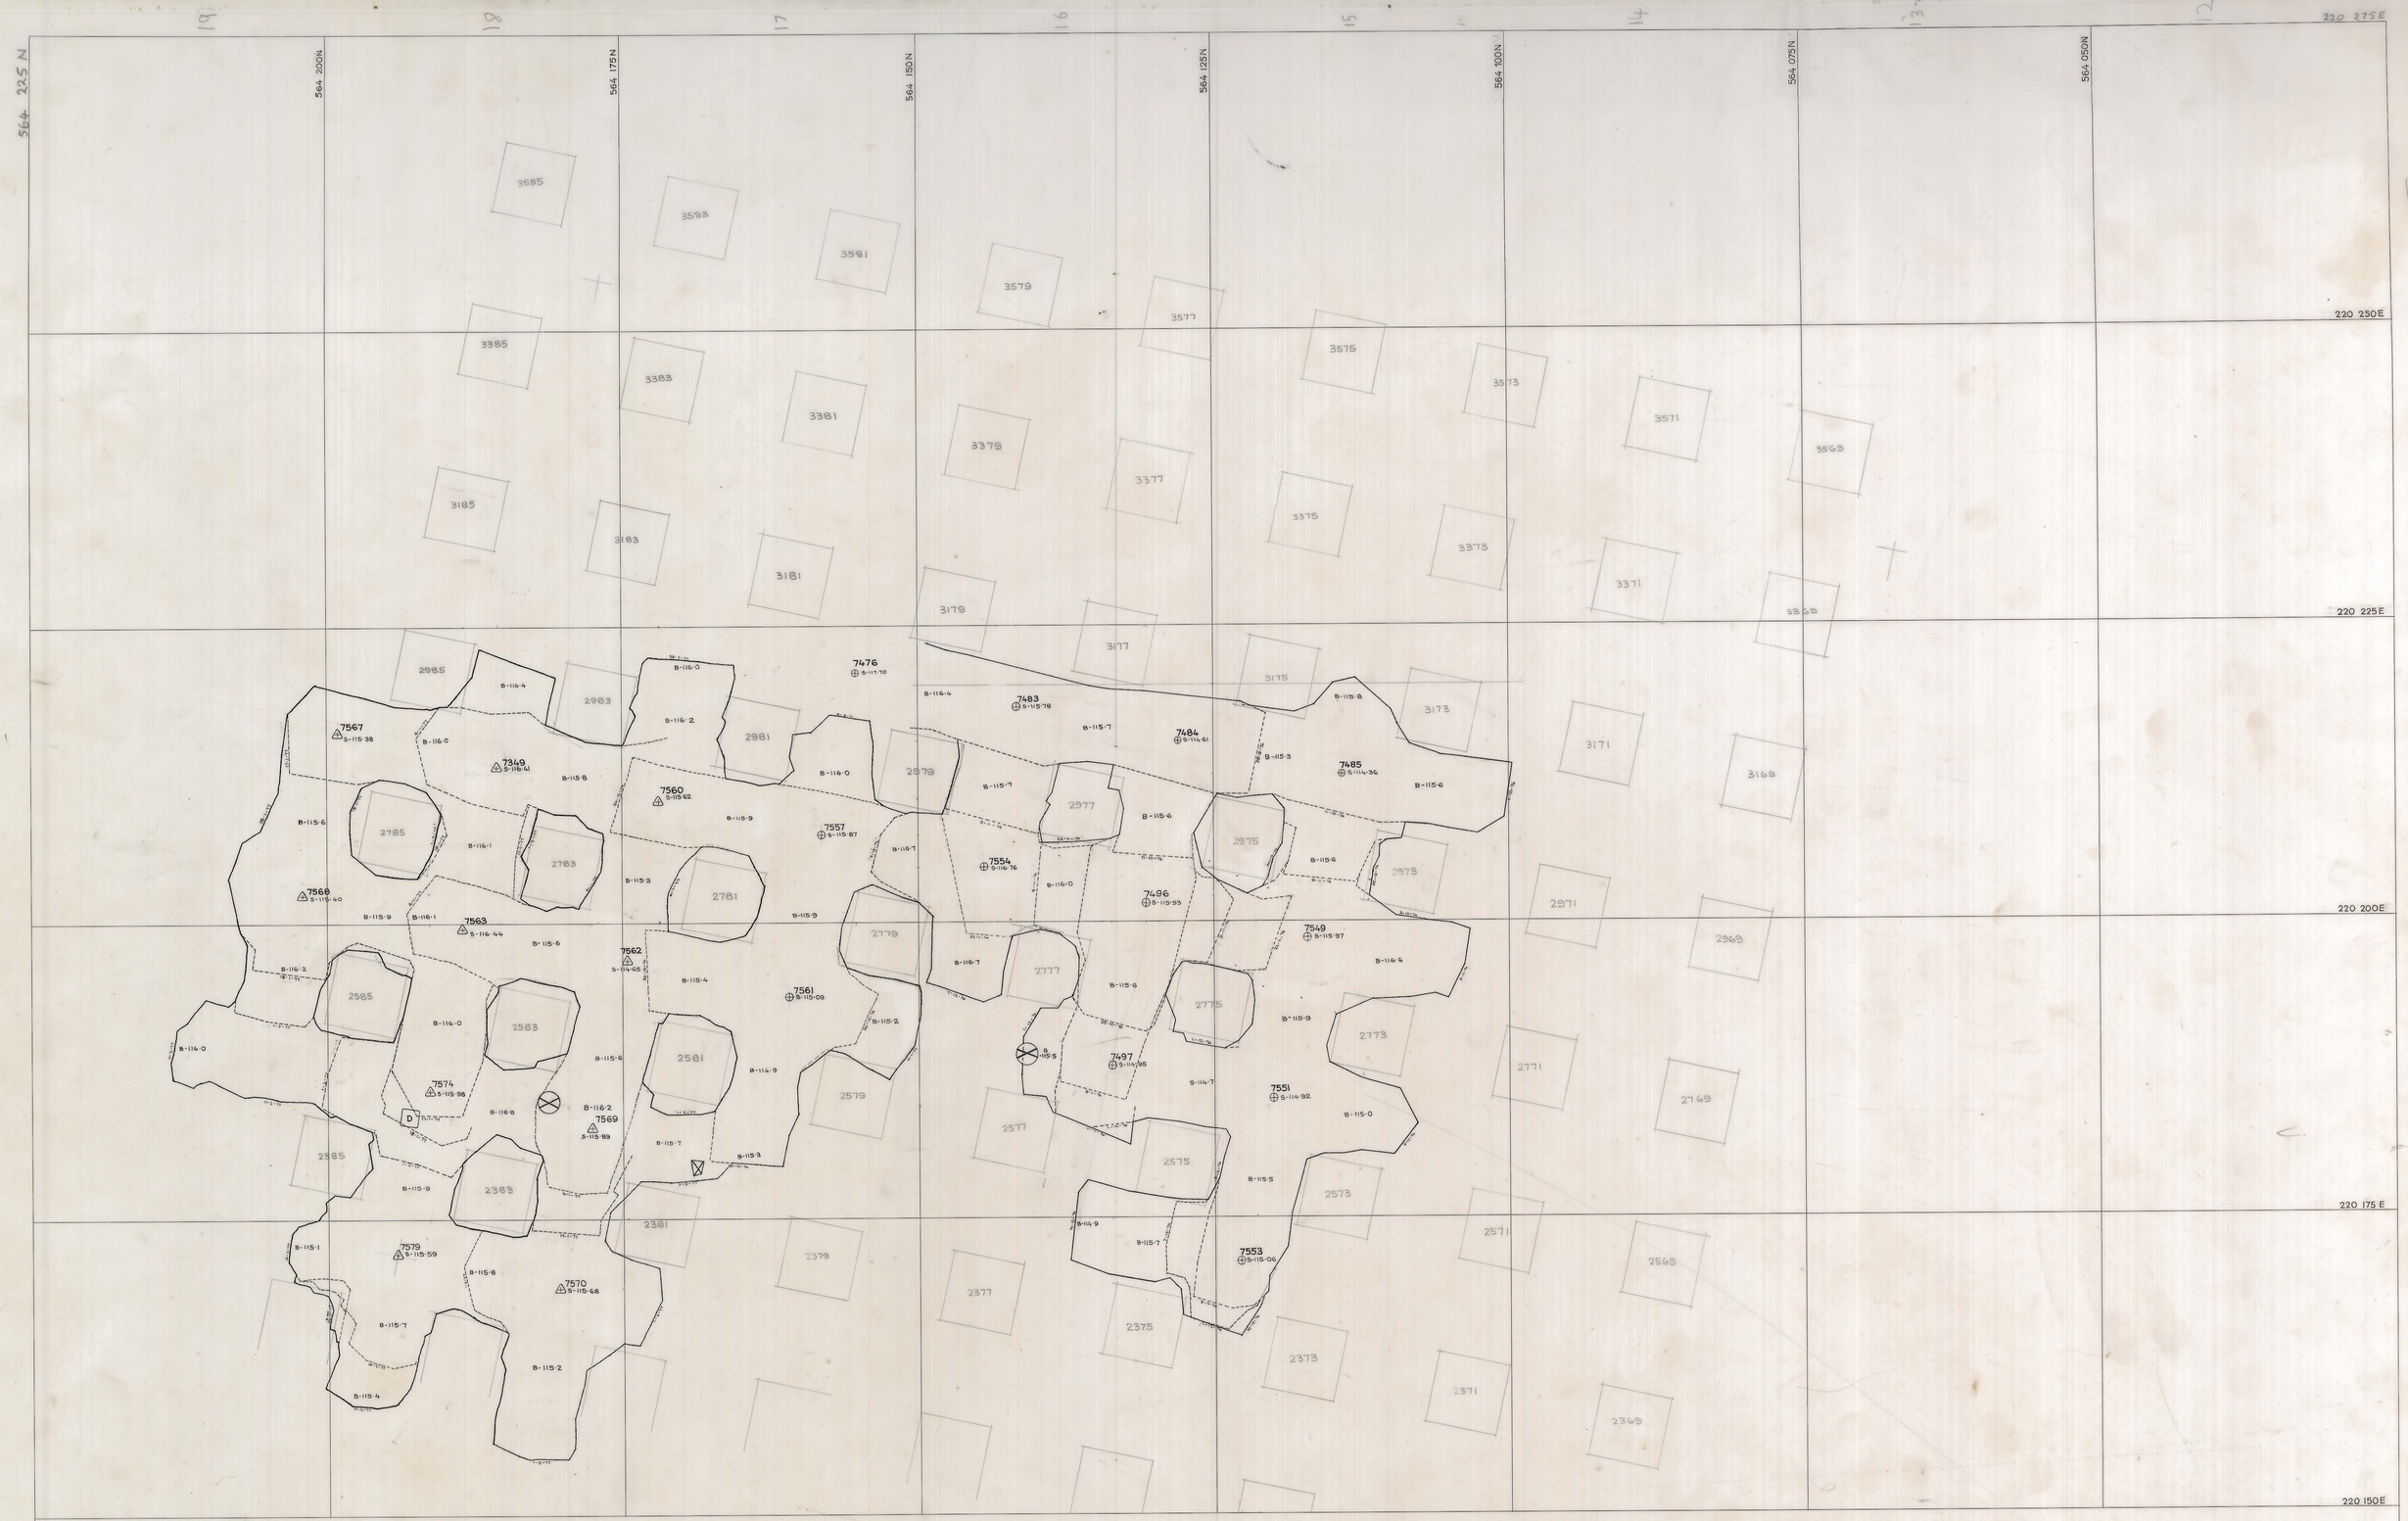

LINE	BEARING	H. D.	LATITUDE	DEPARTURE	R.L.	STN

SCALE 1:250

north

LOCATION: DOLPHIN MINE

SUBJECT: 'C' LENS WEDGE
-119m CONTOUR

KIS KING ISLAND SCHEELITE
A DIVISION OF WARMAN INTERNATIONAL

GRASSY KING ISLAND

PLAN NUMBER: 04DM13 - 1020

M-23-3-79