5 cm

27 JUN 1981

04DM12-1003

-125m ZONE

0374-2033

04DM12-1003

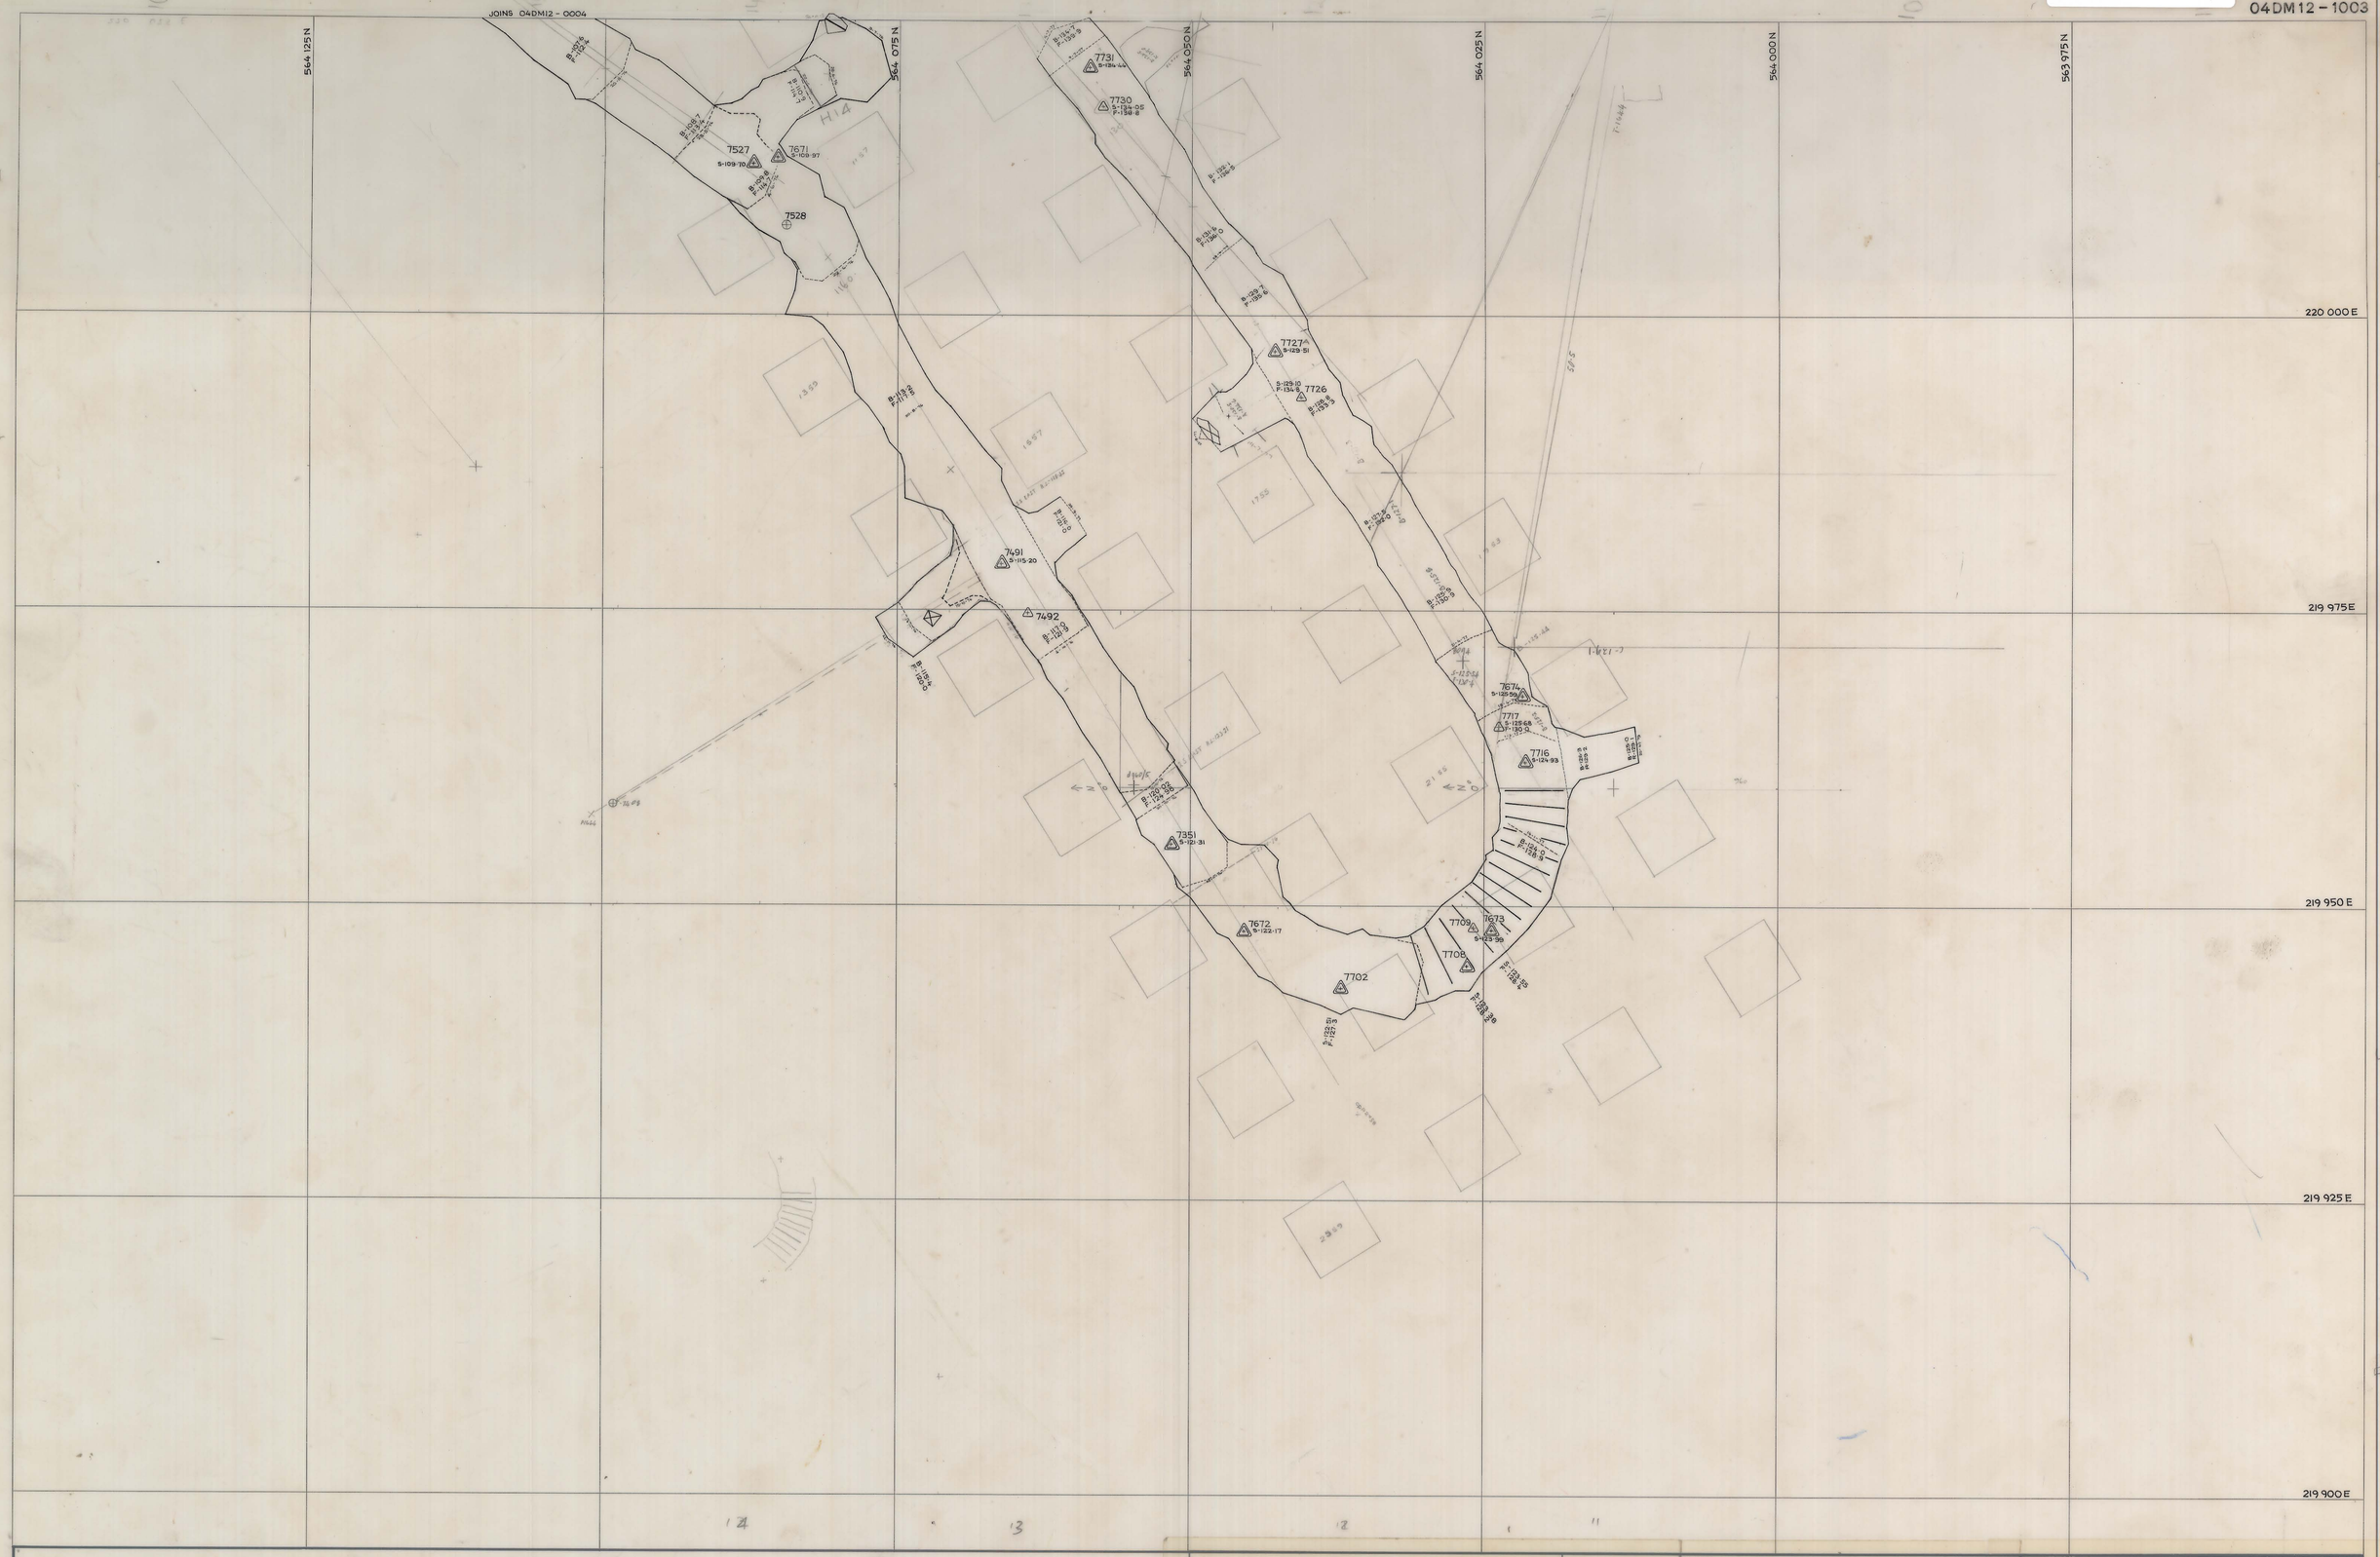

SCALE 1:250

north

LOCATION: DOLPHIN MINE

SUBJECT: -125m ZONE

F-112 to B-137

KING ISLAND SCHEELITE
A DIVISION OF WARMAN INTERNATIONAL

GRASSY KING ISLAND

PLAN NUMBER: 04DM12 - 1003

M-23-3-79