5 cm

04DM15-155102

CENTRAL STOPE
L/A-15
-96.5

0374_2056

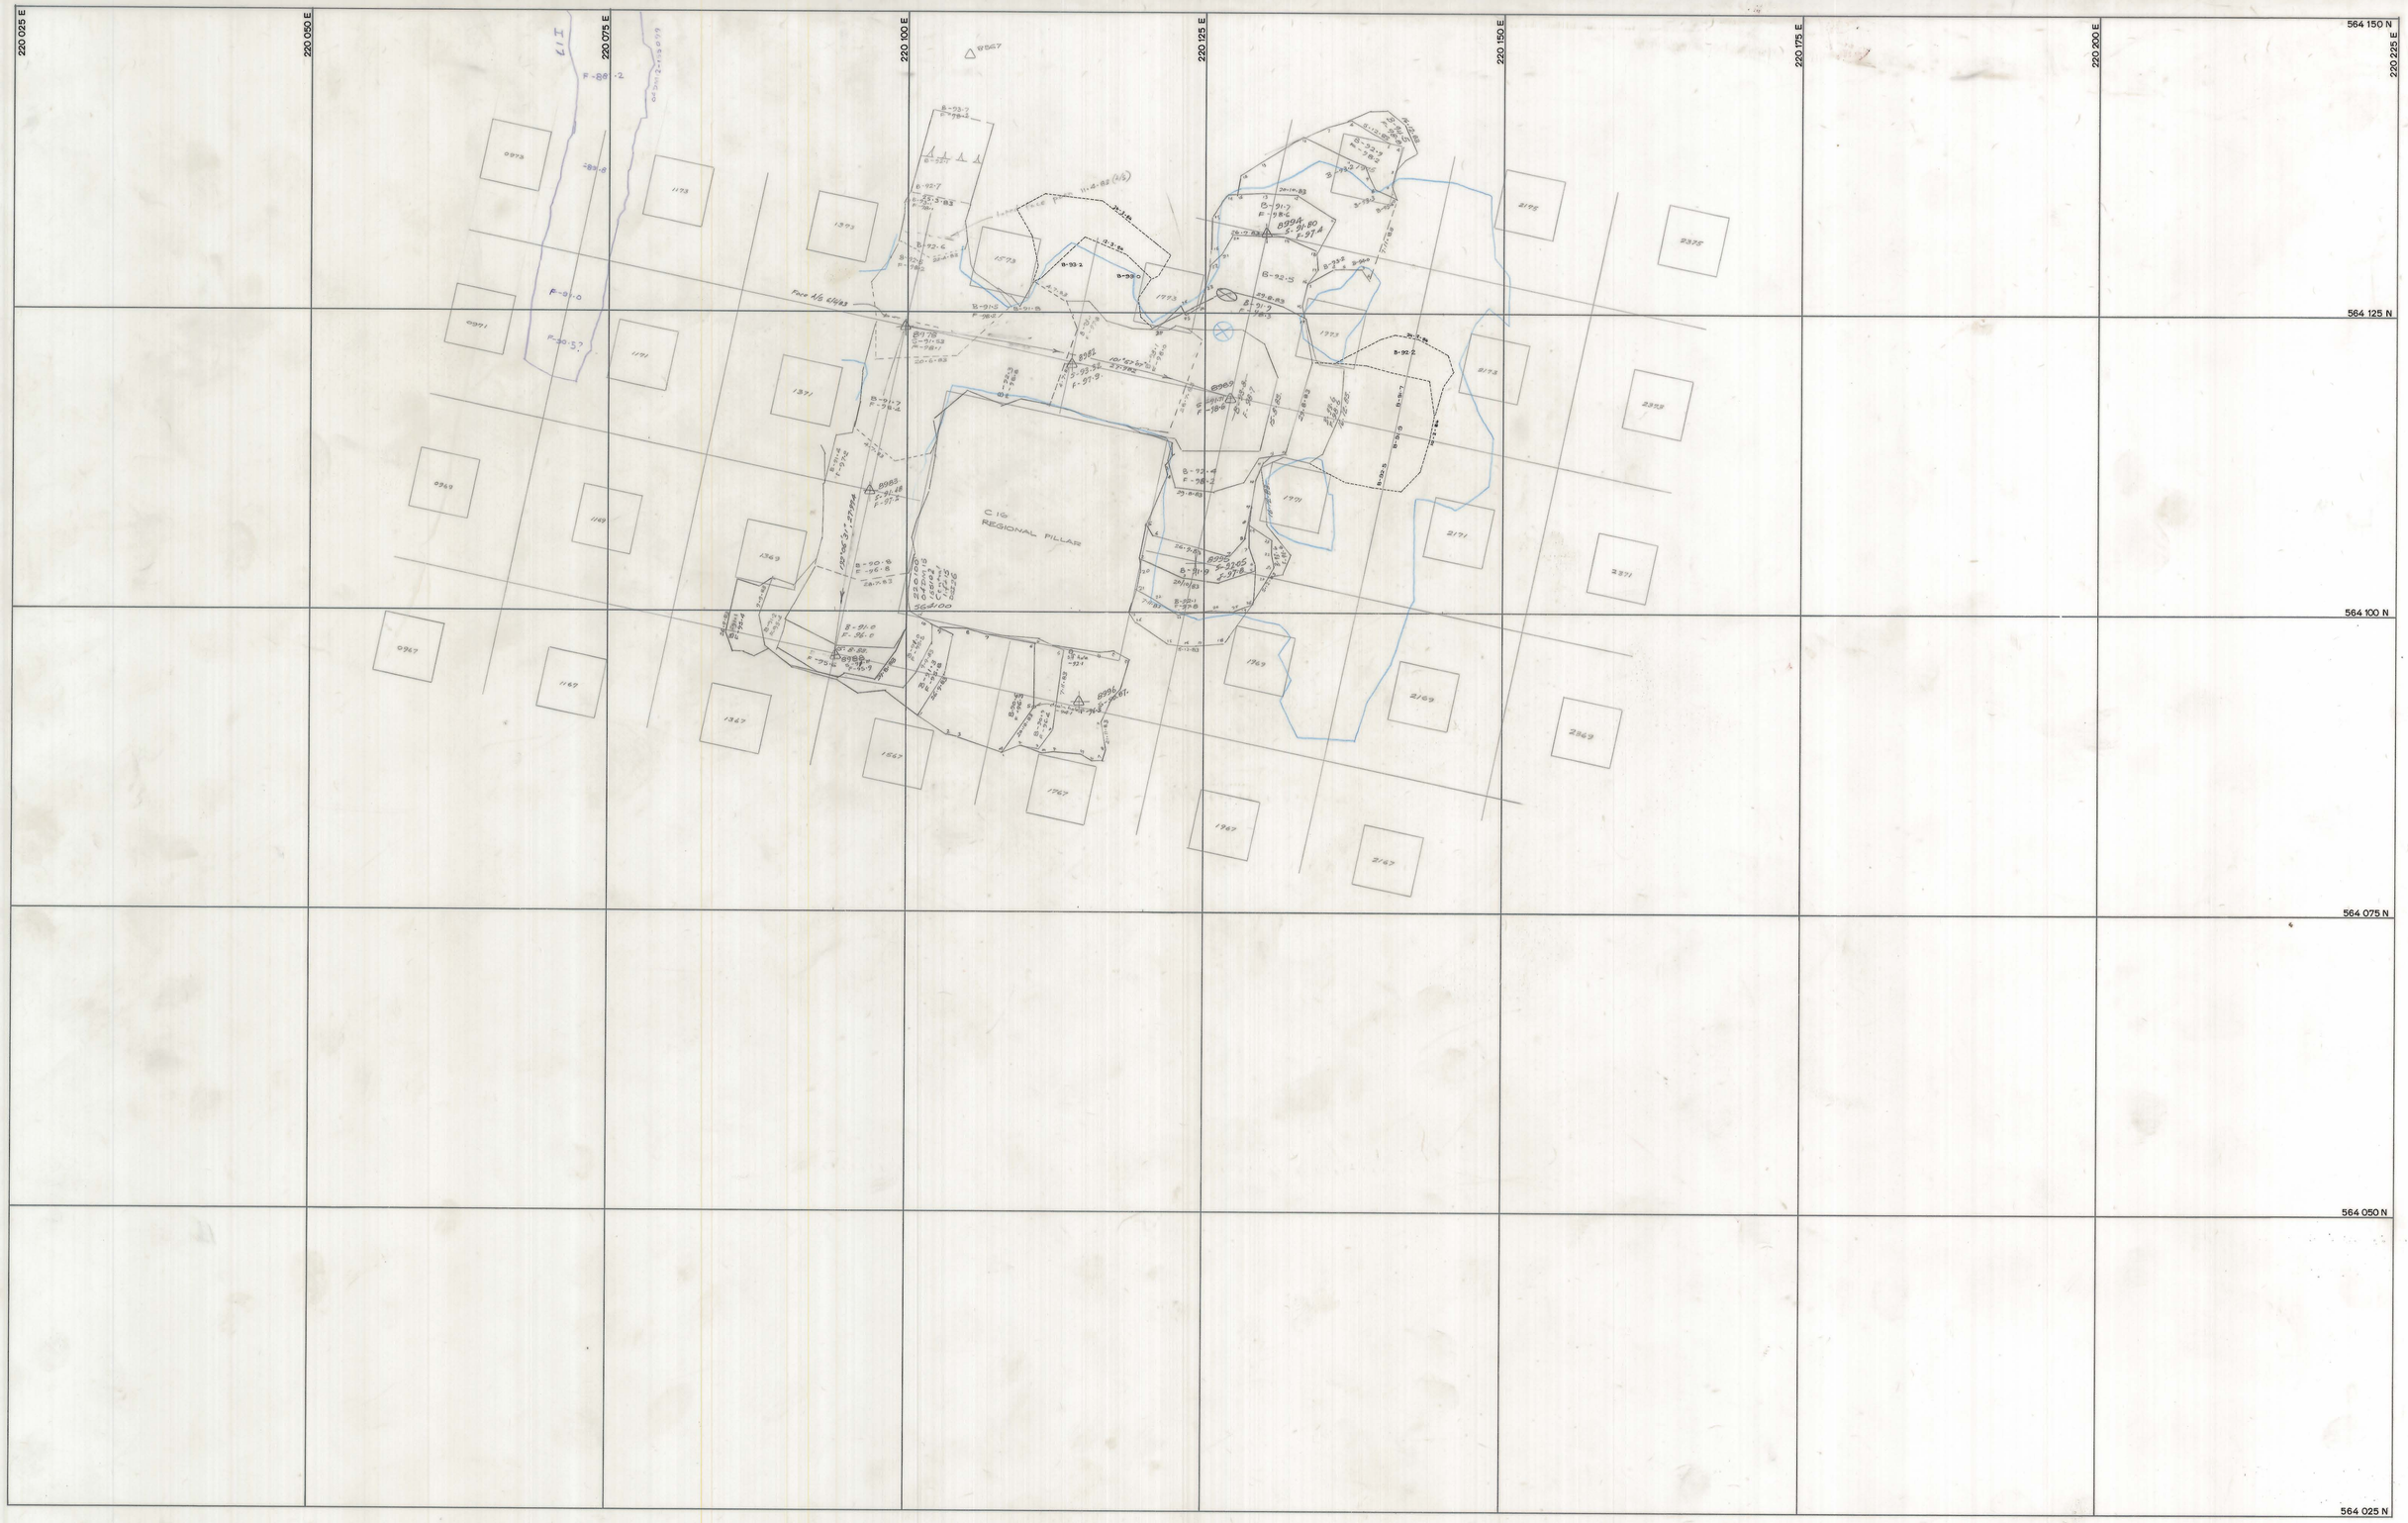

SCALE 1: 250

DSF 26

north

LOCATION
DOLPHIN MINE

SUBJECT
CENTRAL STOPE
-96.5 m contour
Lift 15

KING ISLAND SCHEELITE
A DIVISION OF WARMAN INTERNATIONAL

GRASSY KING ISLAND

Gol MAPSI
PLAN NUMBER
04DM15 - 155102