27 JUN 1981

04DM13- 155 107

DM
Central Stope
110-5

0374-2064

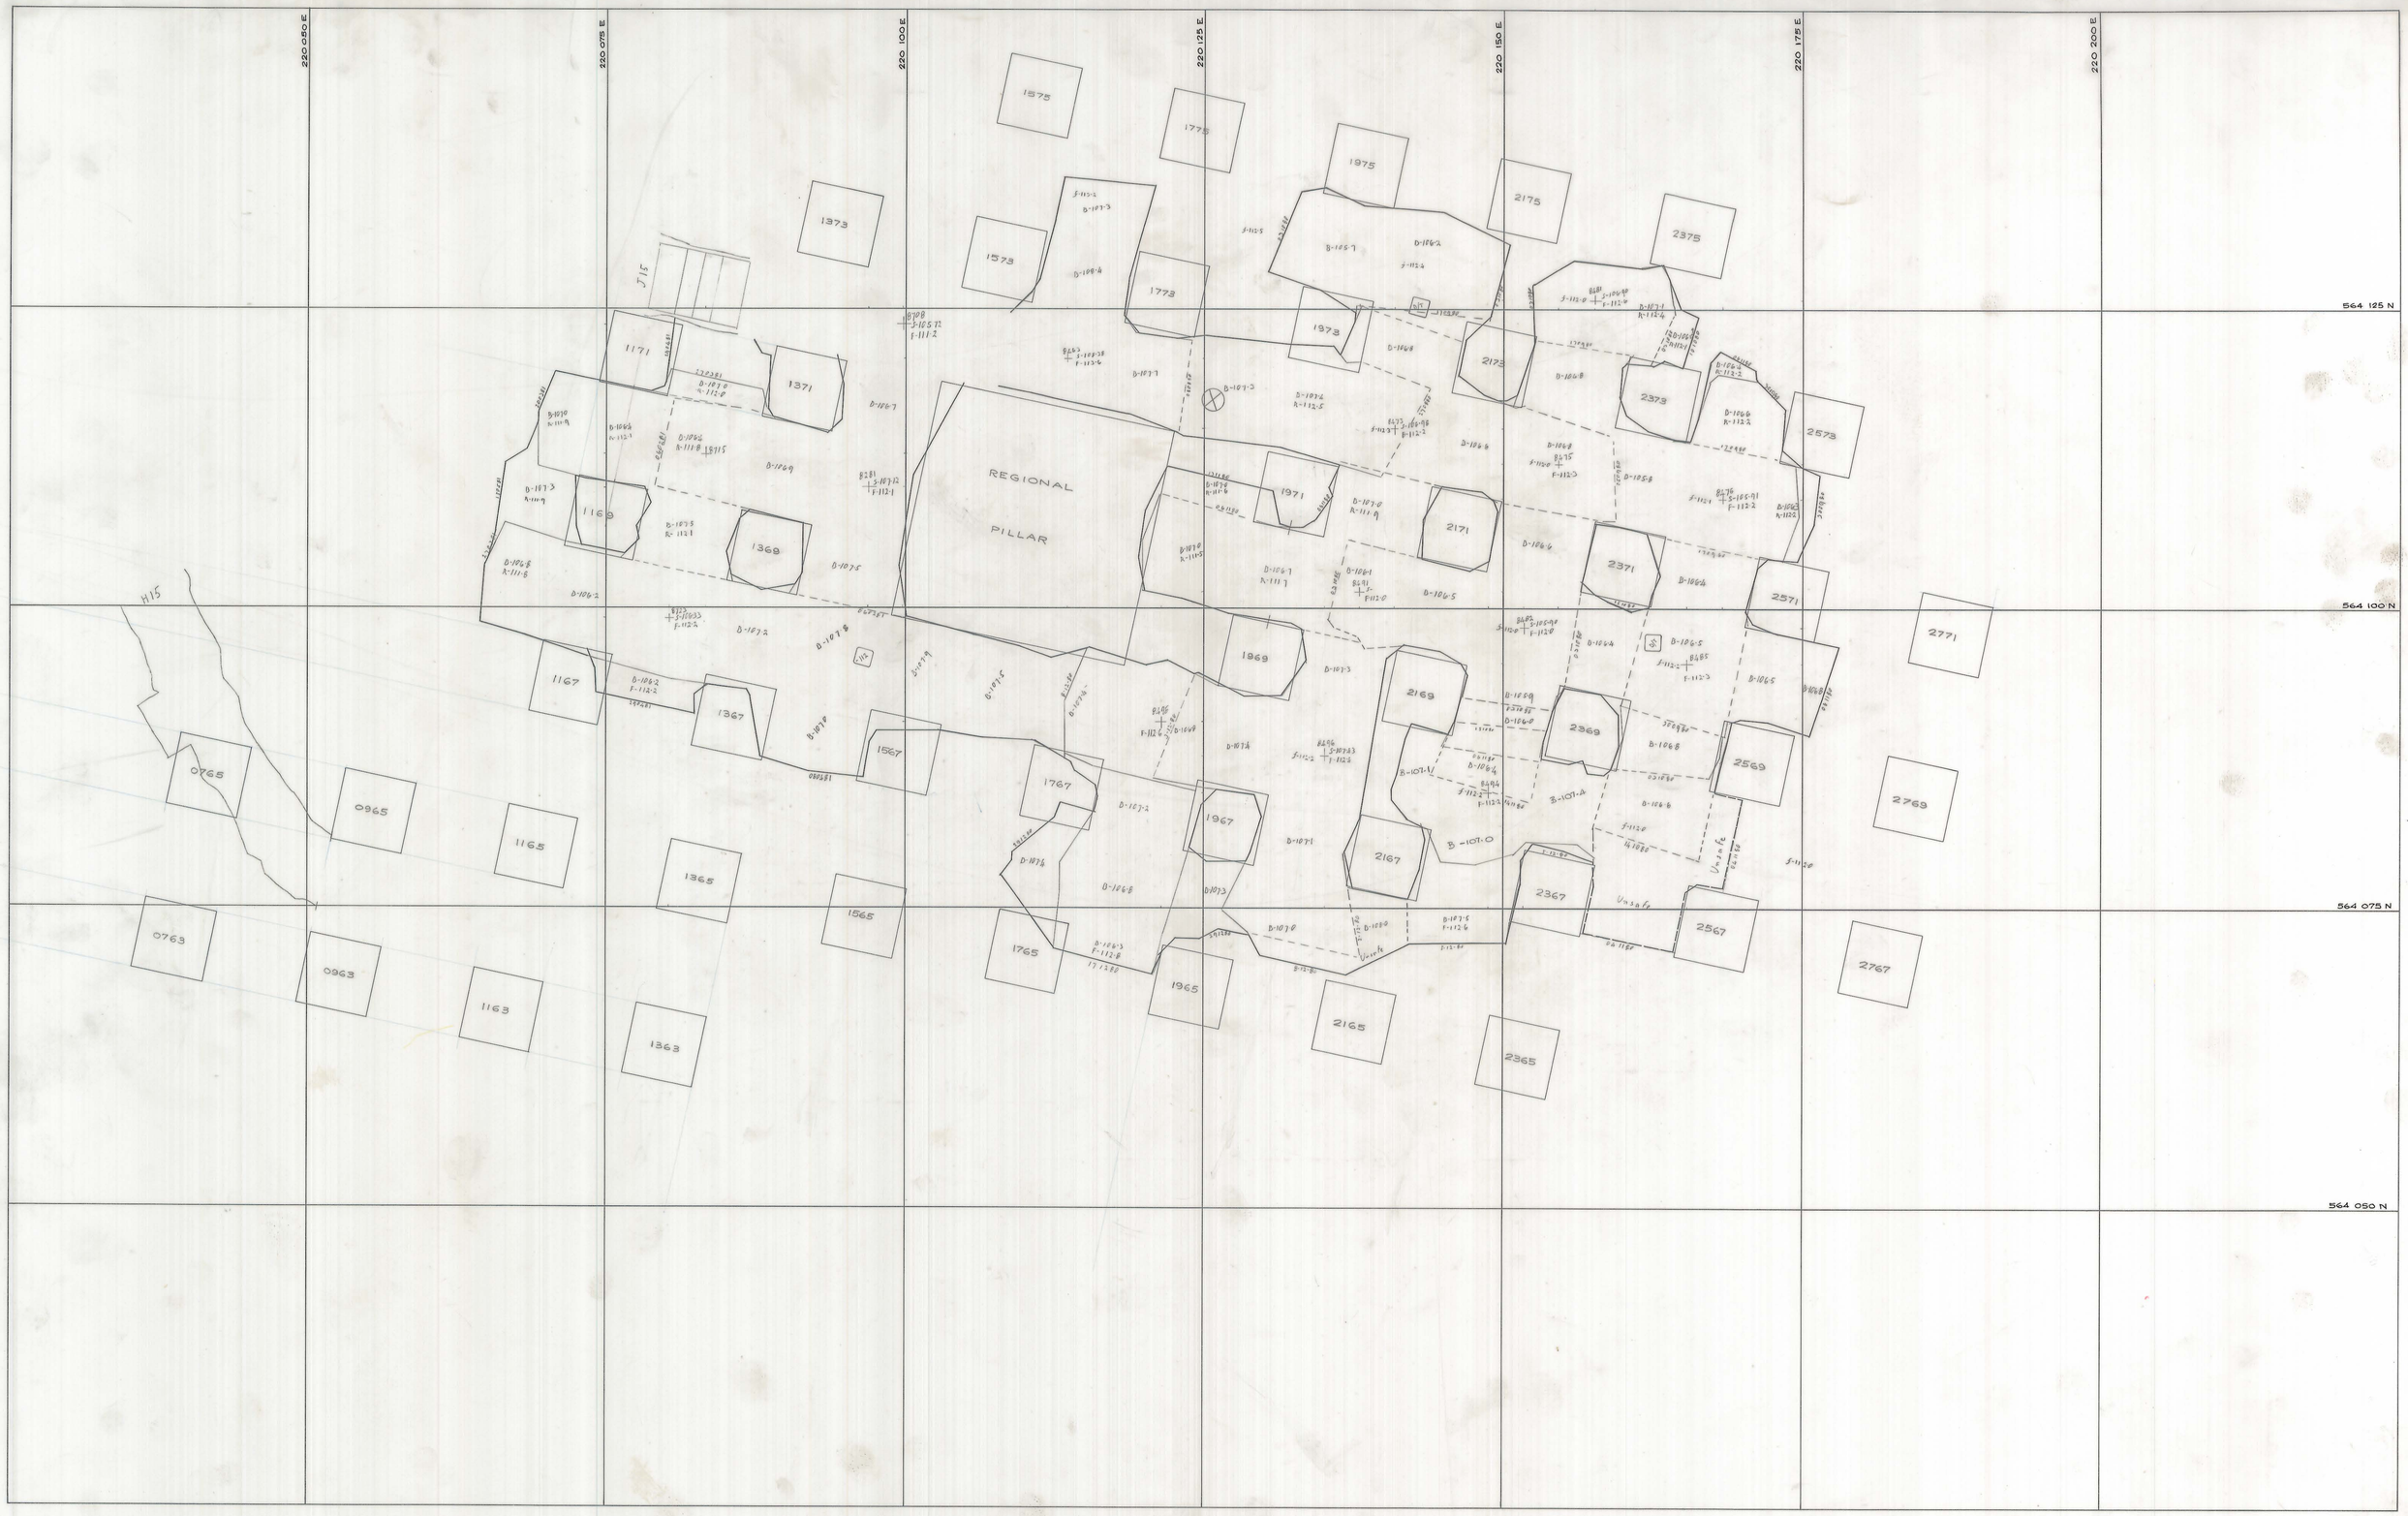

	SCALE 1:250	north	LOCATION: DOLPHIN MINE
	LIFT Nº 11		SUBJECT: C CENTRAL STOPE -110·5 CENTRAL STOPE

KING ISLAND SCHEELITE
A DIVISION OF WARMAN INTERNATIONAL
GRASSY KING ISLAND

PLAN NUMBER 04DM13 - 155 107