27 JUN 1982
04DM12 - 146 162
0374 - 2102

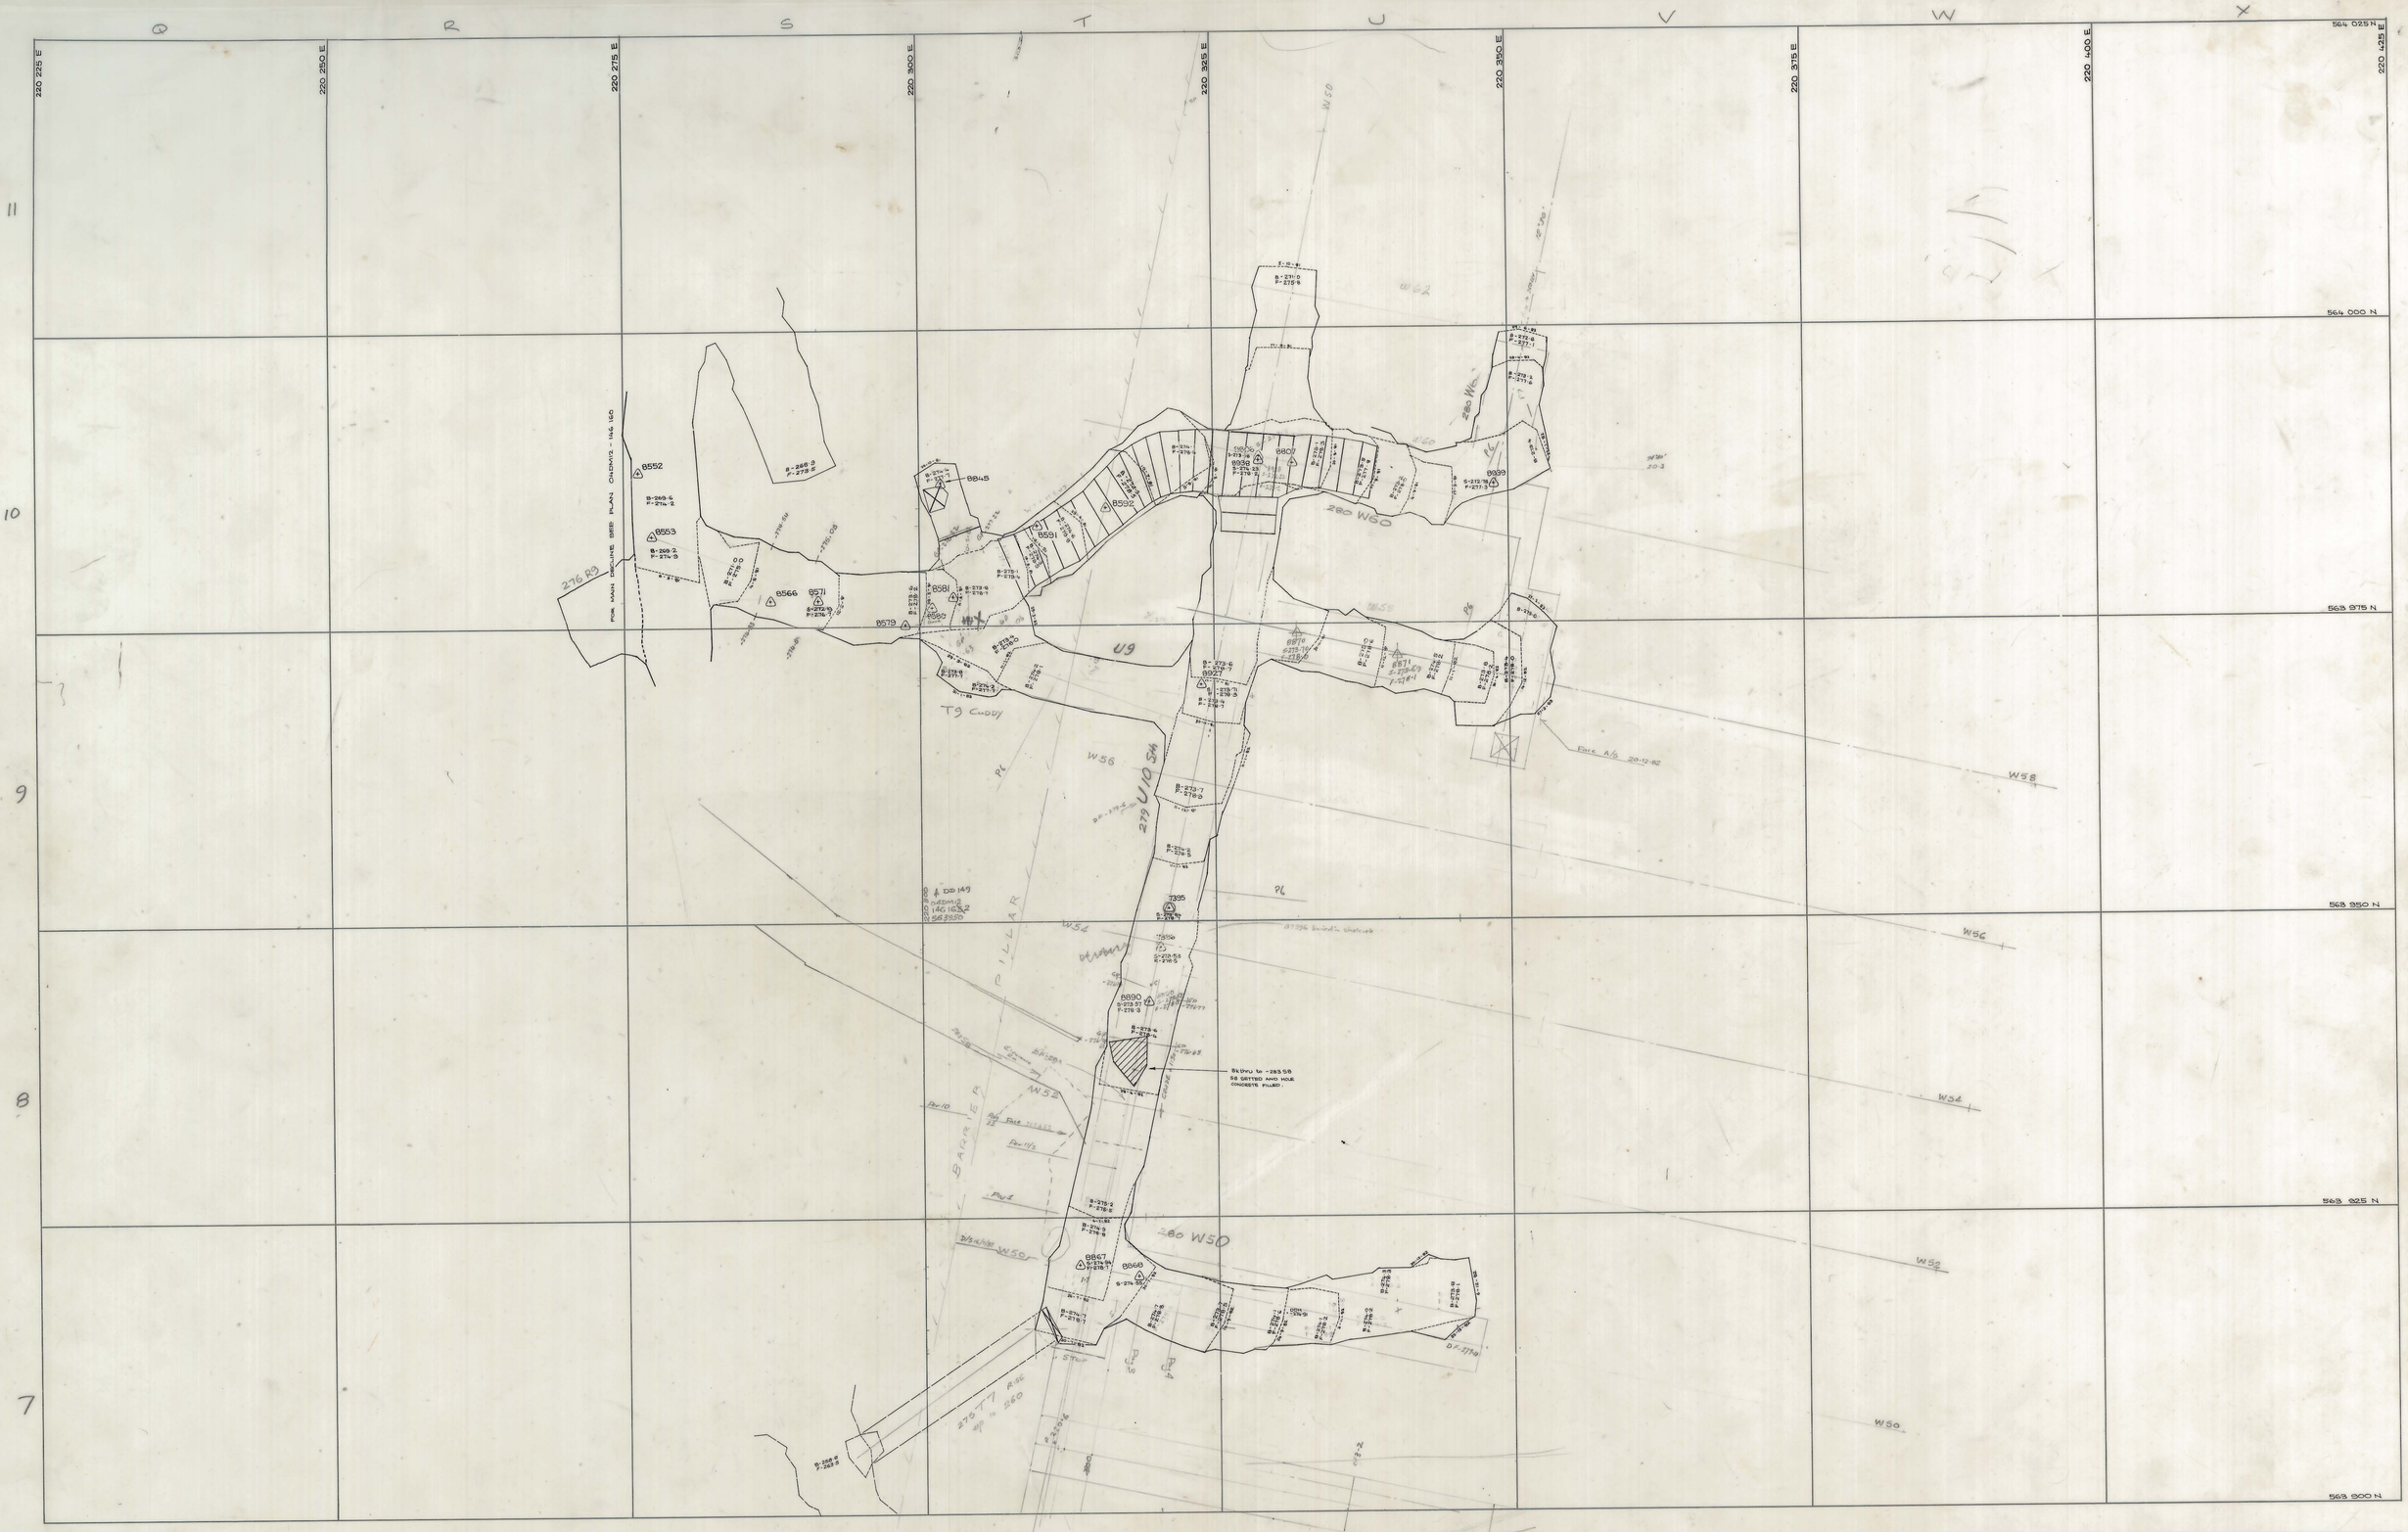

SCALE 1:250

Design plan 03DM07-1022, 03DM07-3016 redesign 03DM08-3023
Dole Shaft DD149

north

LOCATION
DOLPHIN MINE

SUBJECT
LOWER WEDGE DEVELOPMENT
- 280 m LEVEL

KING ISLAND SCHEELITE
A DIVISION OF WARMAN INTERNATIONAL

GRASSY KING ISLAND

PLAN NUMBER
04DM12 - 146 162